


Starting at a point at intersection of Mill Creek bridge and Mill Creek, East 850 ft. along State Highway Route #515 for a distance of 300 ft. Second mining to be done.

State Highway Route No. 515

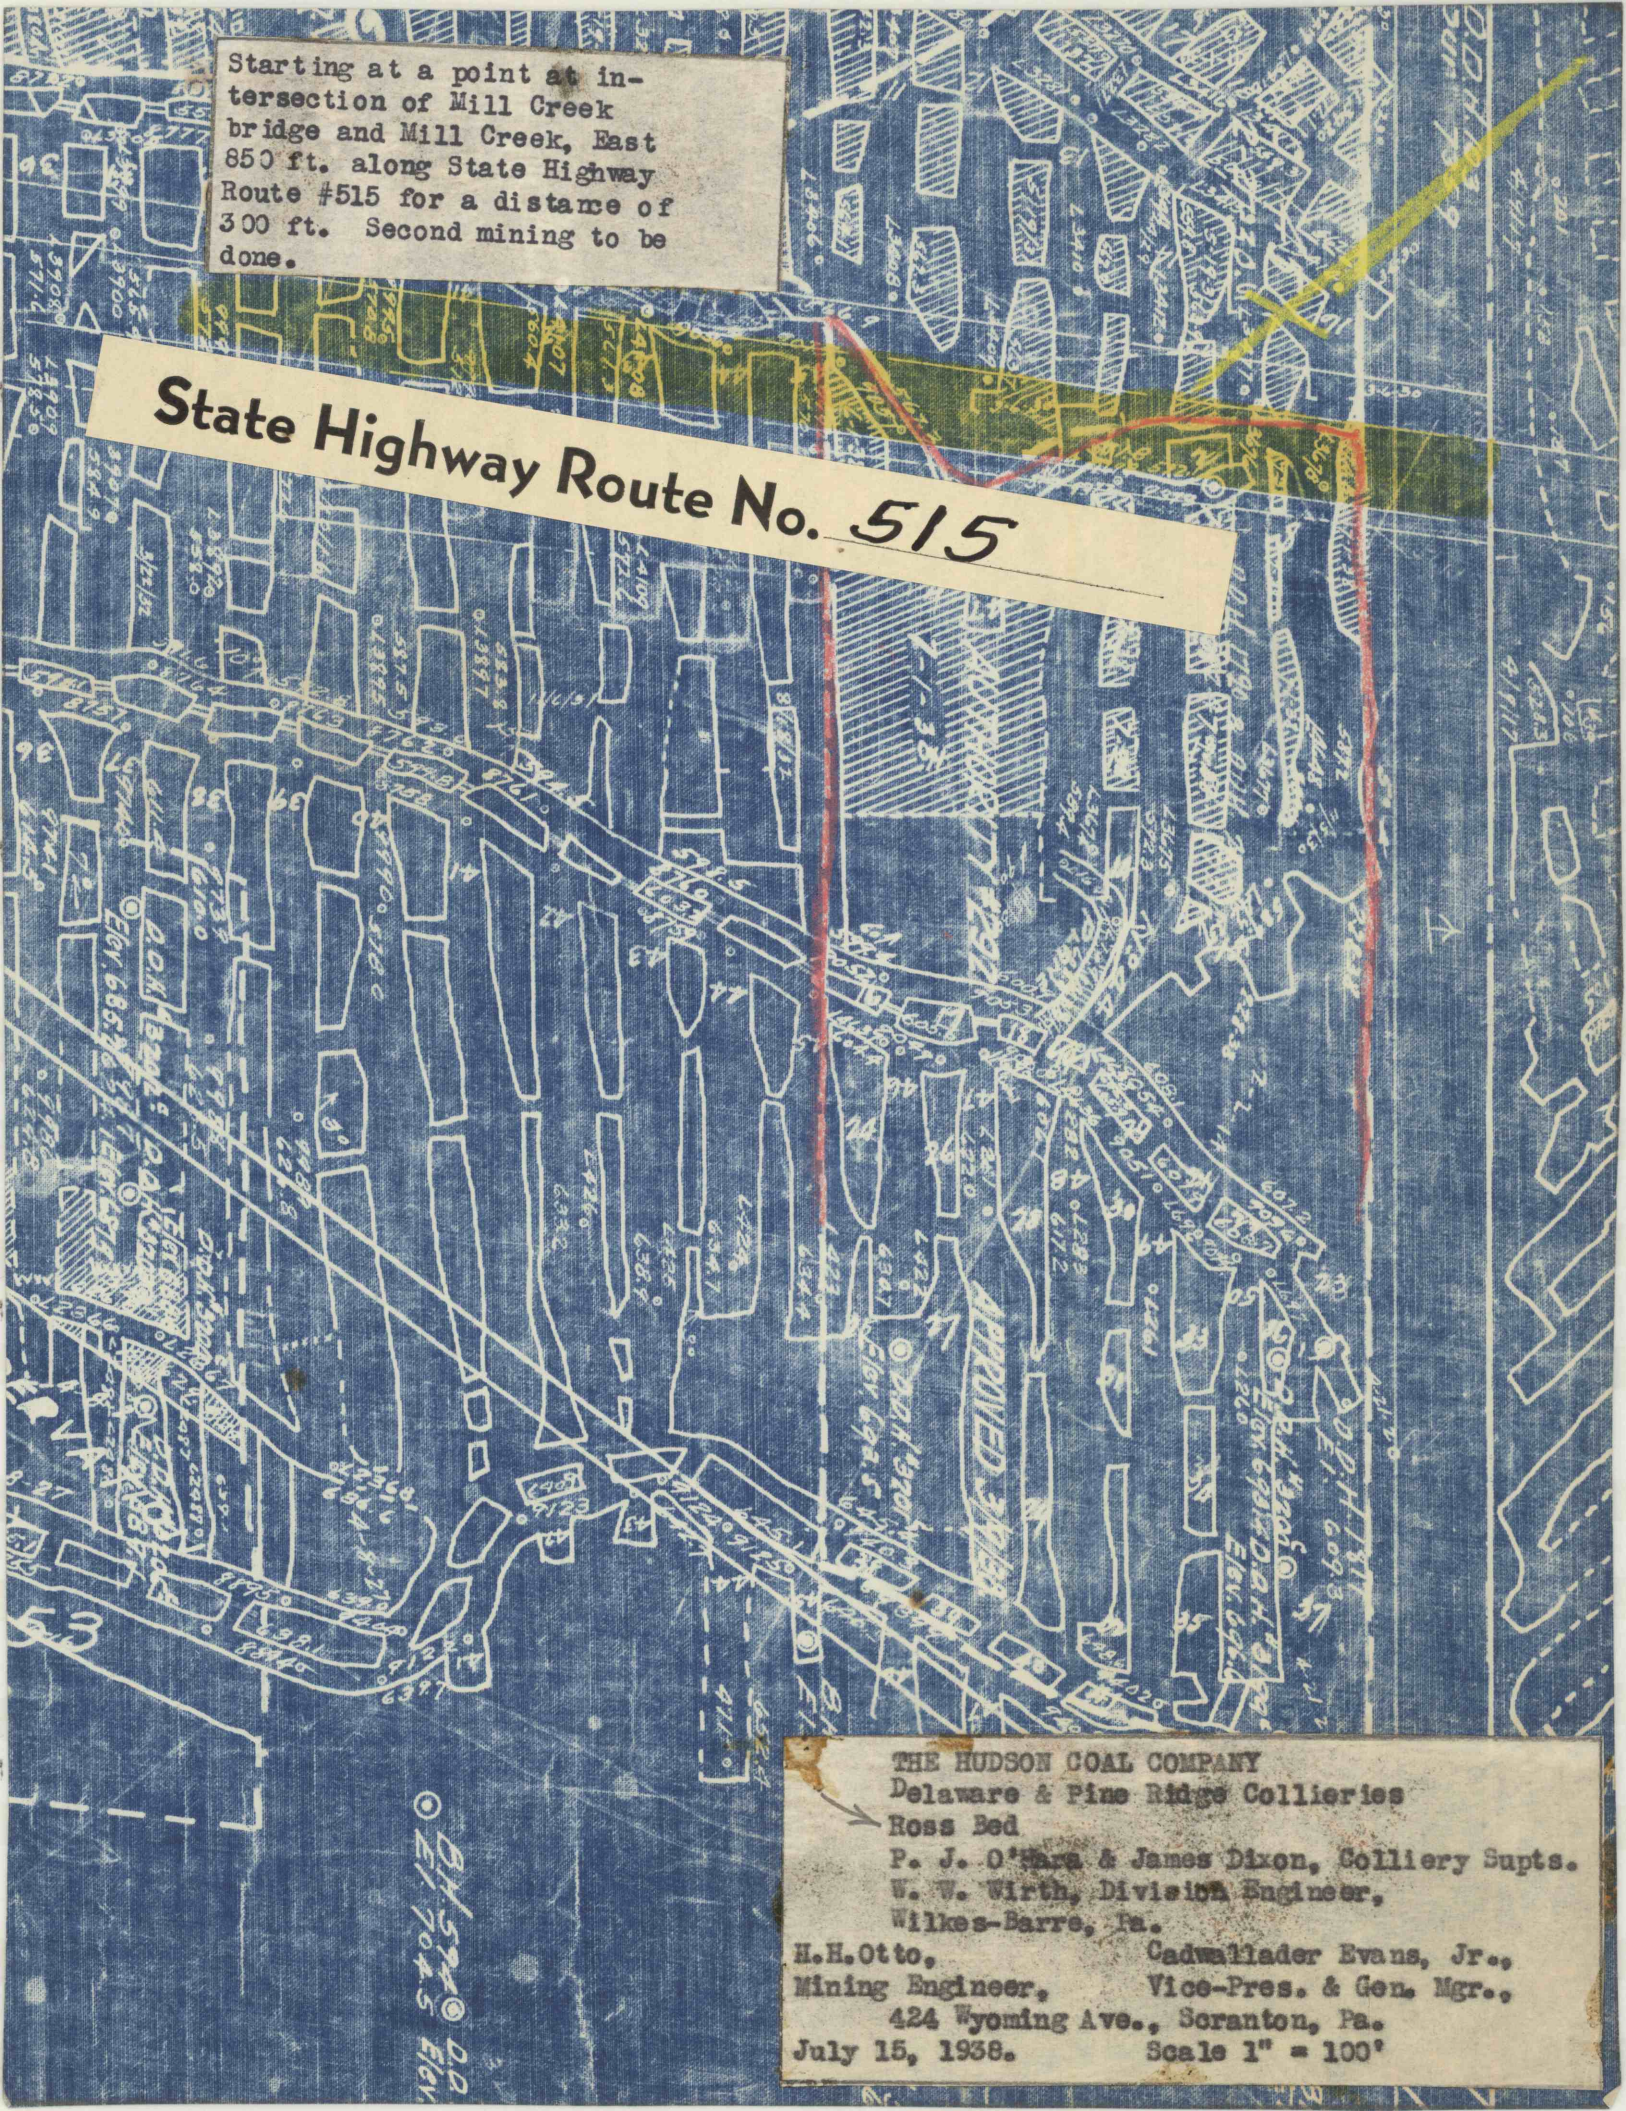

THE HUDSON COAL COMPANY  
Delaware & Pine Ridge Collieries  
Ross Bed  
P. J. O'Shara & James Dixon, Colliery Supts.  
W. W. Wirth, Division Engineer,  
Wilkes-Barre, Pa.

H.H. Otto, Mining Engineer,  
424 Wyoming Ave., Scranton, Pa.  
July 15, 1938.

Cadwallader Evans, Jr.,  
Vice-Pres. & Gen. Mgr.,  
Scale 1" = 100'

21-574-00  
21-704-5 Elev