


Starting at a point at intersection of Mill Creek bridge and Mill Creek, East 500 ft. along State Highway Route #515 for a distance of 250 ft. First mining to be done.

State Highway Route No. 515

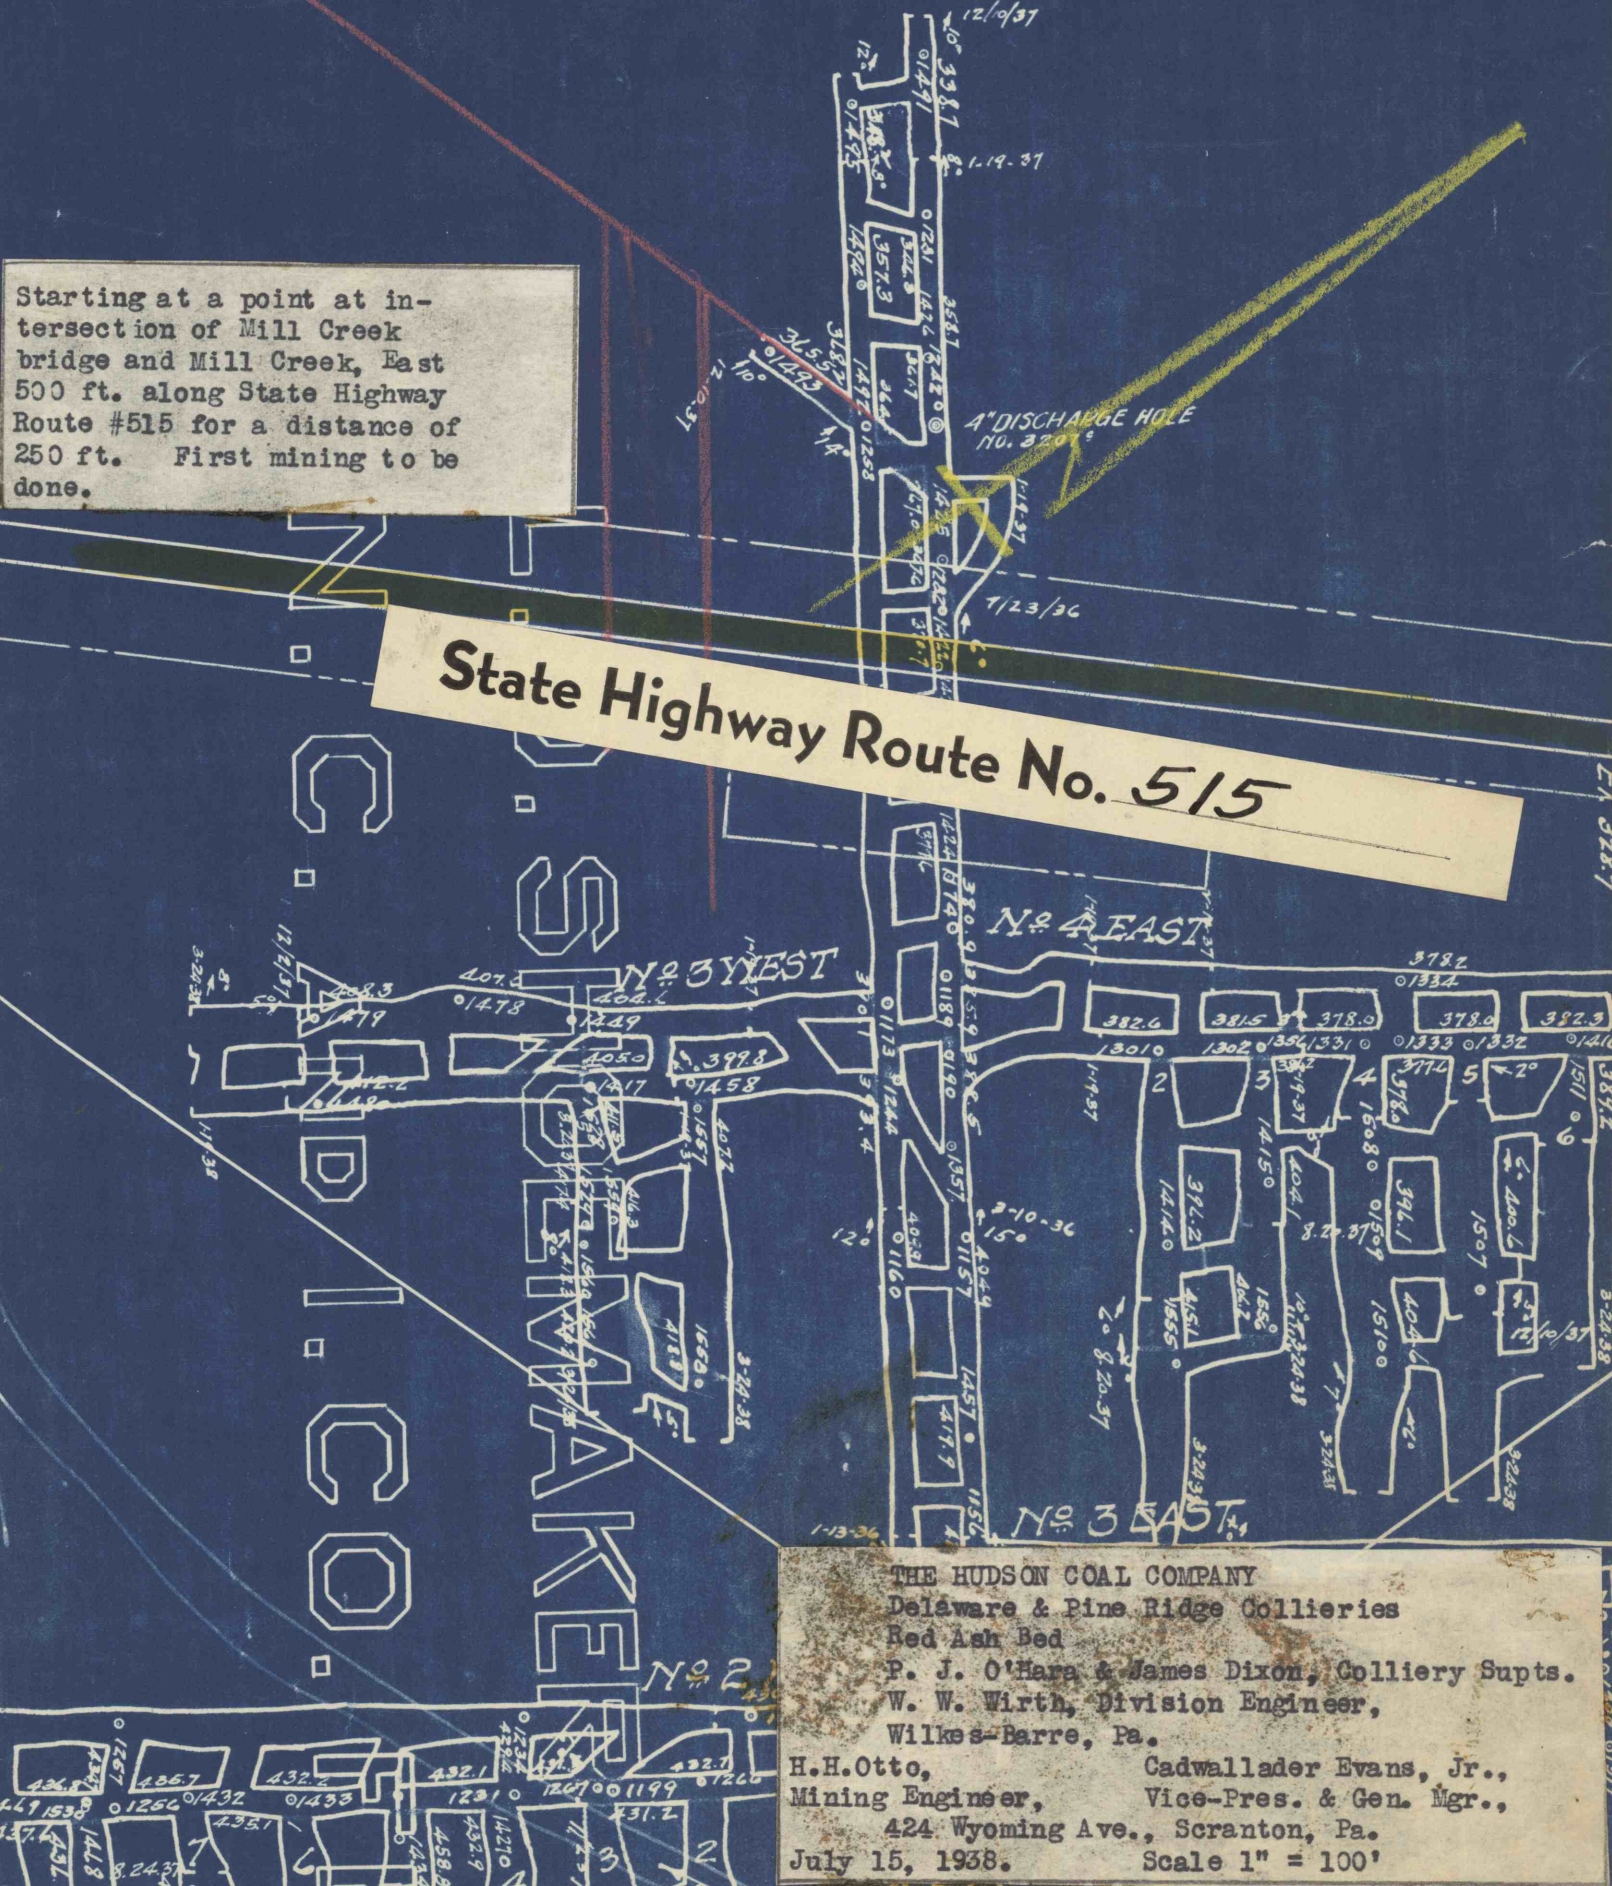

THE HUDSON COAL COMPANY
 Delaware & Pine Ridge Collieries
 Red Ash Bed
 P. J. O'Hara & James Dixon, Colliery Supts.
 W. W. Wirth, Division Engineer,
 Wilkes-Barre, Pa.

H.H.Otto, Mining Engineer,
 424 Wyoming Ave., Scranton, Pa.
 July 15, 1938.

Cadwallader Evans, Jr.,
 Vice-Pres. & Gen. Mgr.,
 424 Wyoming Ave., Scranton, Pa.
 Scale 1" = 100'