


State Highway Route No. 515

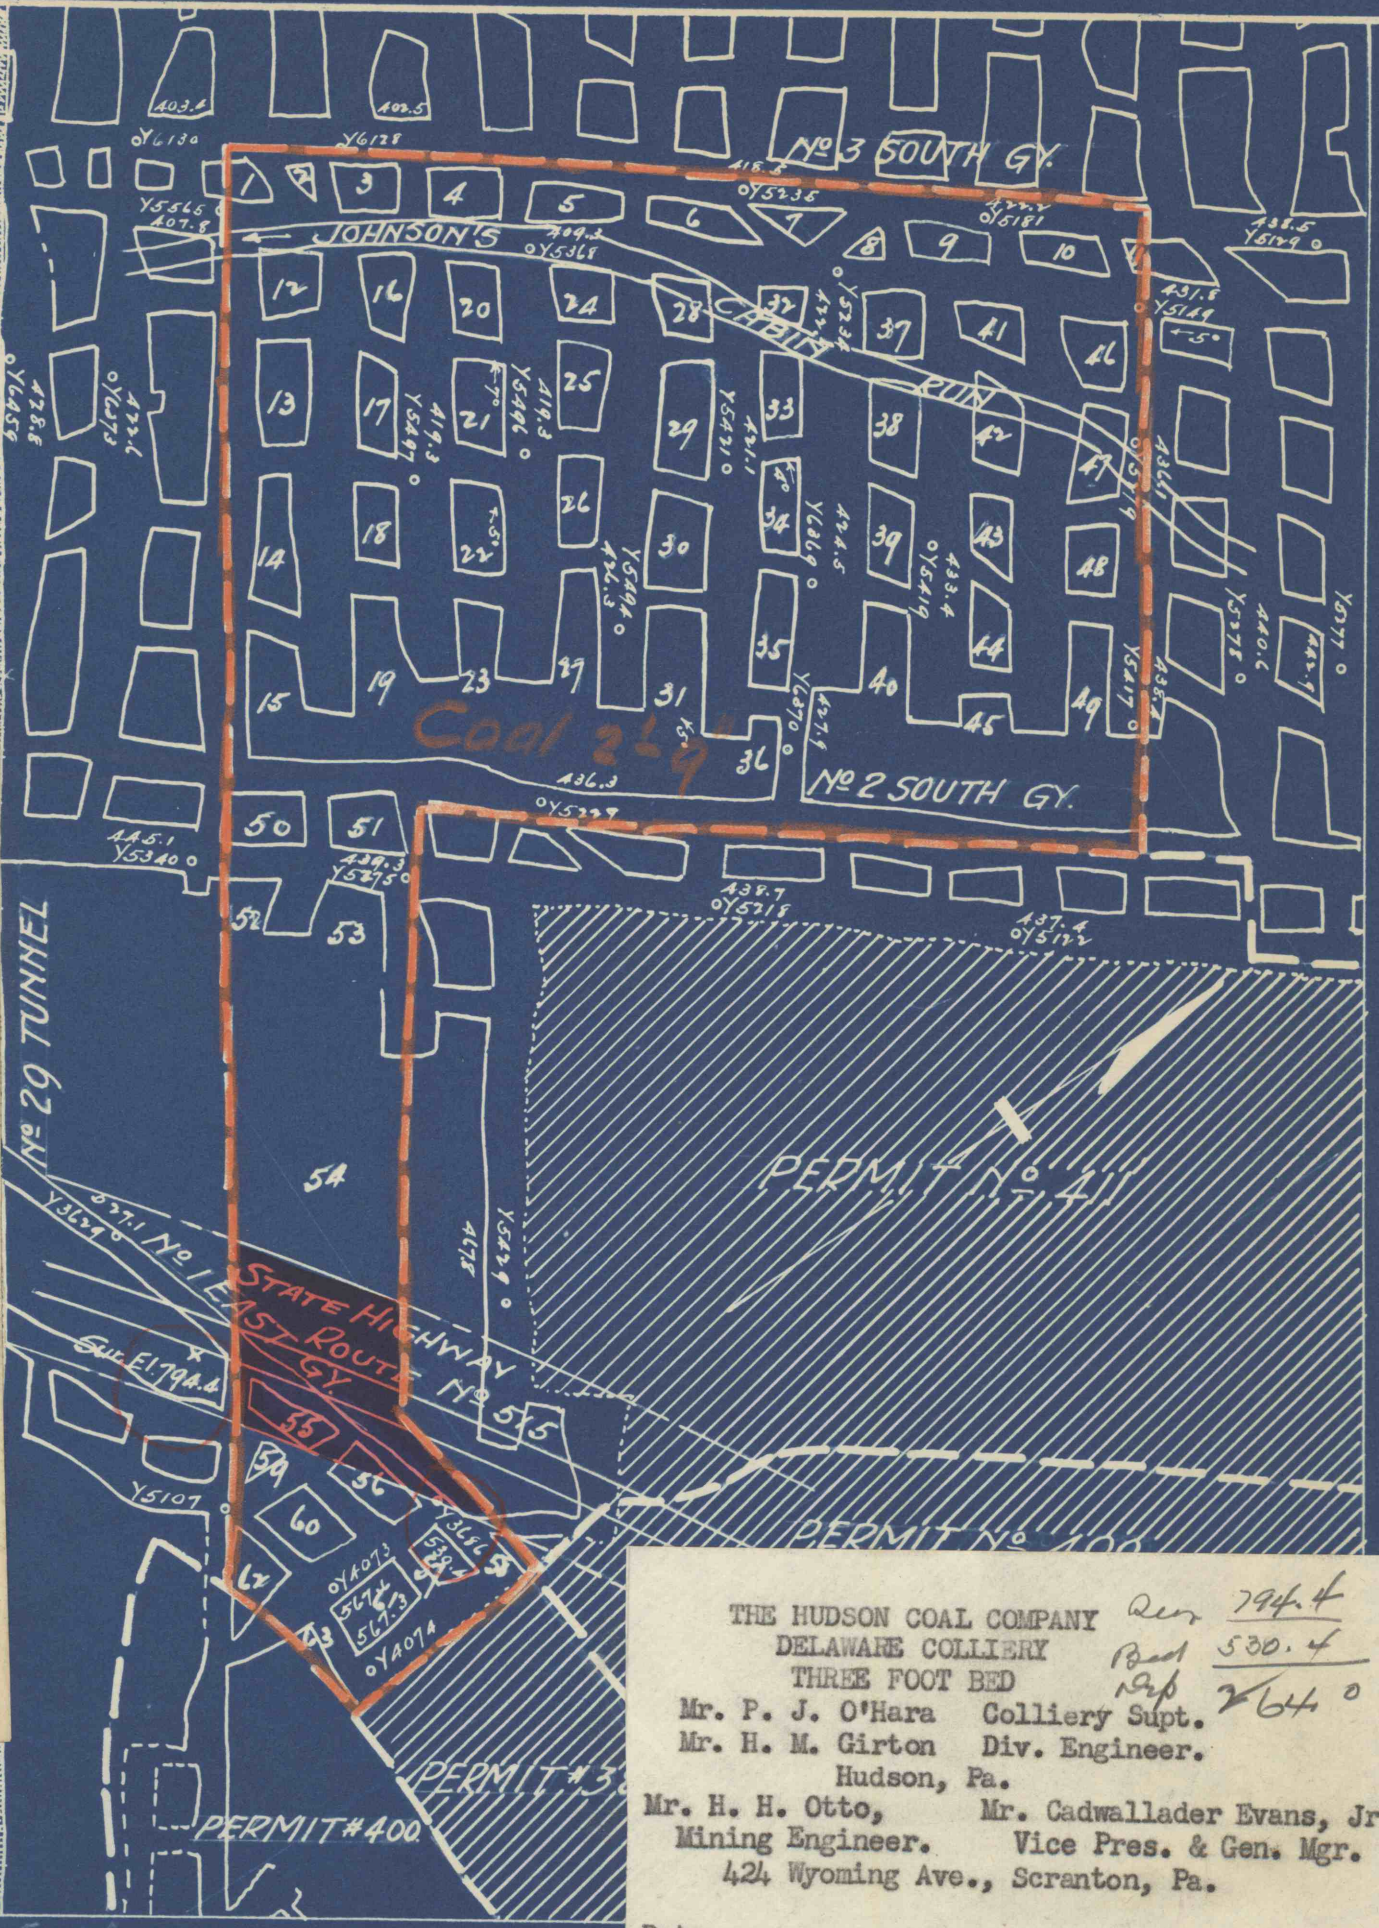

THE HUDSON COAL COMPANY Rev 794.4
 DELAWARE COLLIERY Bal 530.4
 THREE FOOT BED Exp 264.0
 Mr. P. J. O'Hara Colliery Supt.
 Mr. H. M. Girton Div. Engineer.
 Hudson, Pa.
 Mr. H. H. Otto, Mr. Cadwallader Evans, Jr.
 Mining Engineer. Vice Pres. & Gen. Mgr.
 424 Wyoming Ave., Scranton, Pa.