


Sarg Coal Co  
Yatesville, Pa.

Sarg Coal Company  
Yatesville, Pa.

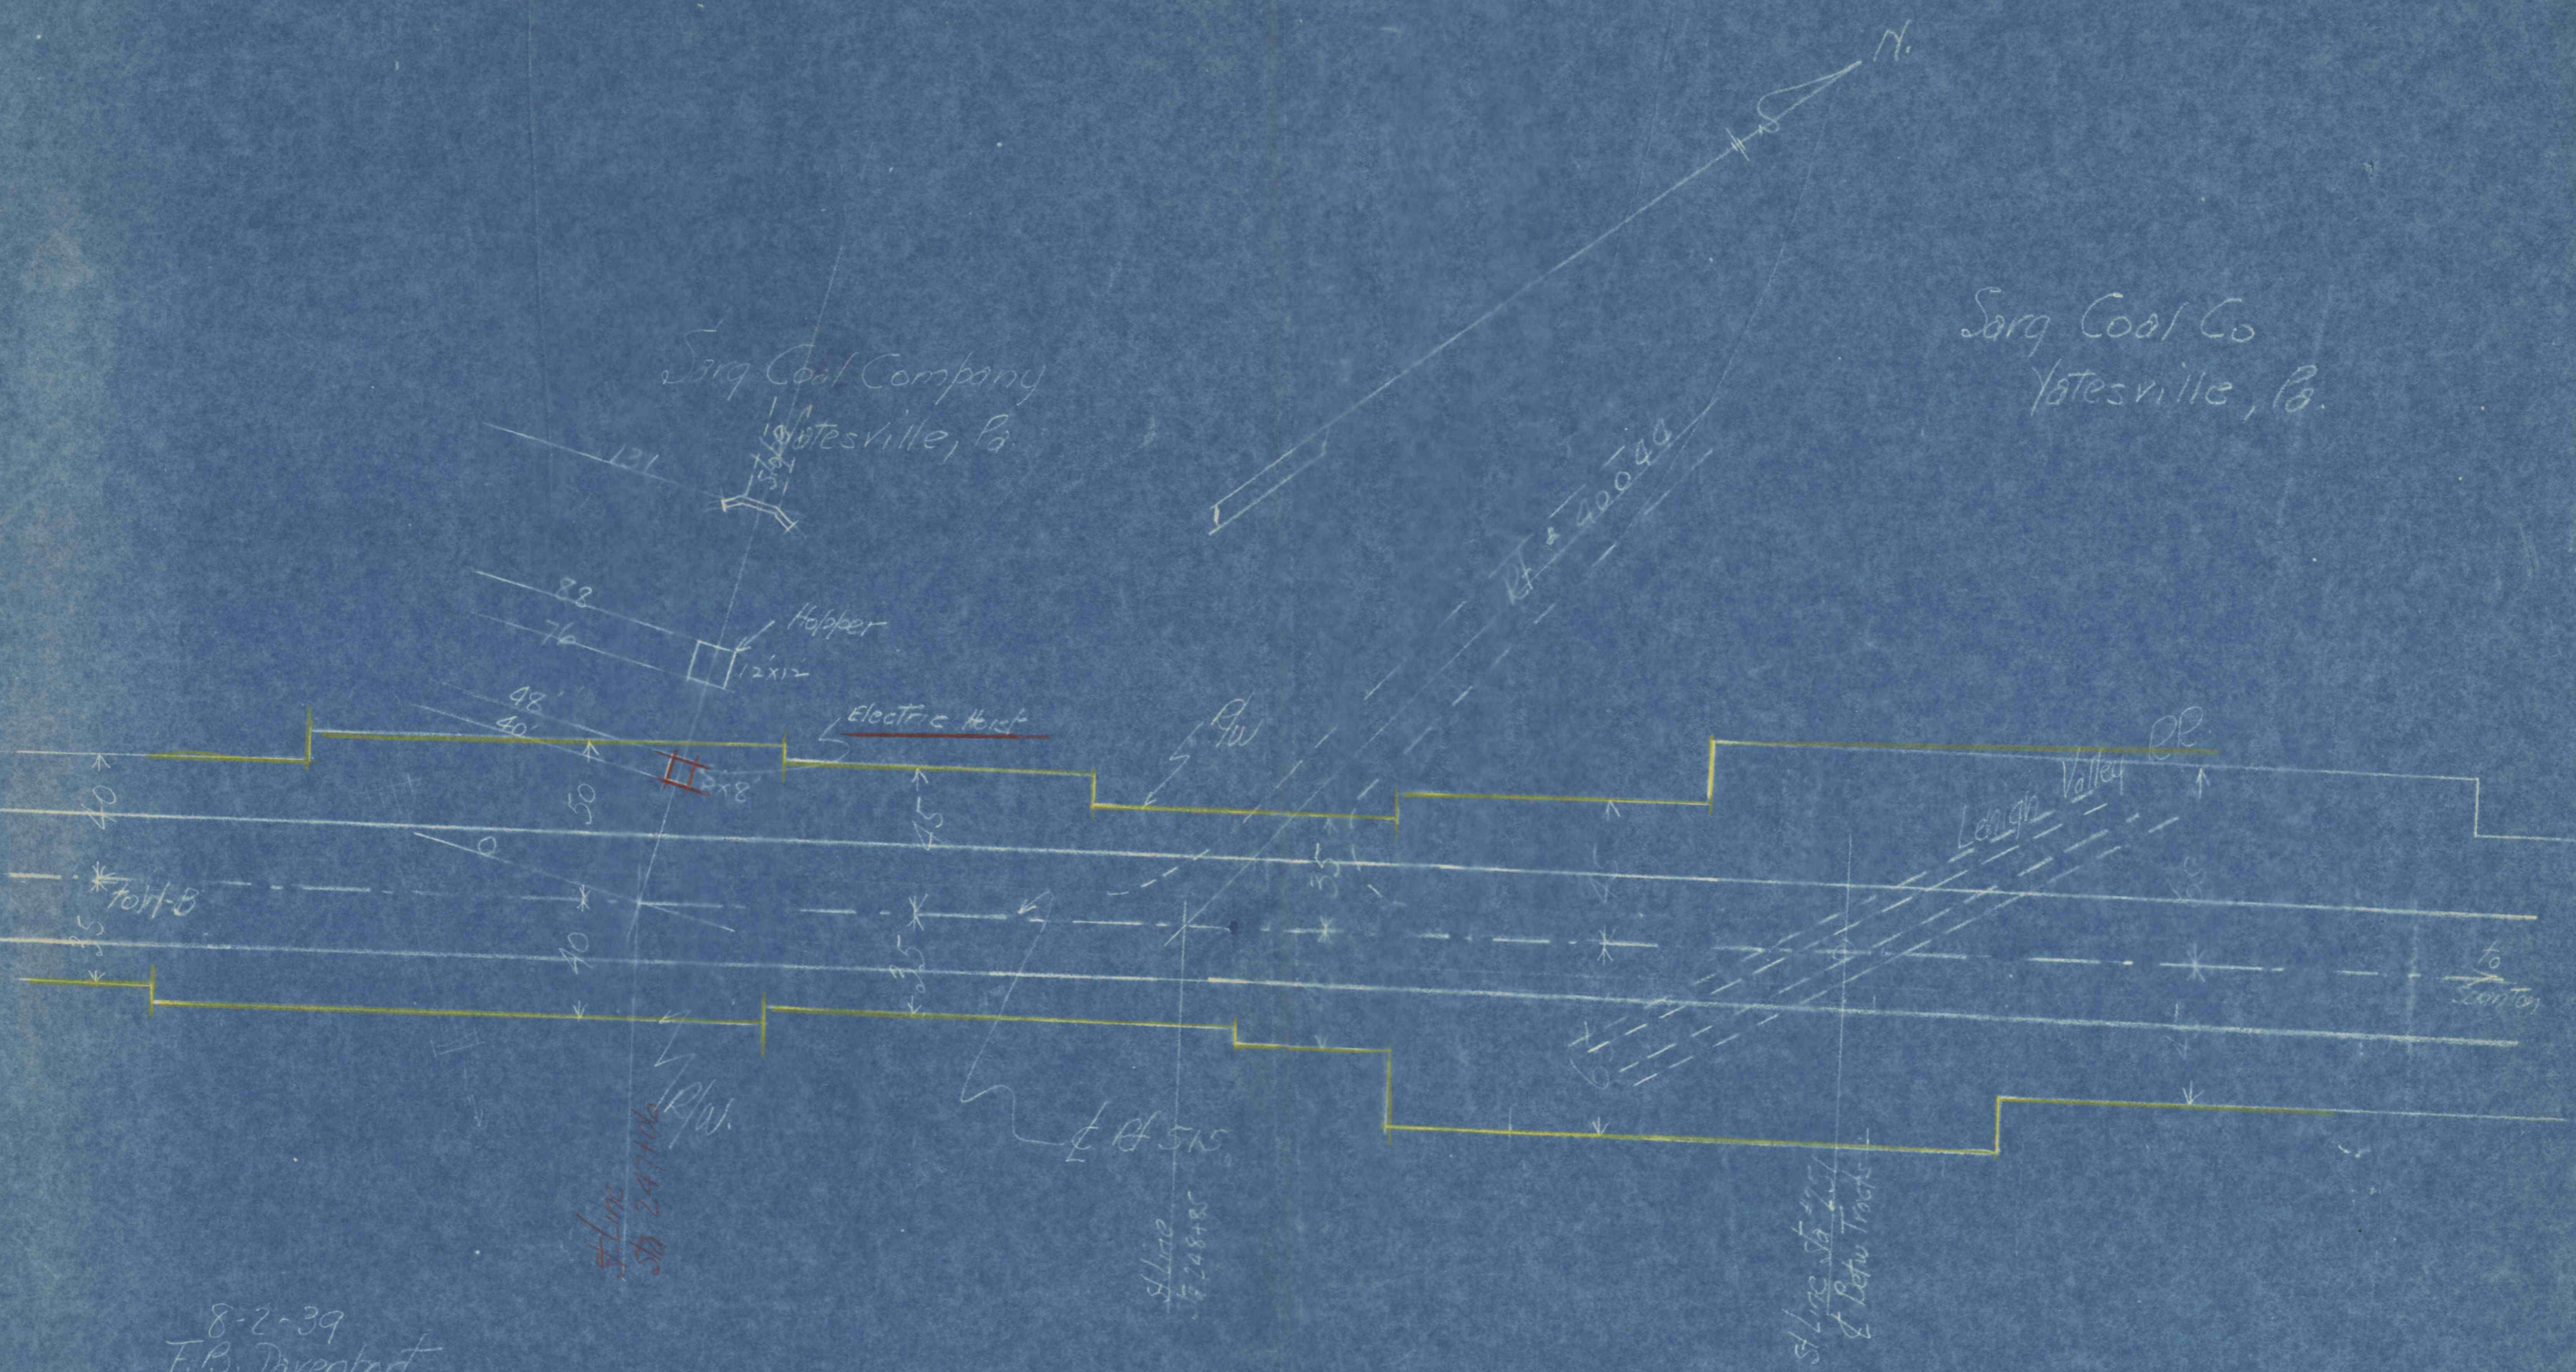

8-2-39  
F.B. Davenport  
1" = 50 ft  
# 515 - Luzerne County.

Line 247+06  
R/W

Line 248+80

Line 249+00  
& Letcher Tracks