


Sarg Coal Company  
Yatesville, Pa.

Sarg Coal Co  
Yatesville, Pa.

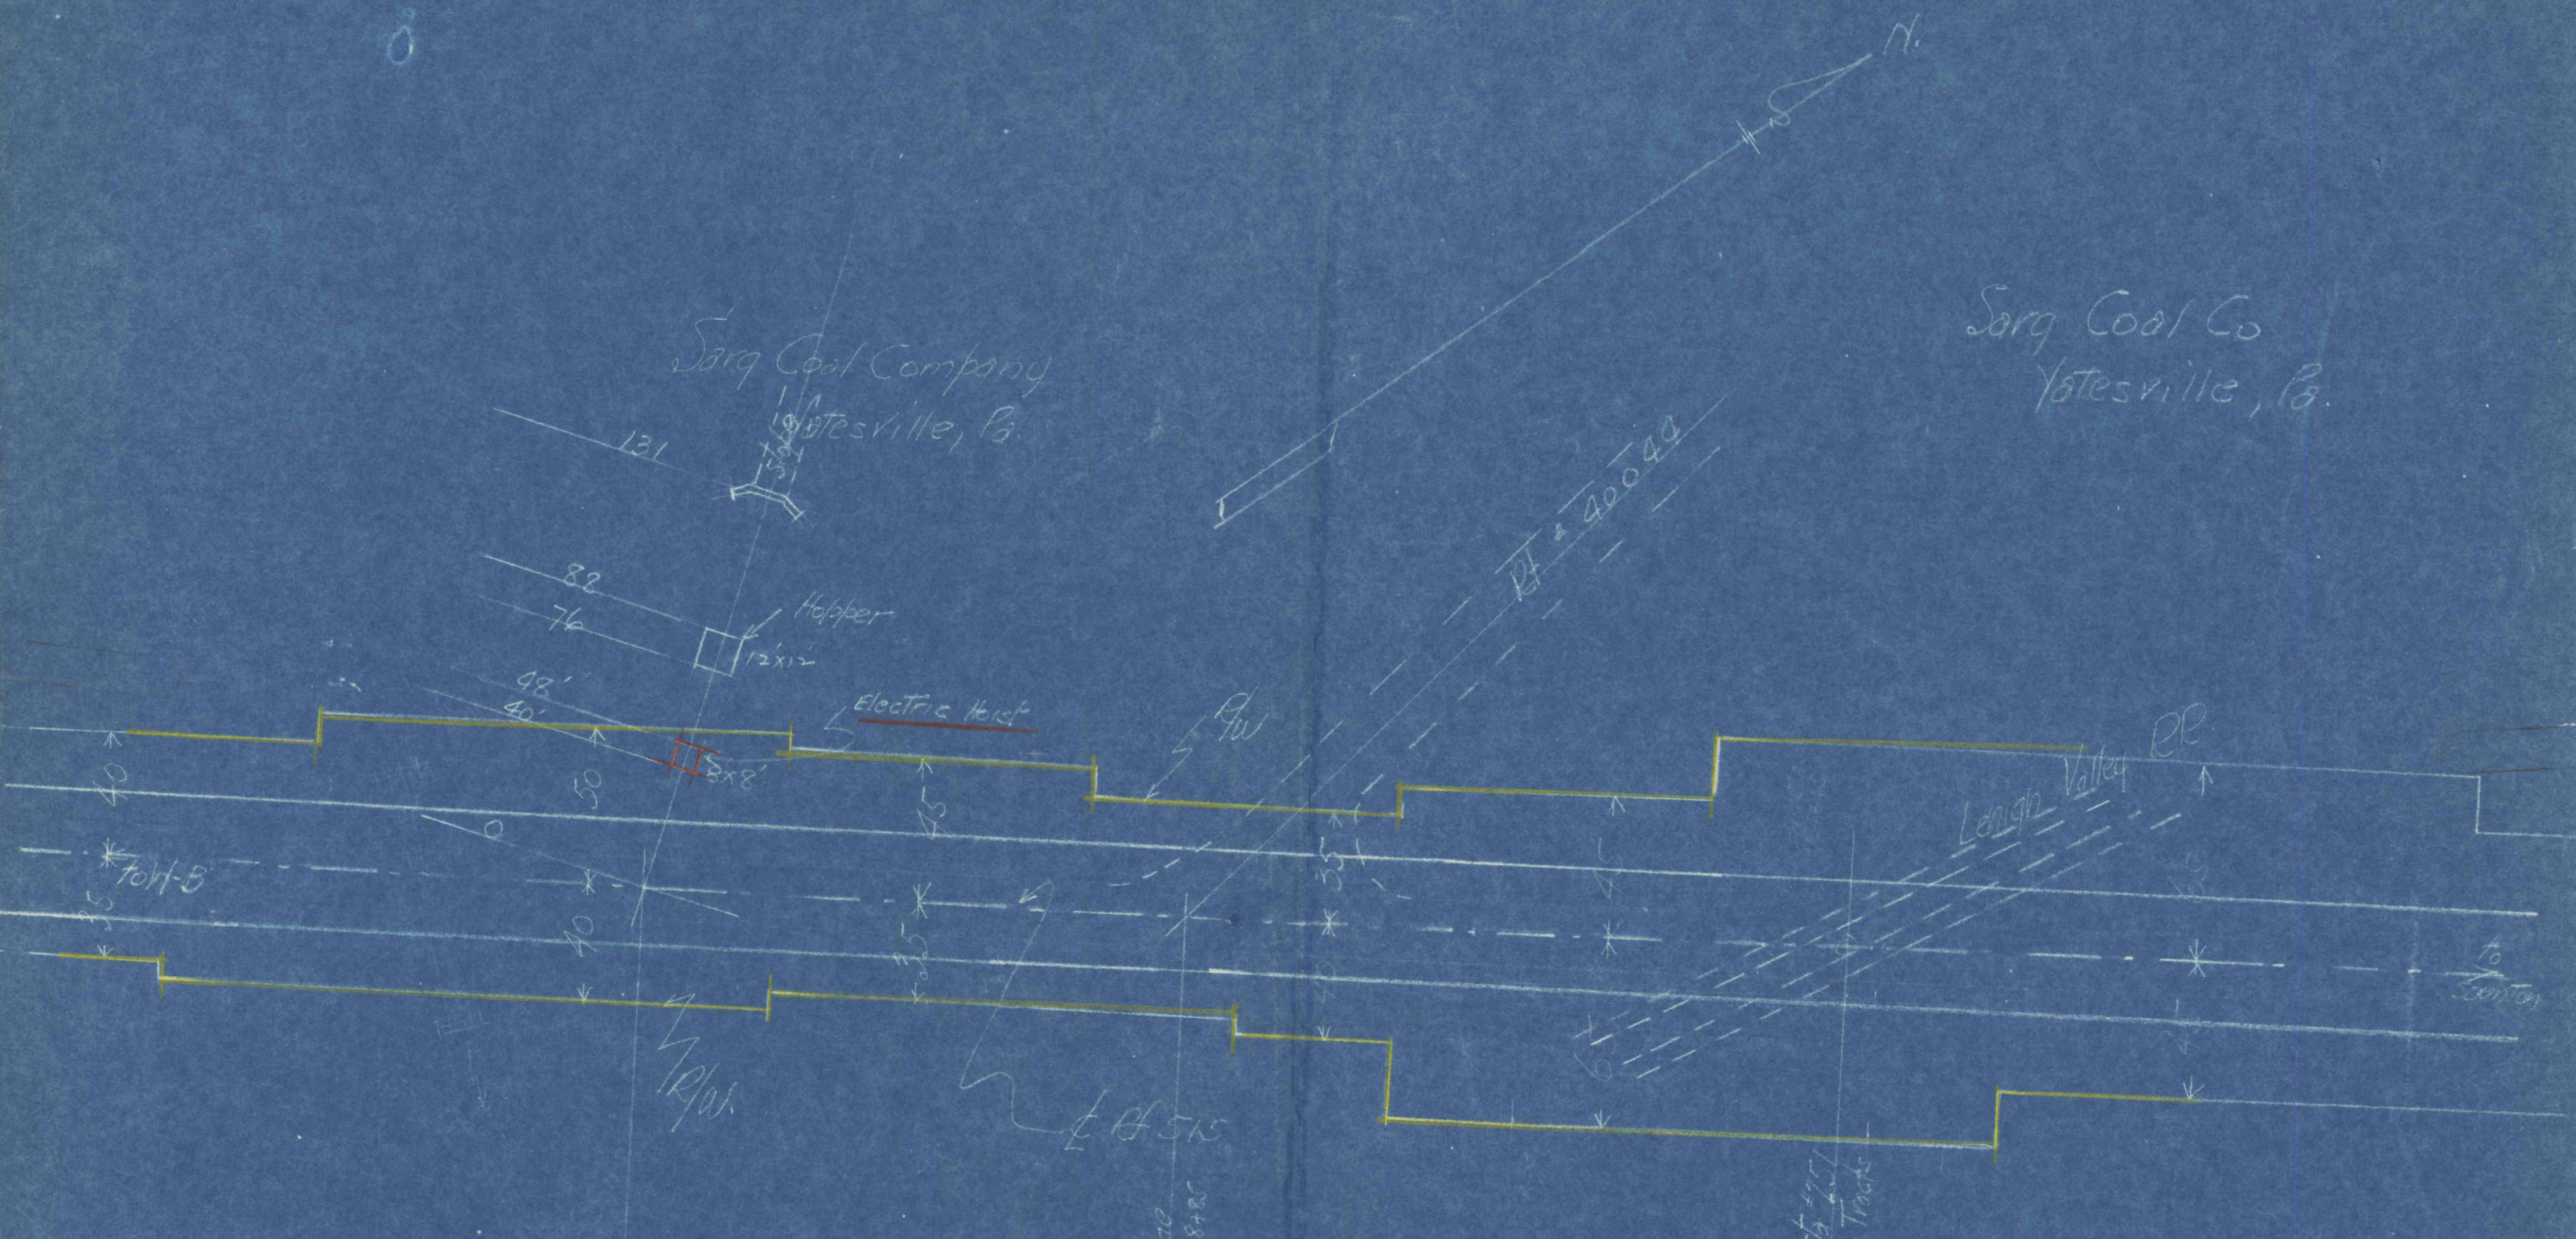

8-2-39  
F.B. Davenport  
1" = 50 ft  
R/W 515 - Luzerne County

S Line  
F 248+85

S Line to 757  
& Betw Tracts