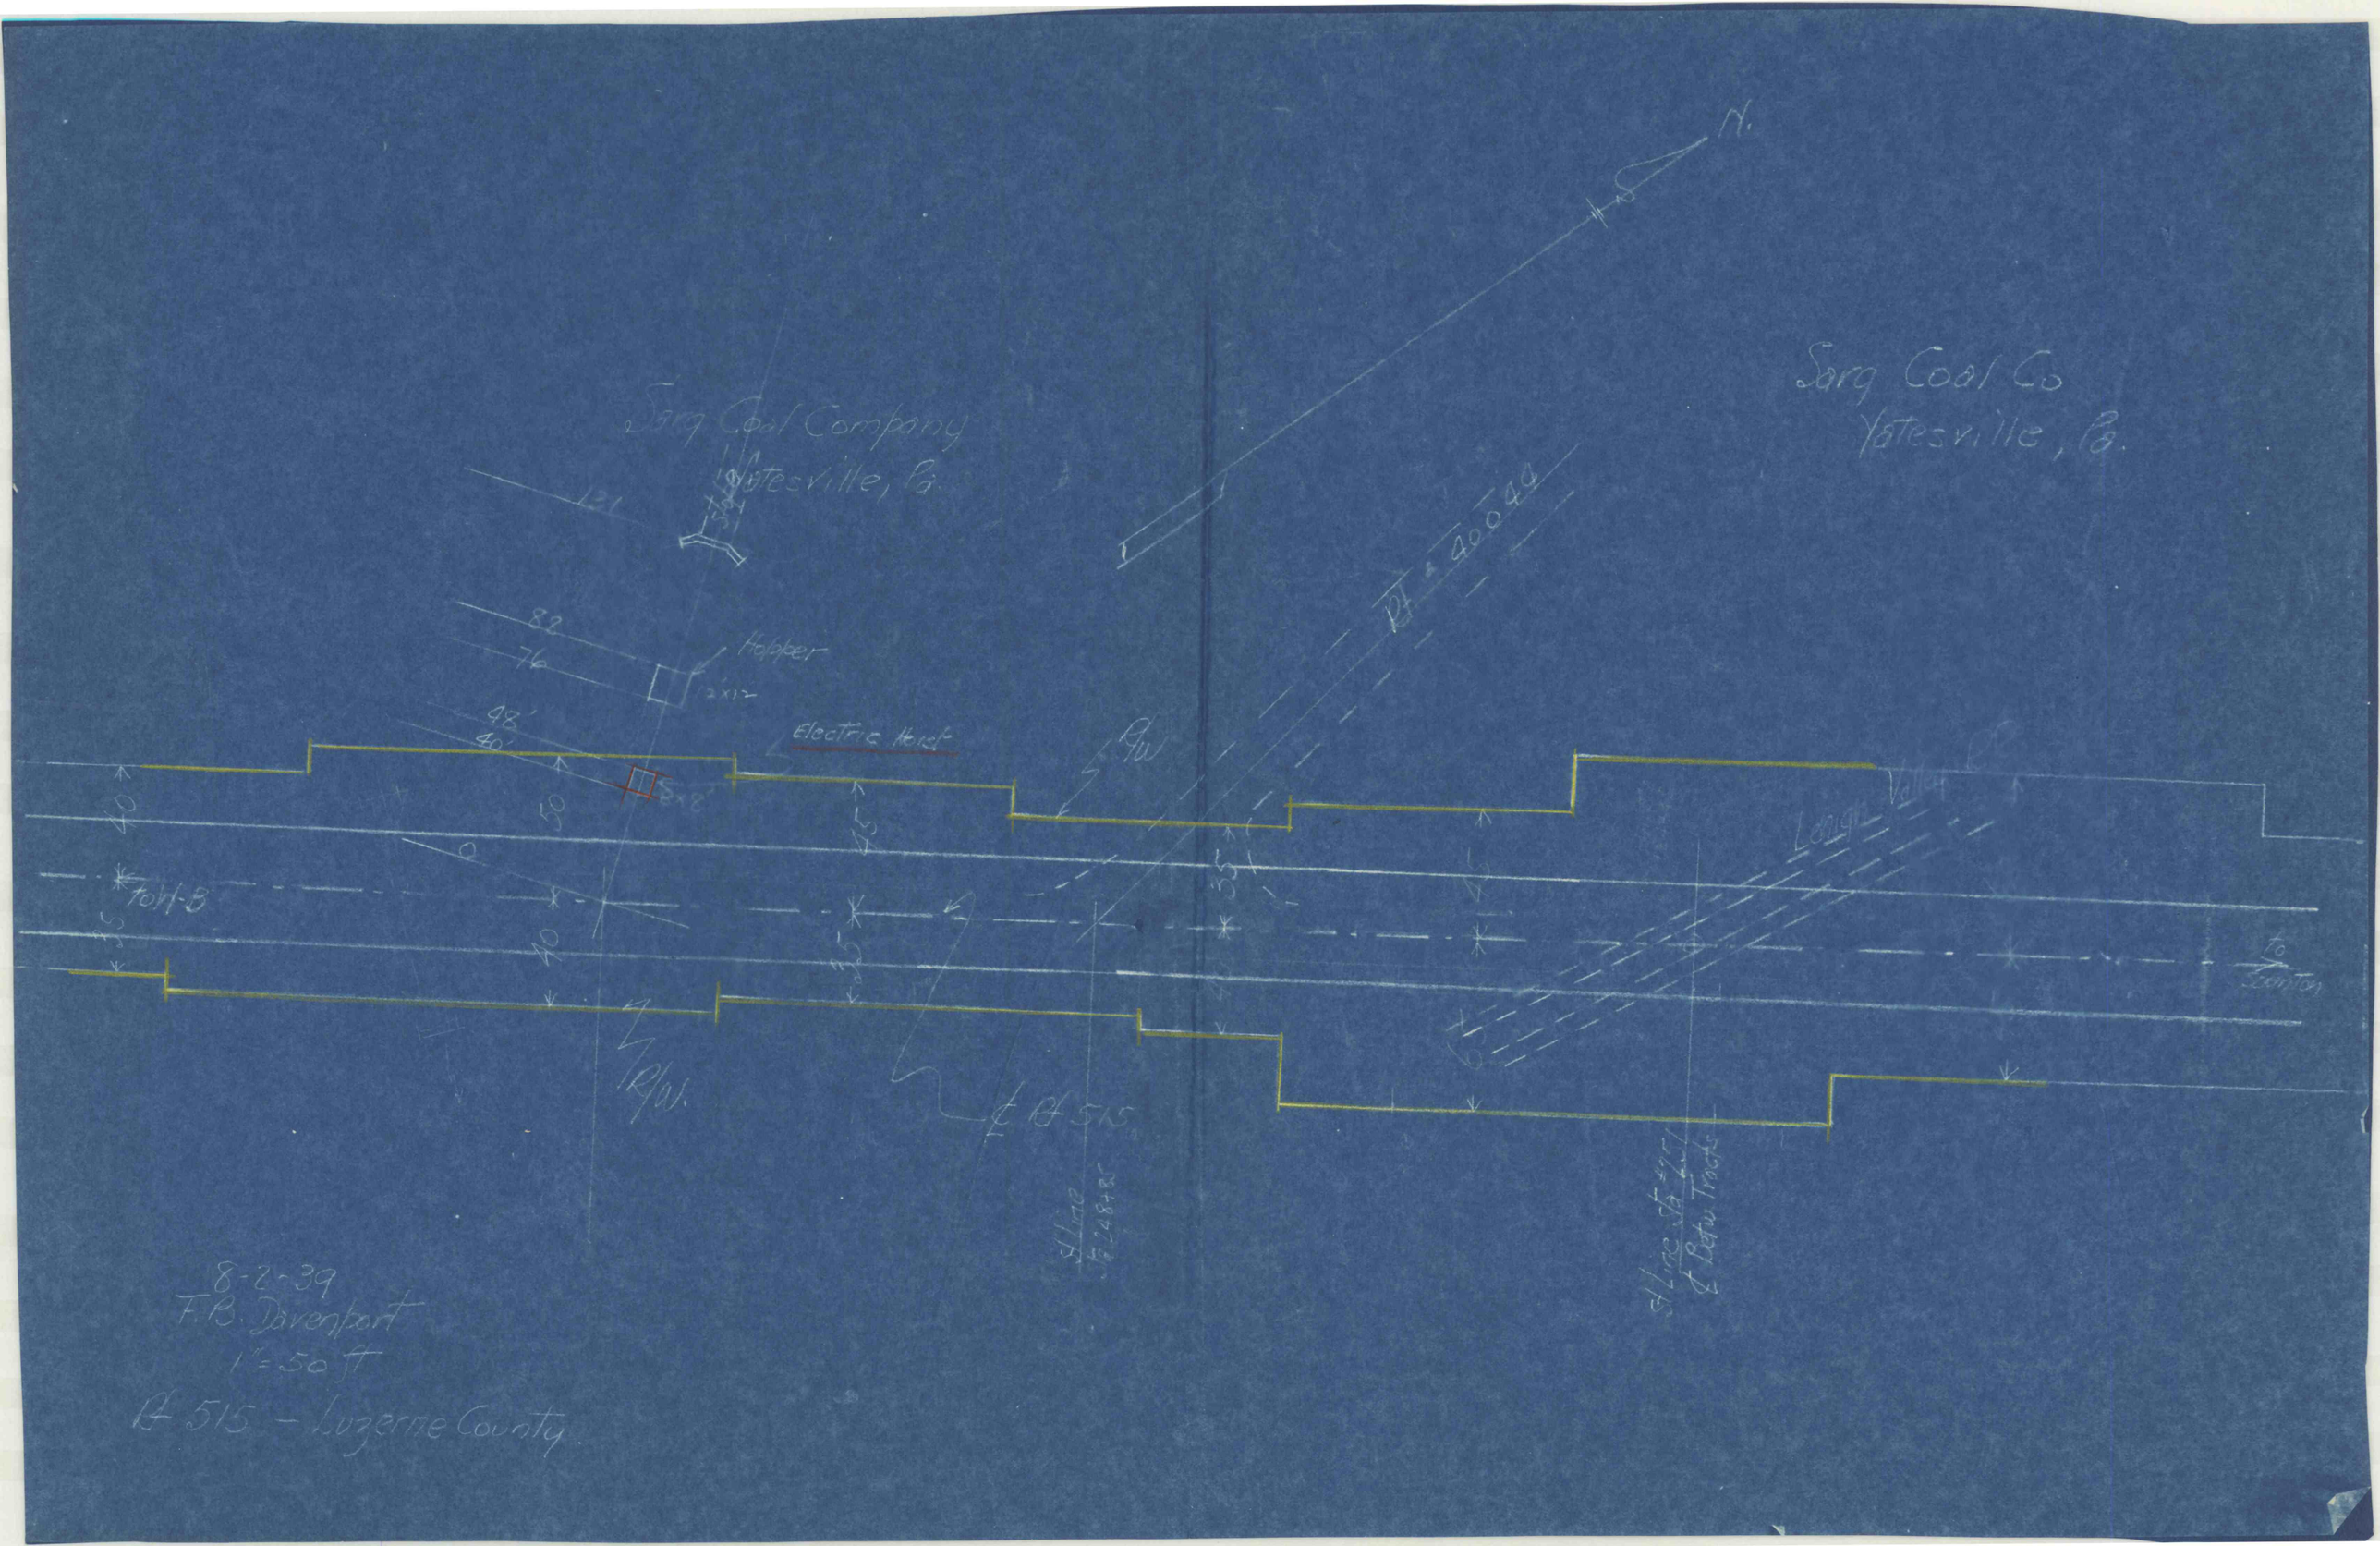

N.
Sarg Coal Company
Yatesville, Pa.
Sarg Coal Co
Yatesville, Pa.
Hopper
Electric Hoist
R/W
Lehigh Valley
to Scranton
℄ Rt 515
8-2-39
F.B. Davenport
1" = 50 ft
Rt 515 - Luzerne County