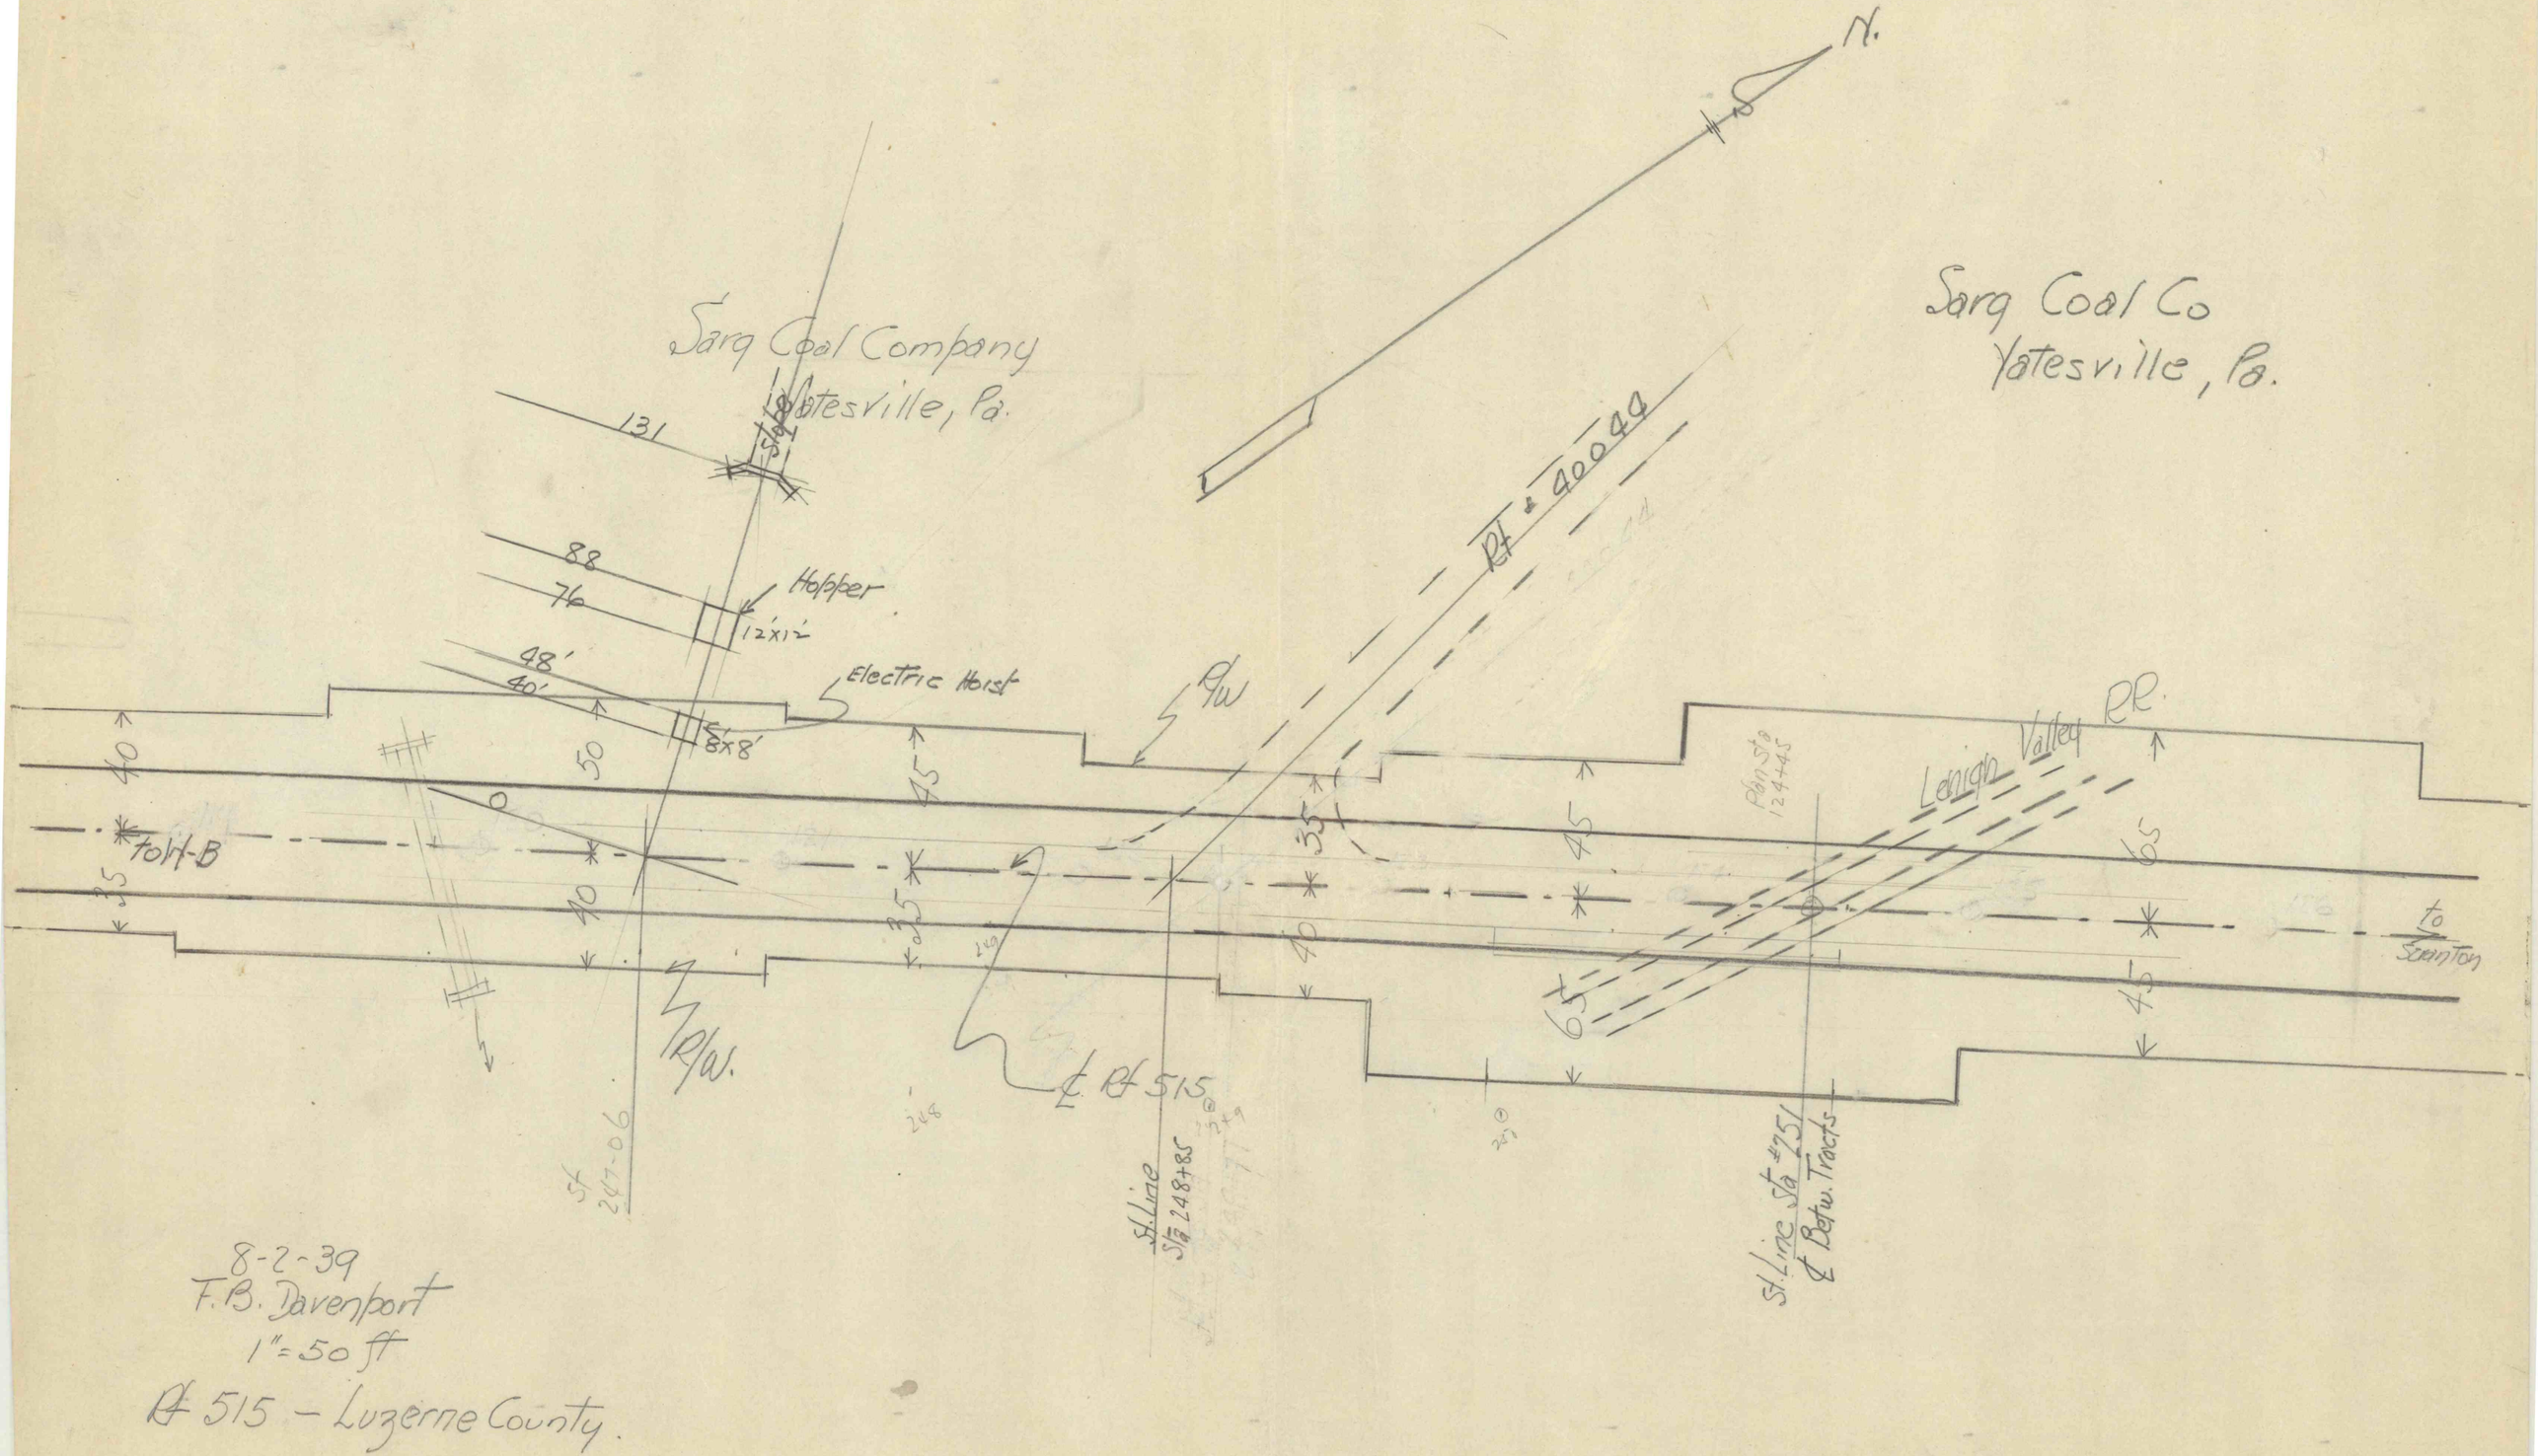

N.
Sarg Coal Company
Yatesville, Pa.
Sarg Coal Co
Yatesville, Pa.
131
88
76
48'
40'
Hopper
12'x12'
Electric Hoist
8'x8'
R/W
Rt # 40044
Lehigh Valley RR.
Plan Sta 124+45
Toll-B
to Scranton
R/W.
℄ Rt 515
St. Line Sta 248+85
St. Line Sta #251 ℄ Betw. Tracts
St 247-06
8-2-39
F.B. Davenport
1" = 50 ft
Rt 515 – Luzerne County.