


SECTION A - B

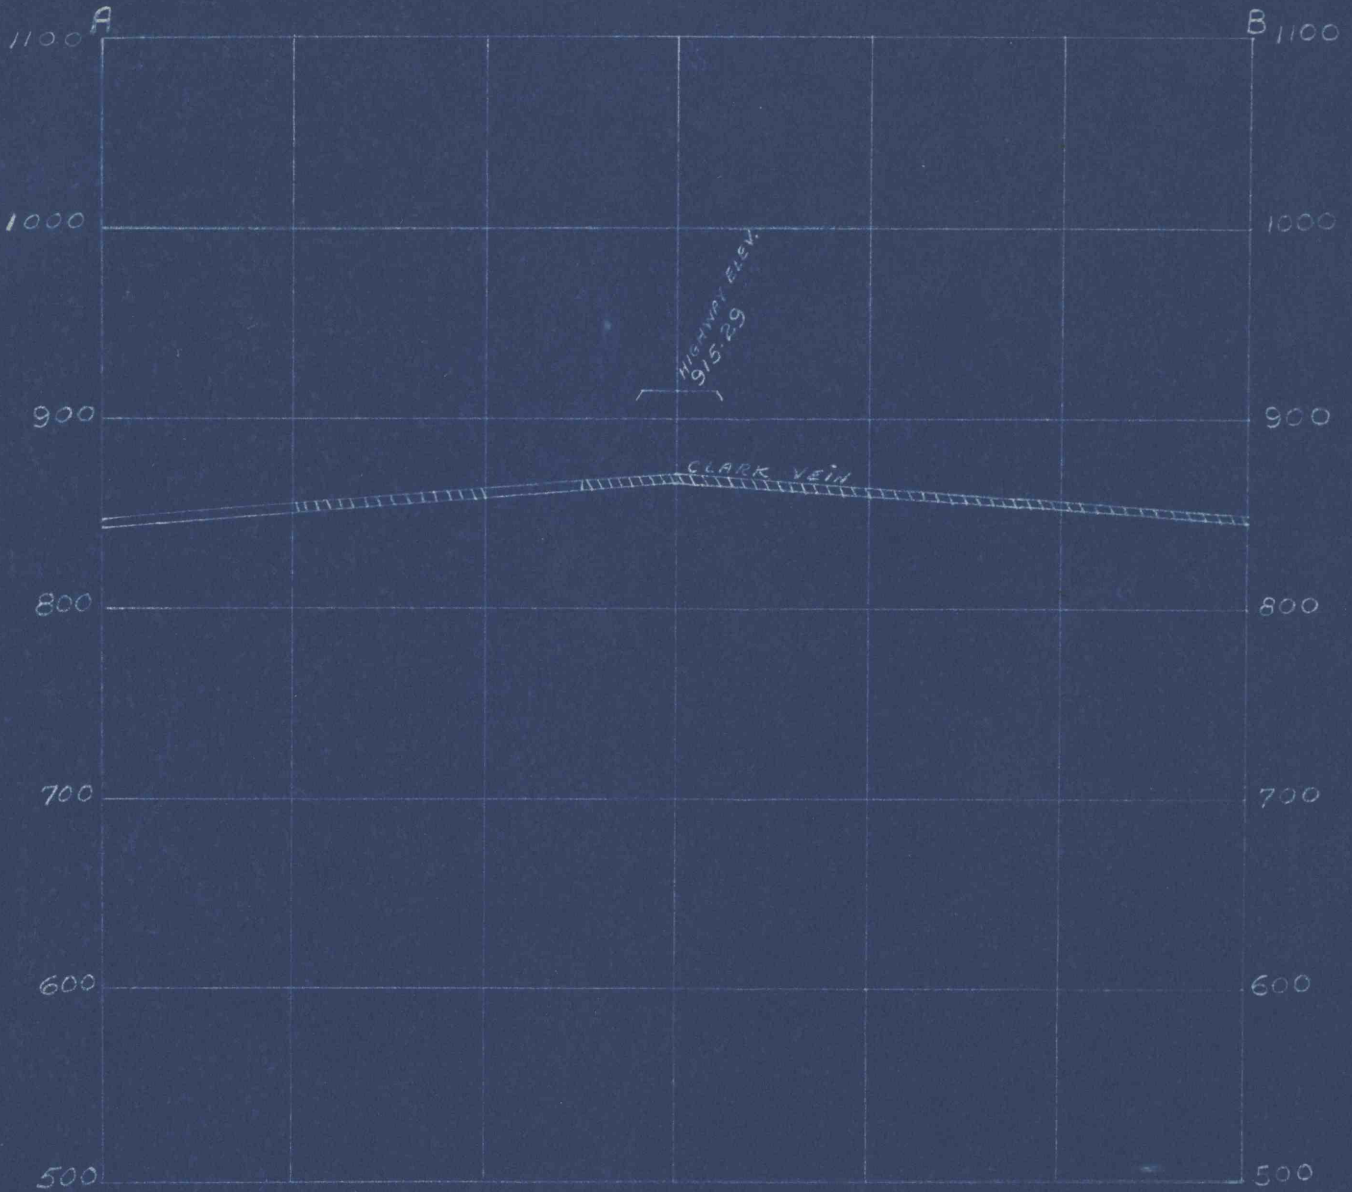

2<sup>nd</sup> mining within 100ft of center  
line of highway between stations  
283+30 and 289+55

2

BUTLER COLLIERY  
Nardone Slope ---- Clark Vein  
Scale 1" = 100'

Cross section of Clark Vein  
underlying Leg. Route #515 in  
Jenkins Township, Luzerne  
County, Pa.

▬ First mining  
▨ Complete mining