


BUTLER COLLIERIES
SARF COAL CO.
CLARK VEIN
SCALE 1"=100'

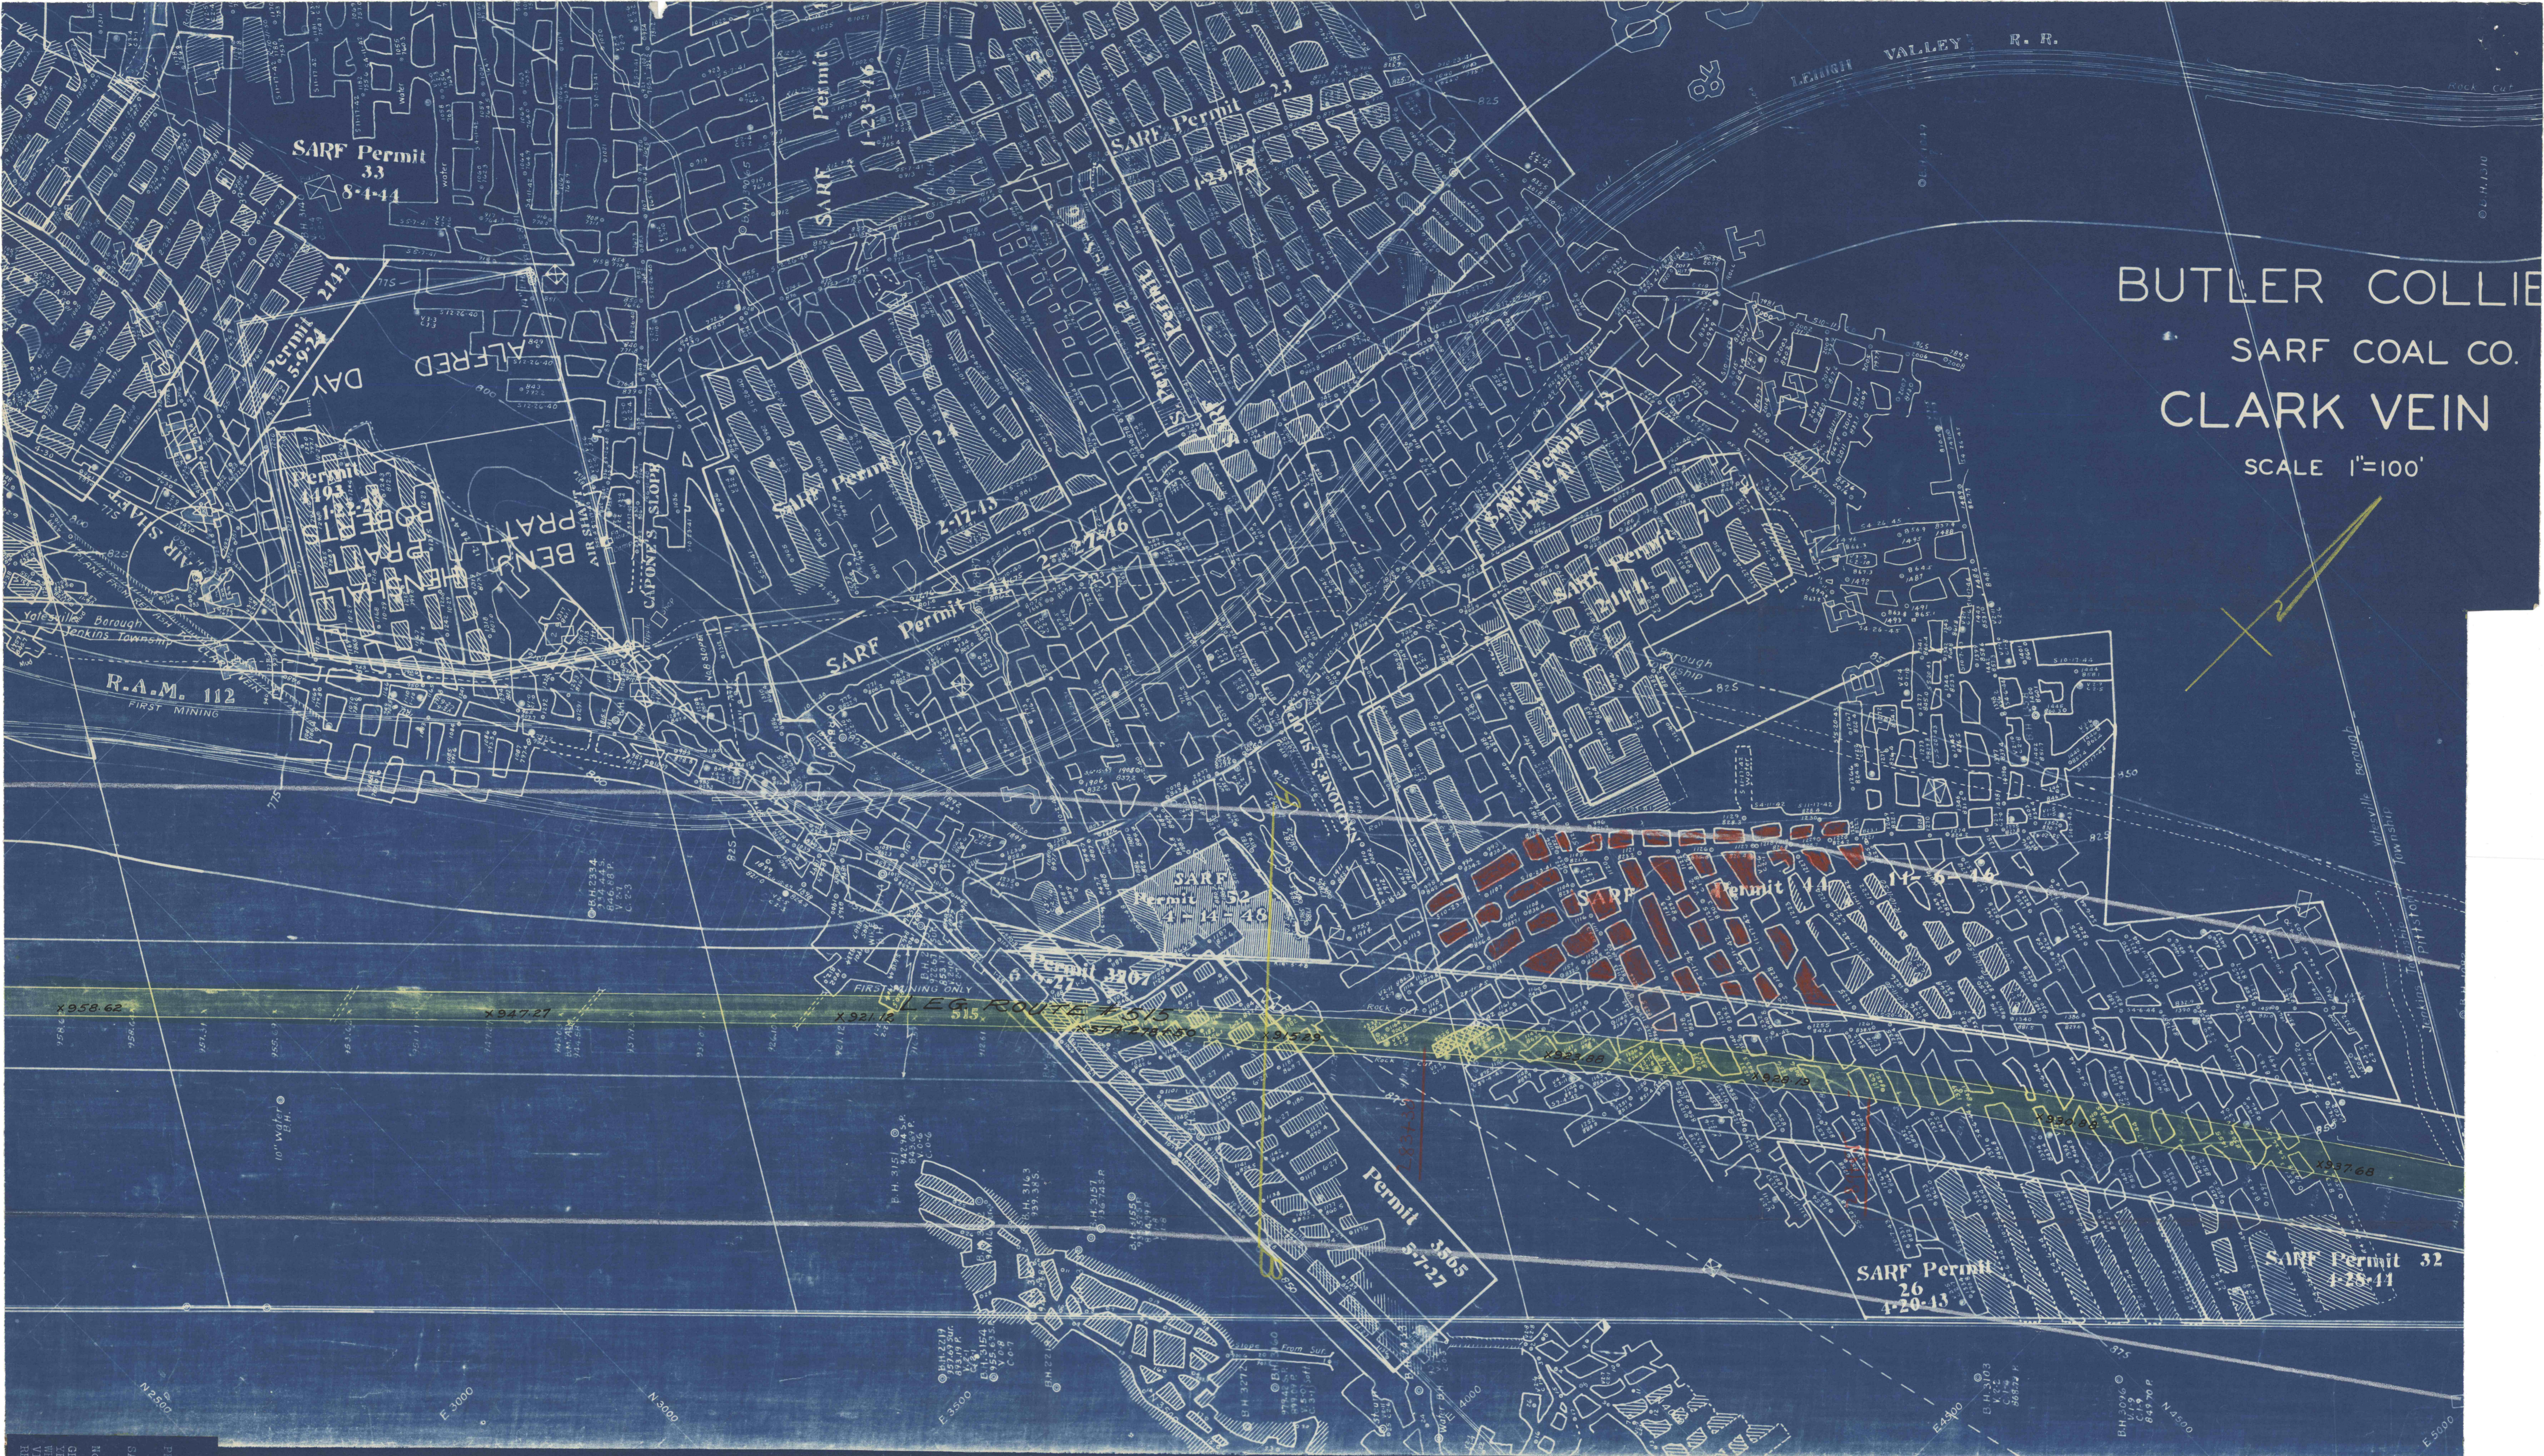

278150
480
28330
625
28955

BUTLER COLLIERIES
MARCOE SLOVE - CLARK VEIN
PENNSYLVANIA COAL CO.
(owner)
SWIN & HILL SFS.,
DUNMORE, PA.
STATE ROAD, YARPSVILLE,
BOX 342, PITTSBURGH, PA.
No Mining Engineer at present.
GREEN - Leg. Route #515.
YELLOW - Cross sections.
WHITE - 300 Ft. line adjacent to center of road.
VIOLET - 6 months contemplated first mining.
RED -