


BUTLER COLLIERY SARF COAL CO. CLARK VEIN

SCALE 1"=100'

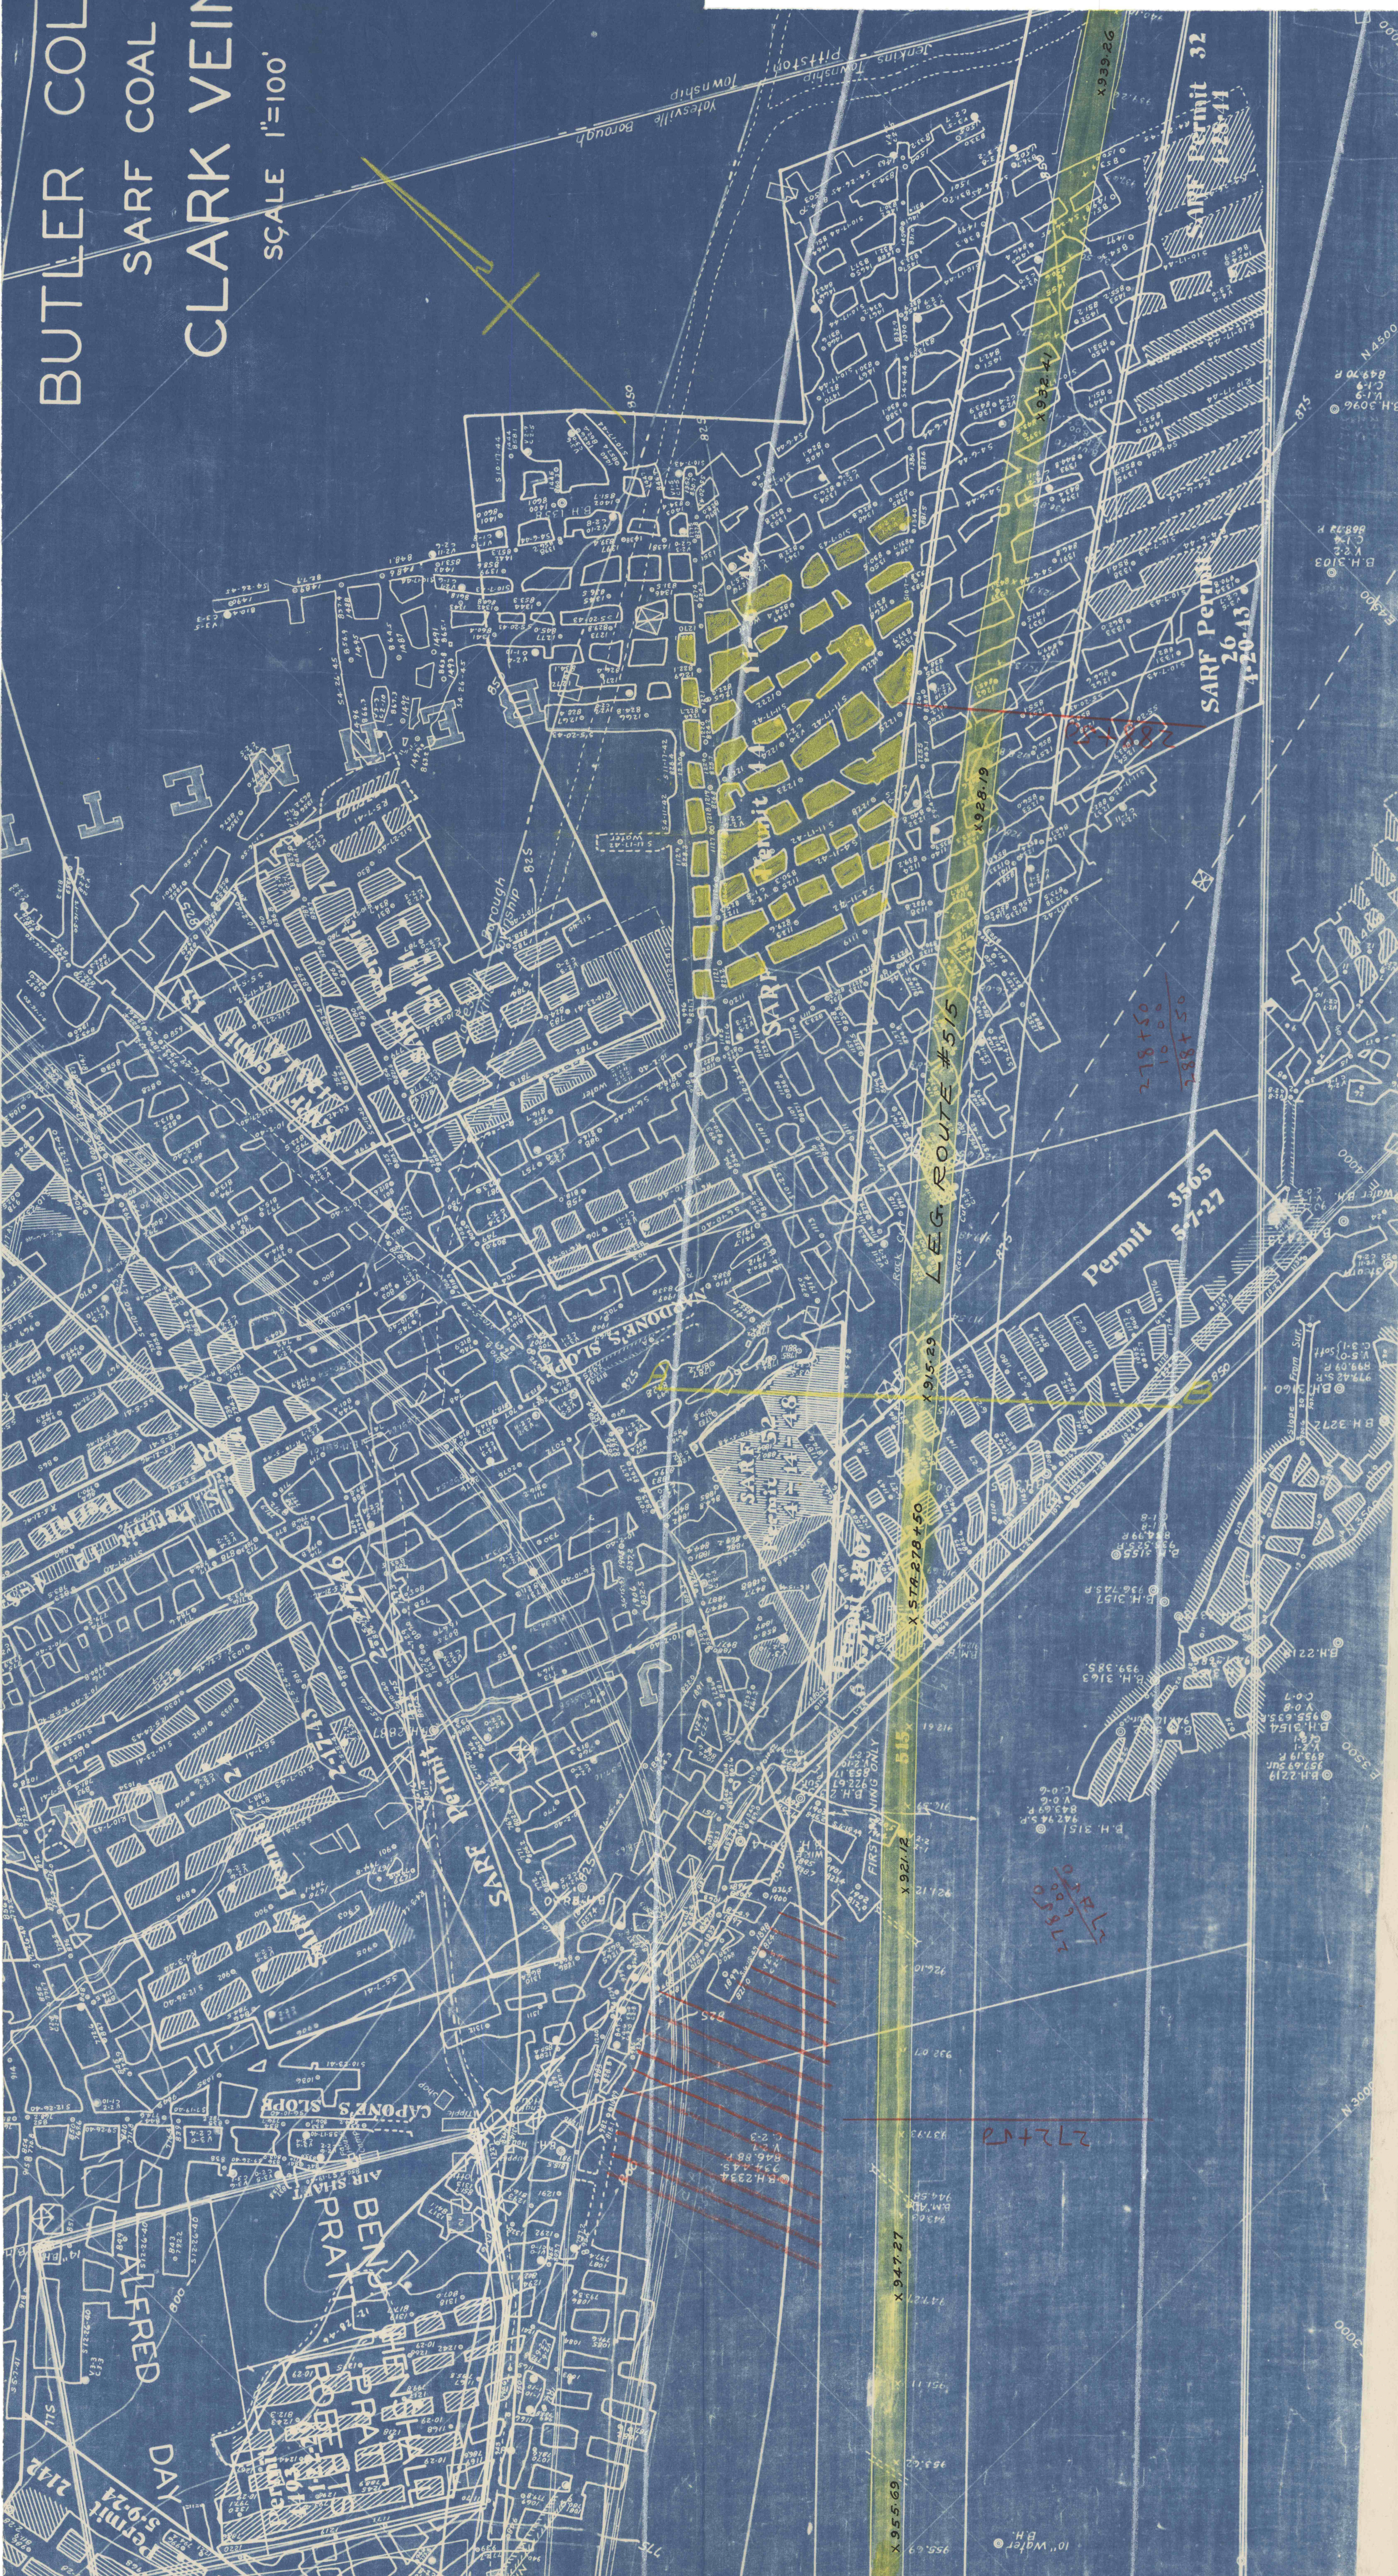

RECEIVED
PENNA. DEPT. OF HIGHWAYS
NOV-9 1950
DISTRICT No. 4
SCRANTON, PA.

1st mining - within 300' of Hwy near Sta. 272+50
2nd " - " " " " " " 288+50

| BUTLER COLLIERY NARDONE SLOPE - CLARK VEIN | |
|--|---|
| PENNSYLVANIA COAL CO. (Owner) | SMITH & MILL STS., DUNMORE, PA. |
| SARF COAL CO. (Operator) | STATE ROAD, YATESVILLE, BOX 352, PITTSBURGH, PA. |
| No Mining Engineer at present. | |
| GREEN - Leg. Route #515. | |
| YELLOW - Cross sections. | |
| WHITE - 300 Ft. Line adjacent to center of road. | |
| VIOLET - 6 months contemplated second mining. | |
| RED - 6 months contemplated first mining. | |