


BUTLER COLLIERY
SARF COAL CO.
CLARK VEIN
SCALE 1"=100'

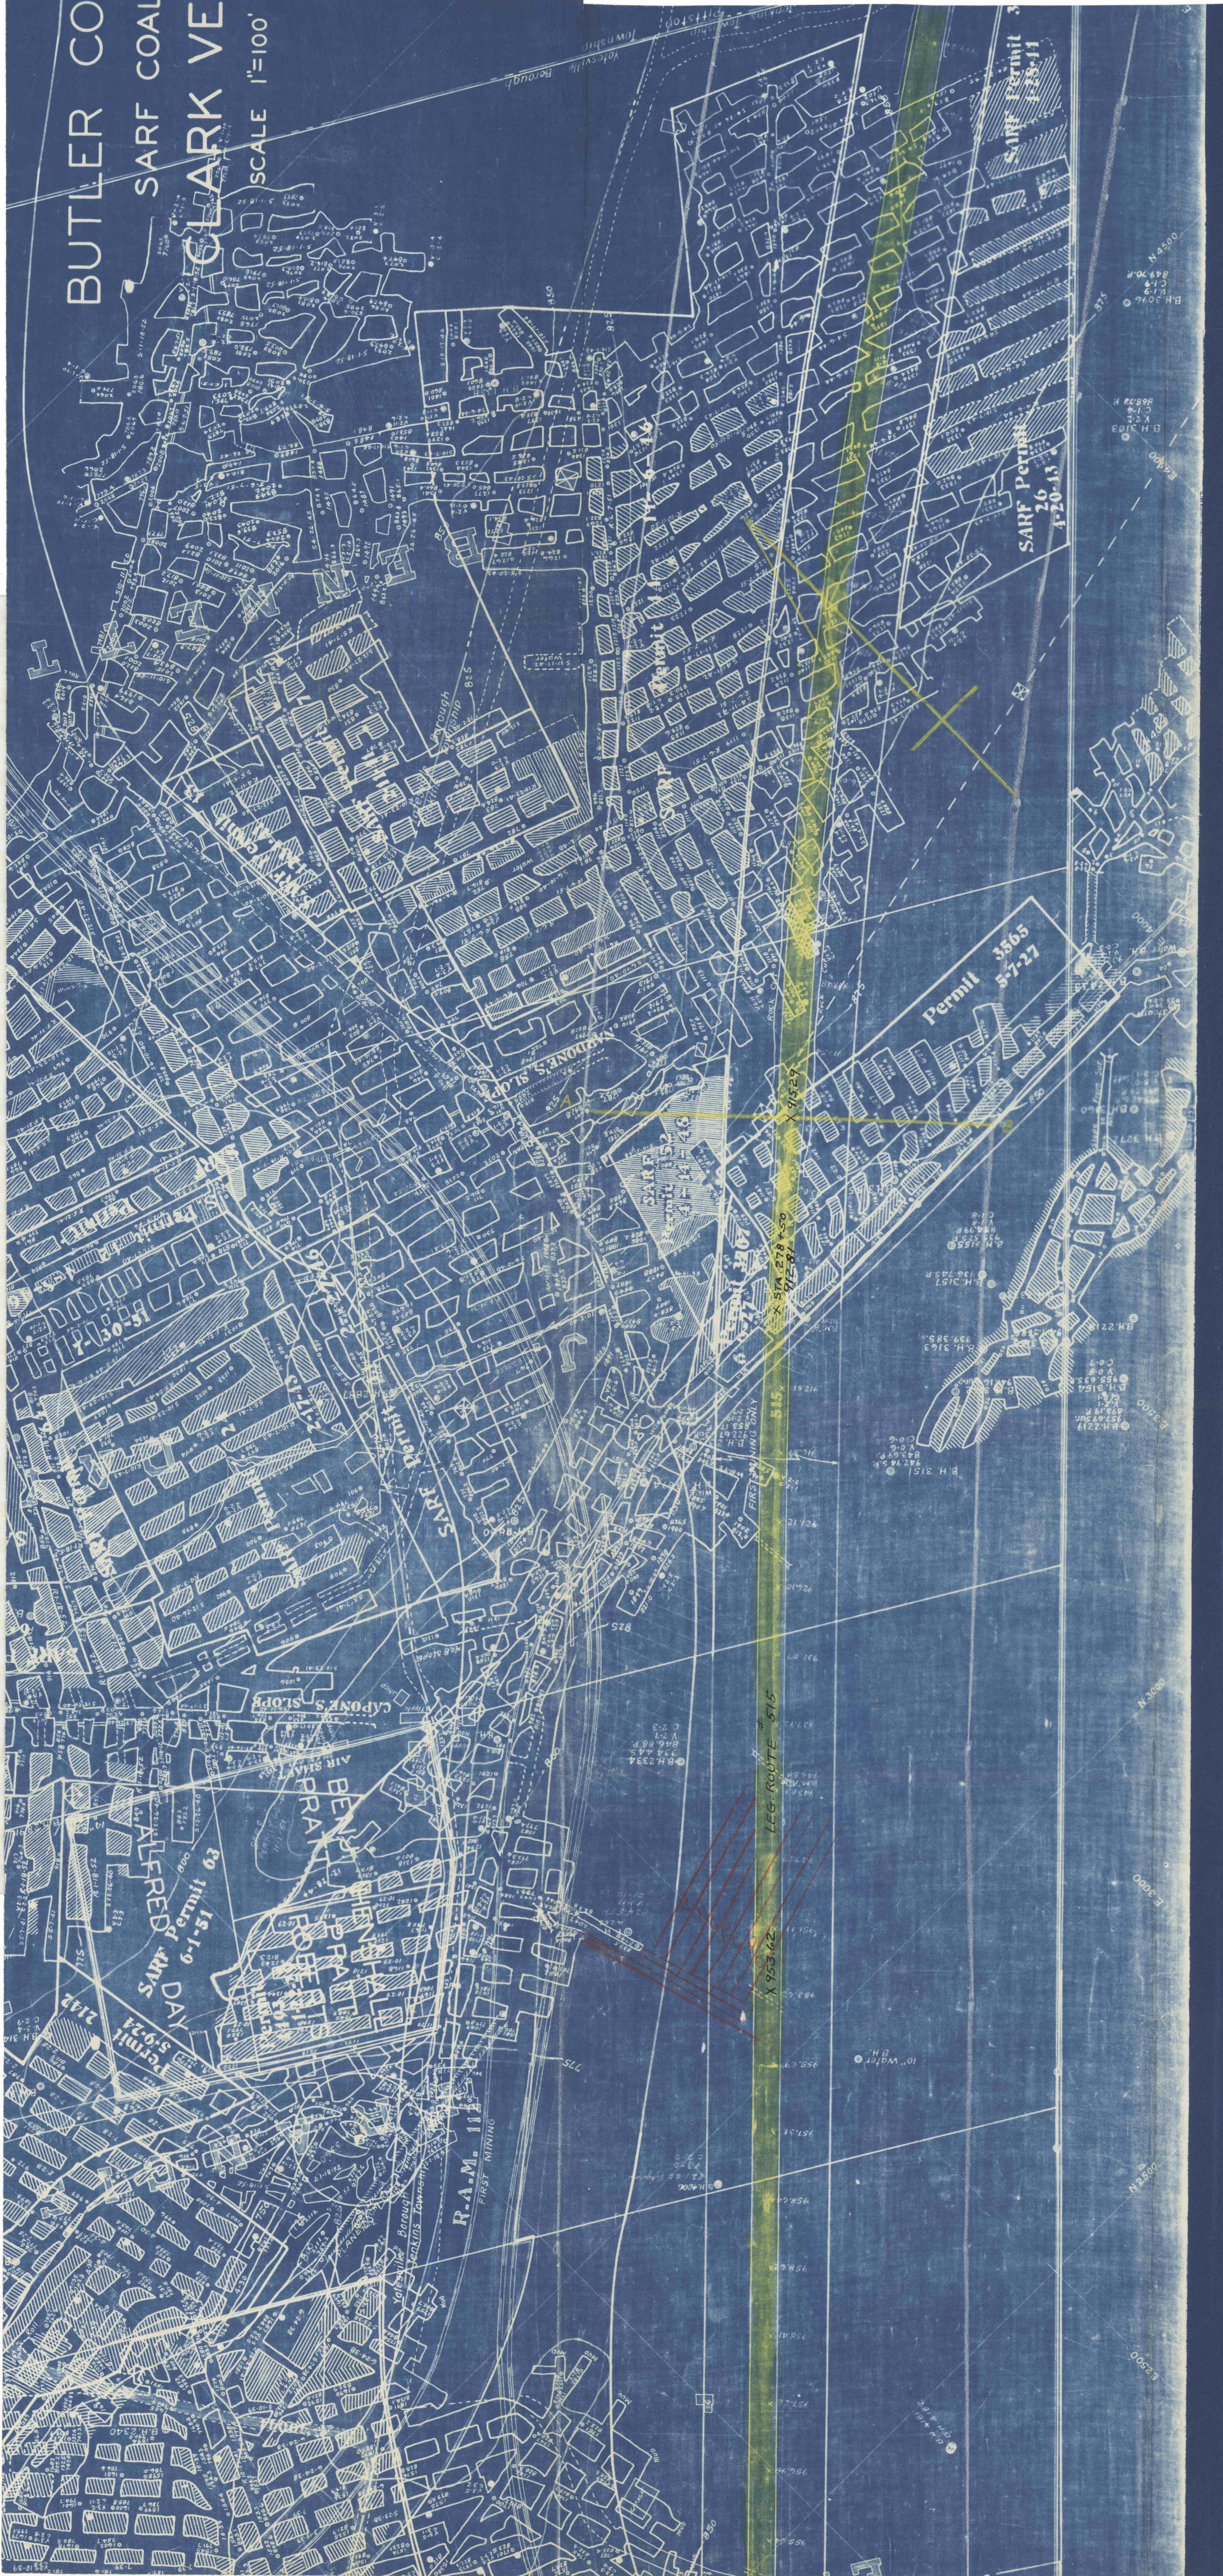

BUTLER COLLIERY
WARDONE SLOPE - CLARK VEIN
PENNSYLVANIA COAL CO. (Owner) SMITH & MILL STS., DUNMORE, PA.
SARF COAL CO. (Operator) STATE ROAD, YATESVILLE, BOX 352, PITTSBURGH, PA.
No Mining Engineer at present.
GREEN - Leg. Route #515.
YELLOW - Cross sections.
WHITE - 300 Ft. Line adjacent to center of road.
VIOLET - 6 months contemplated second mining.
RED - 6 months contemplated first mining.