



SECTION A-B

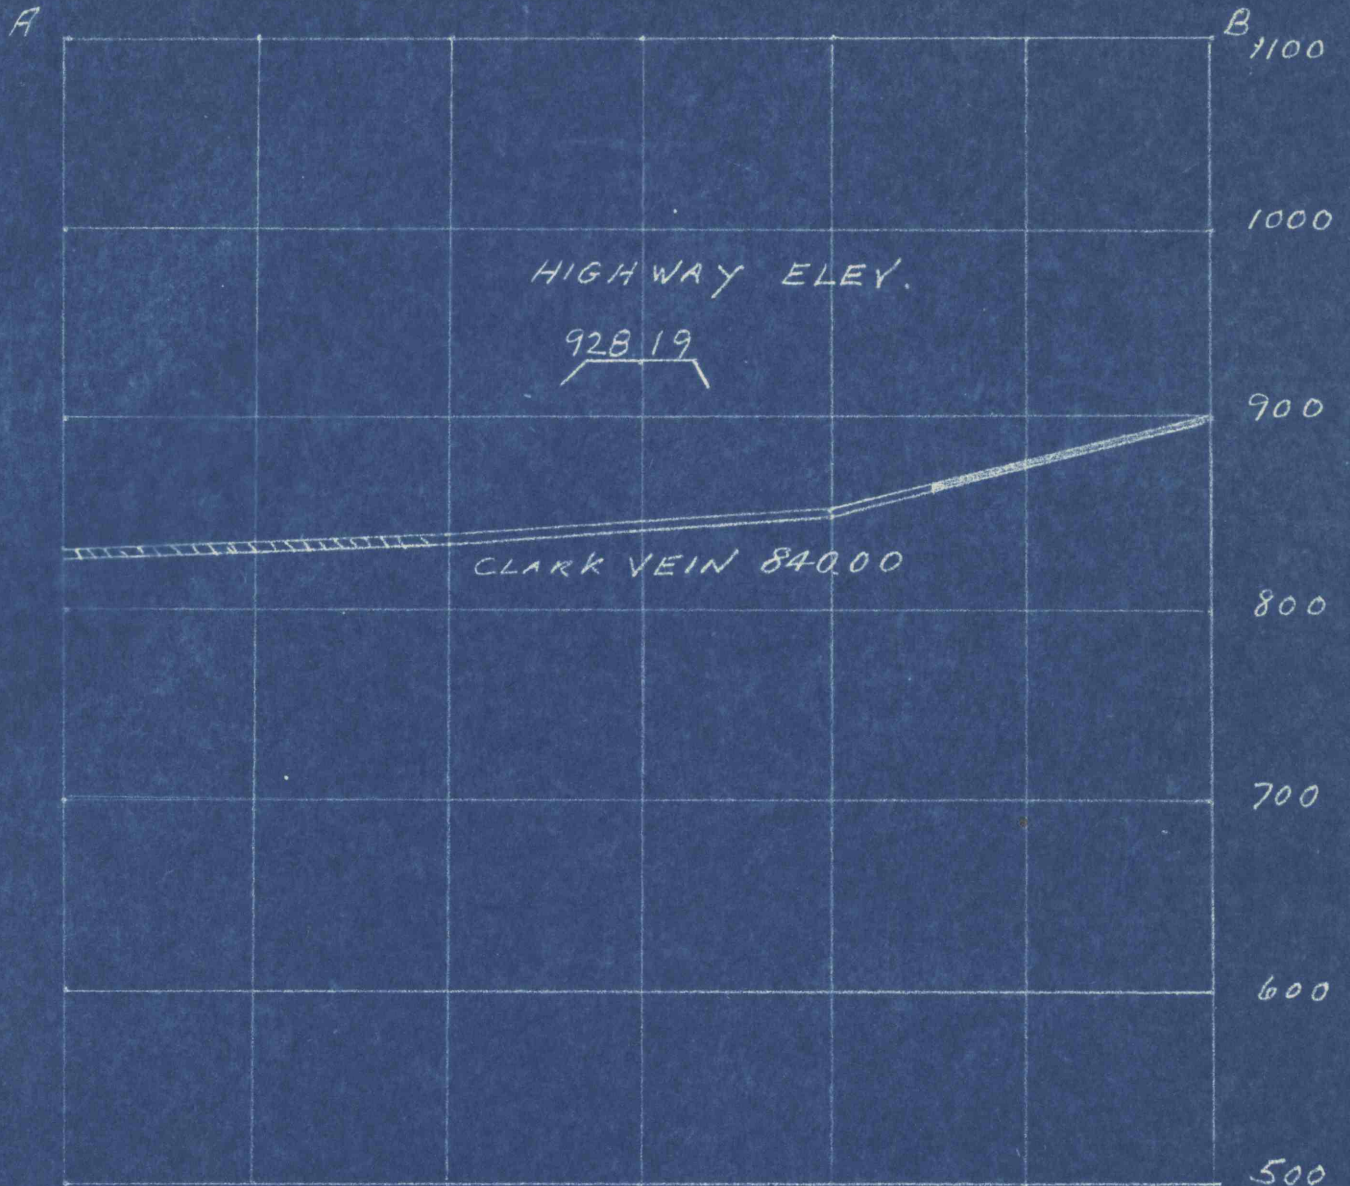

②
1st + 2nd mining within
300 feet of highway

BUTLER COLLIERY
Nardone Slope ---- Clark Vein
Scale 1" = 100'

Cross section of Clark Vein
underlying Leg. Route #515
in Jenkins Township, Luzerne
County, Pa.


 Virgin coal
 First mining
 Complete mining