


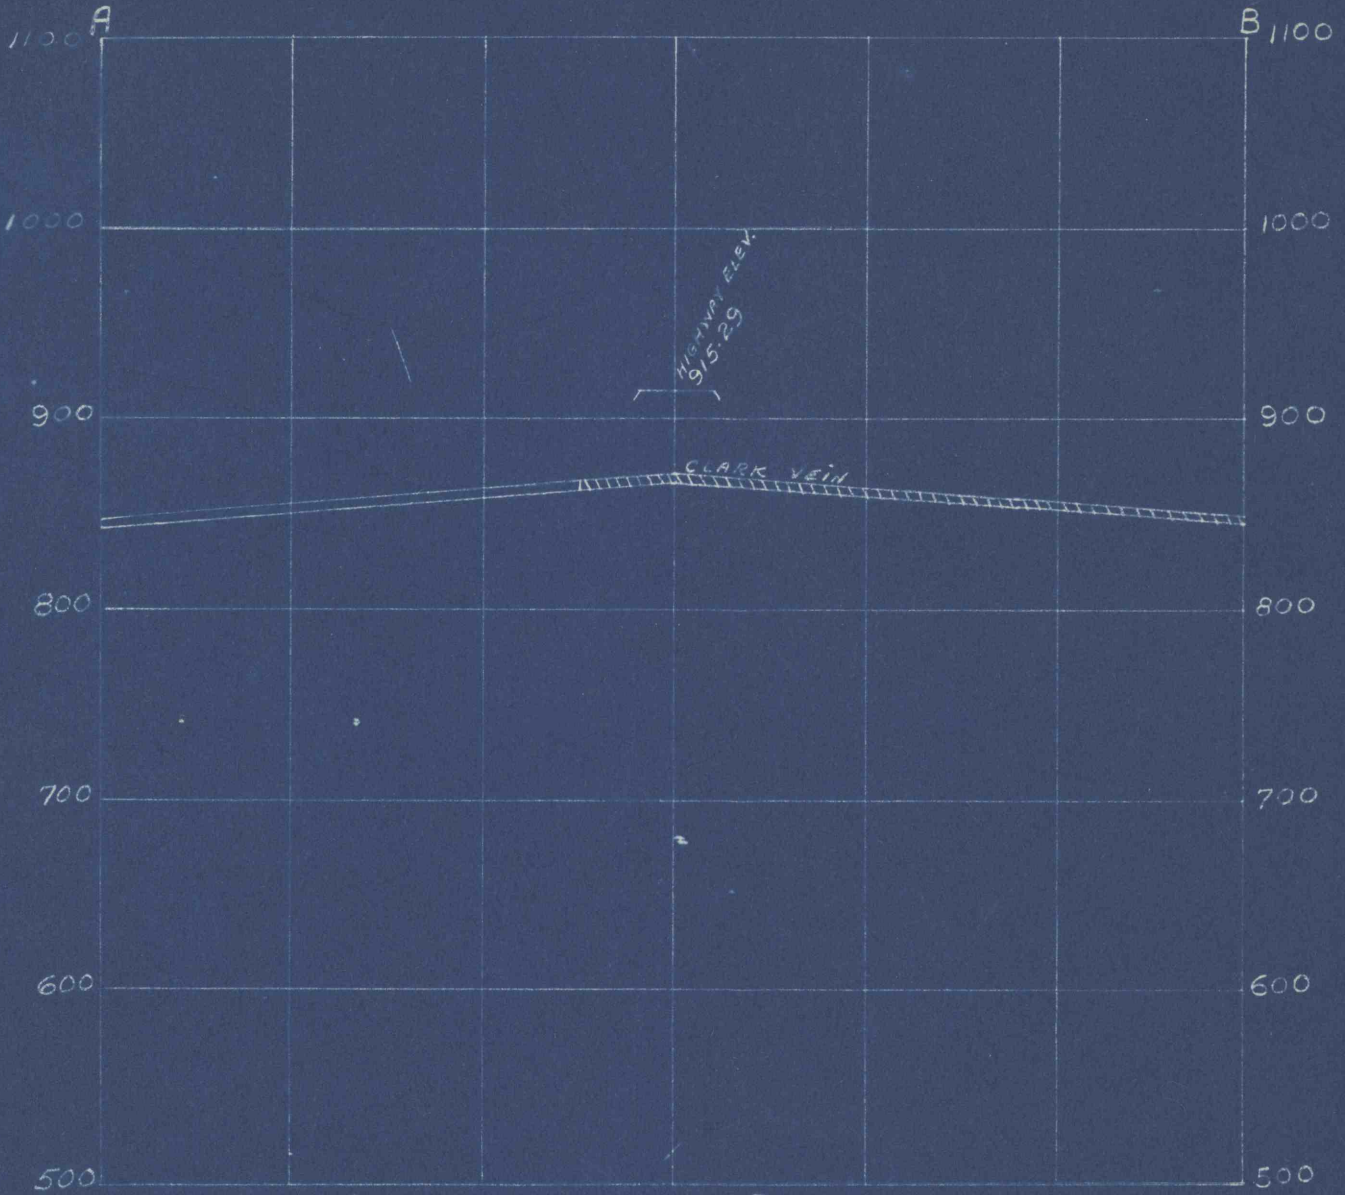

SECTION A - B



BUTLER COLLIERY
Nardone Slope ---- Clark Vein
Scale 1" - 100'

Cross section of Clark Vein
underlying Leg. Route #515 in
Jenkins Township, Luzerne
County, Pa.

-  First mining
-  Complete mining