


SECTION A - B

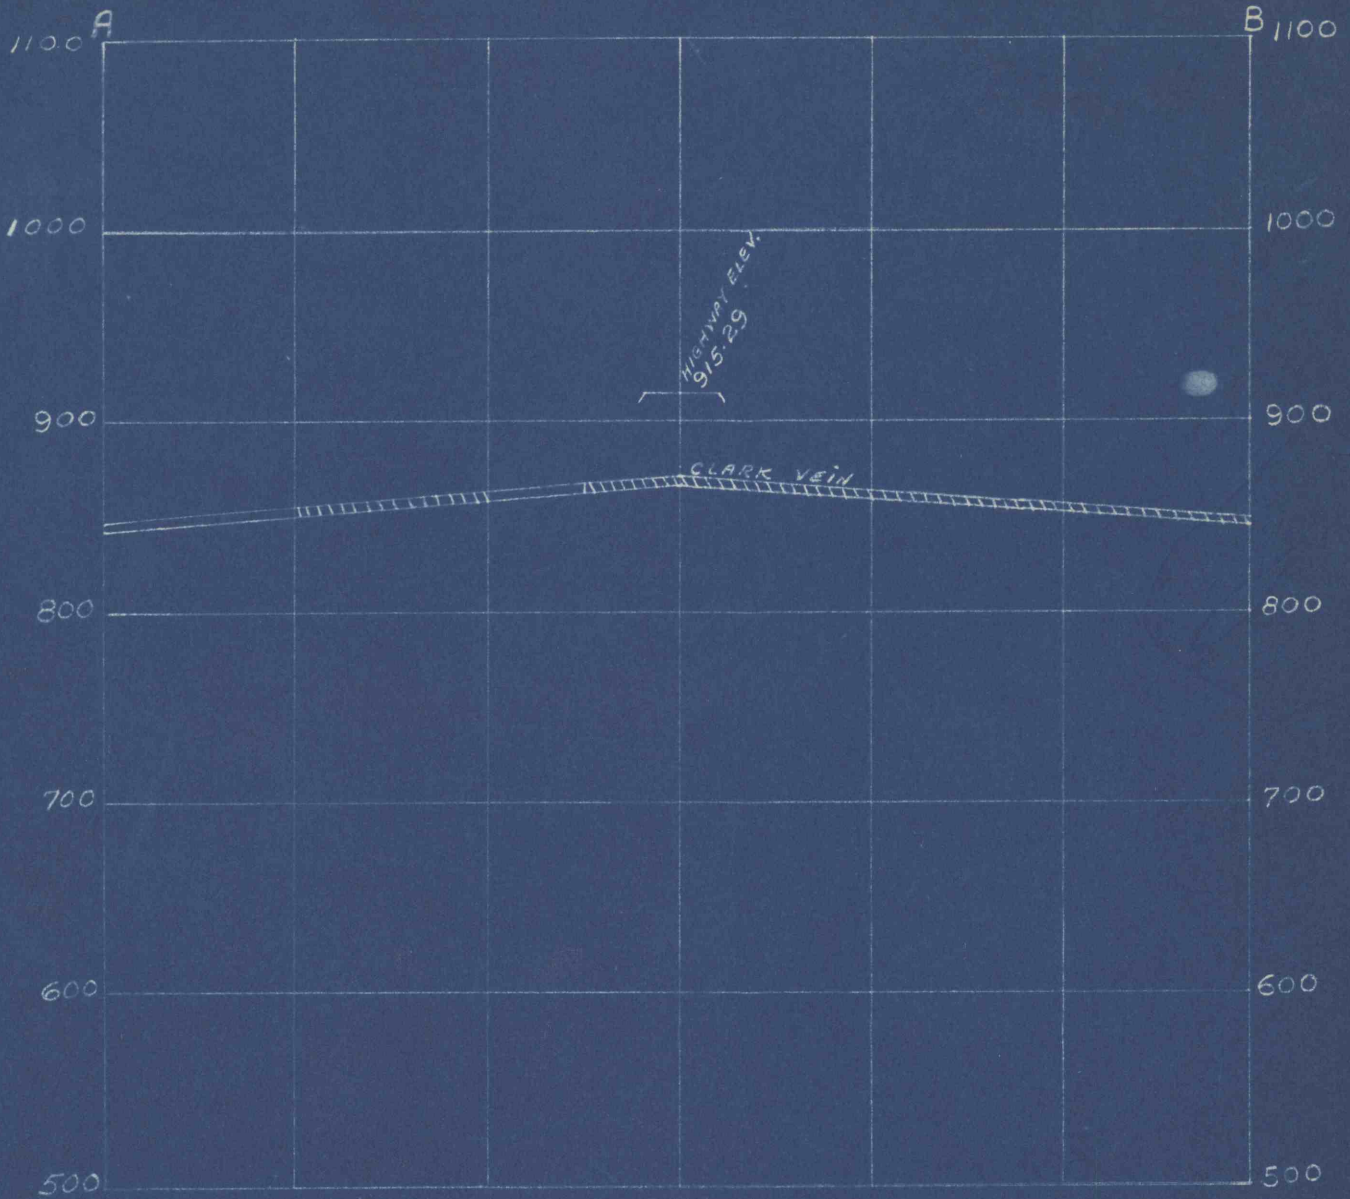

BUTLER COLLIERY
 Nardone Slope ---- Clark Vein
 Scale 1" - 100'

Cross section of Clark Vein
 underlying Leg. Route #515 in
 Jenkins Township, Luzerne
 County, Pa.

- First mining
- Complete mining