


SARF COAL CO.  
**CLARK VEIN**  
 SCALE 1"=100'

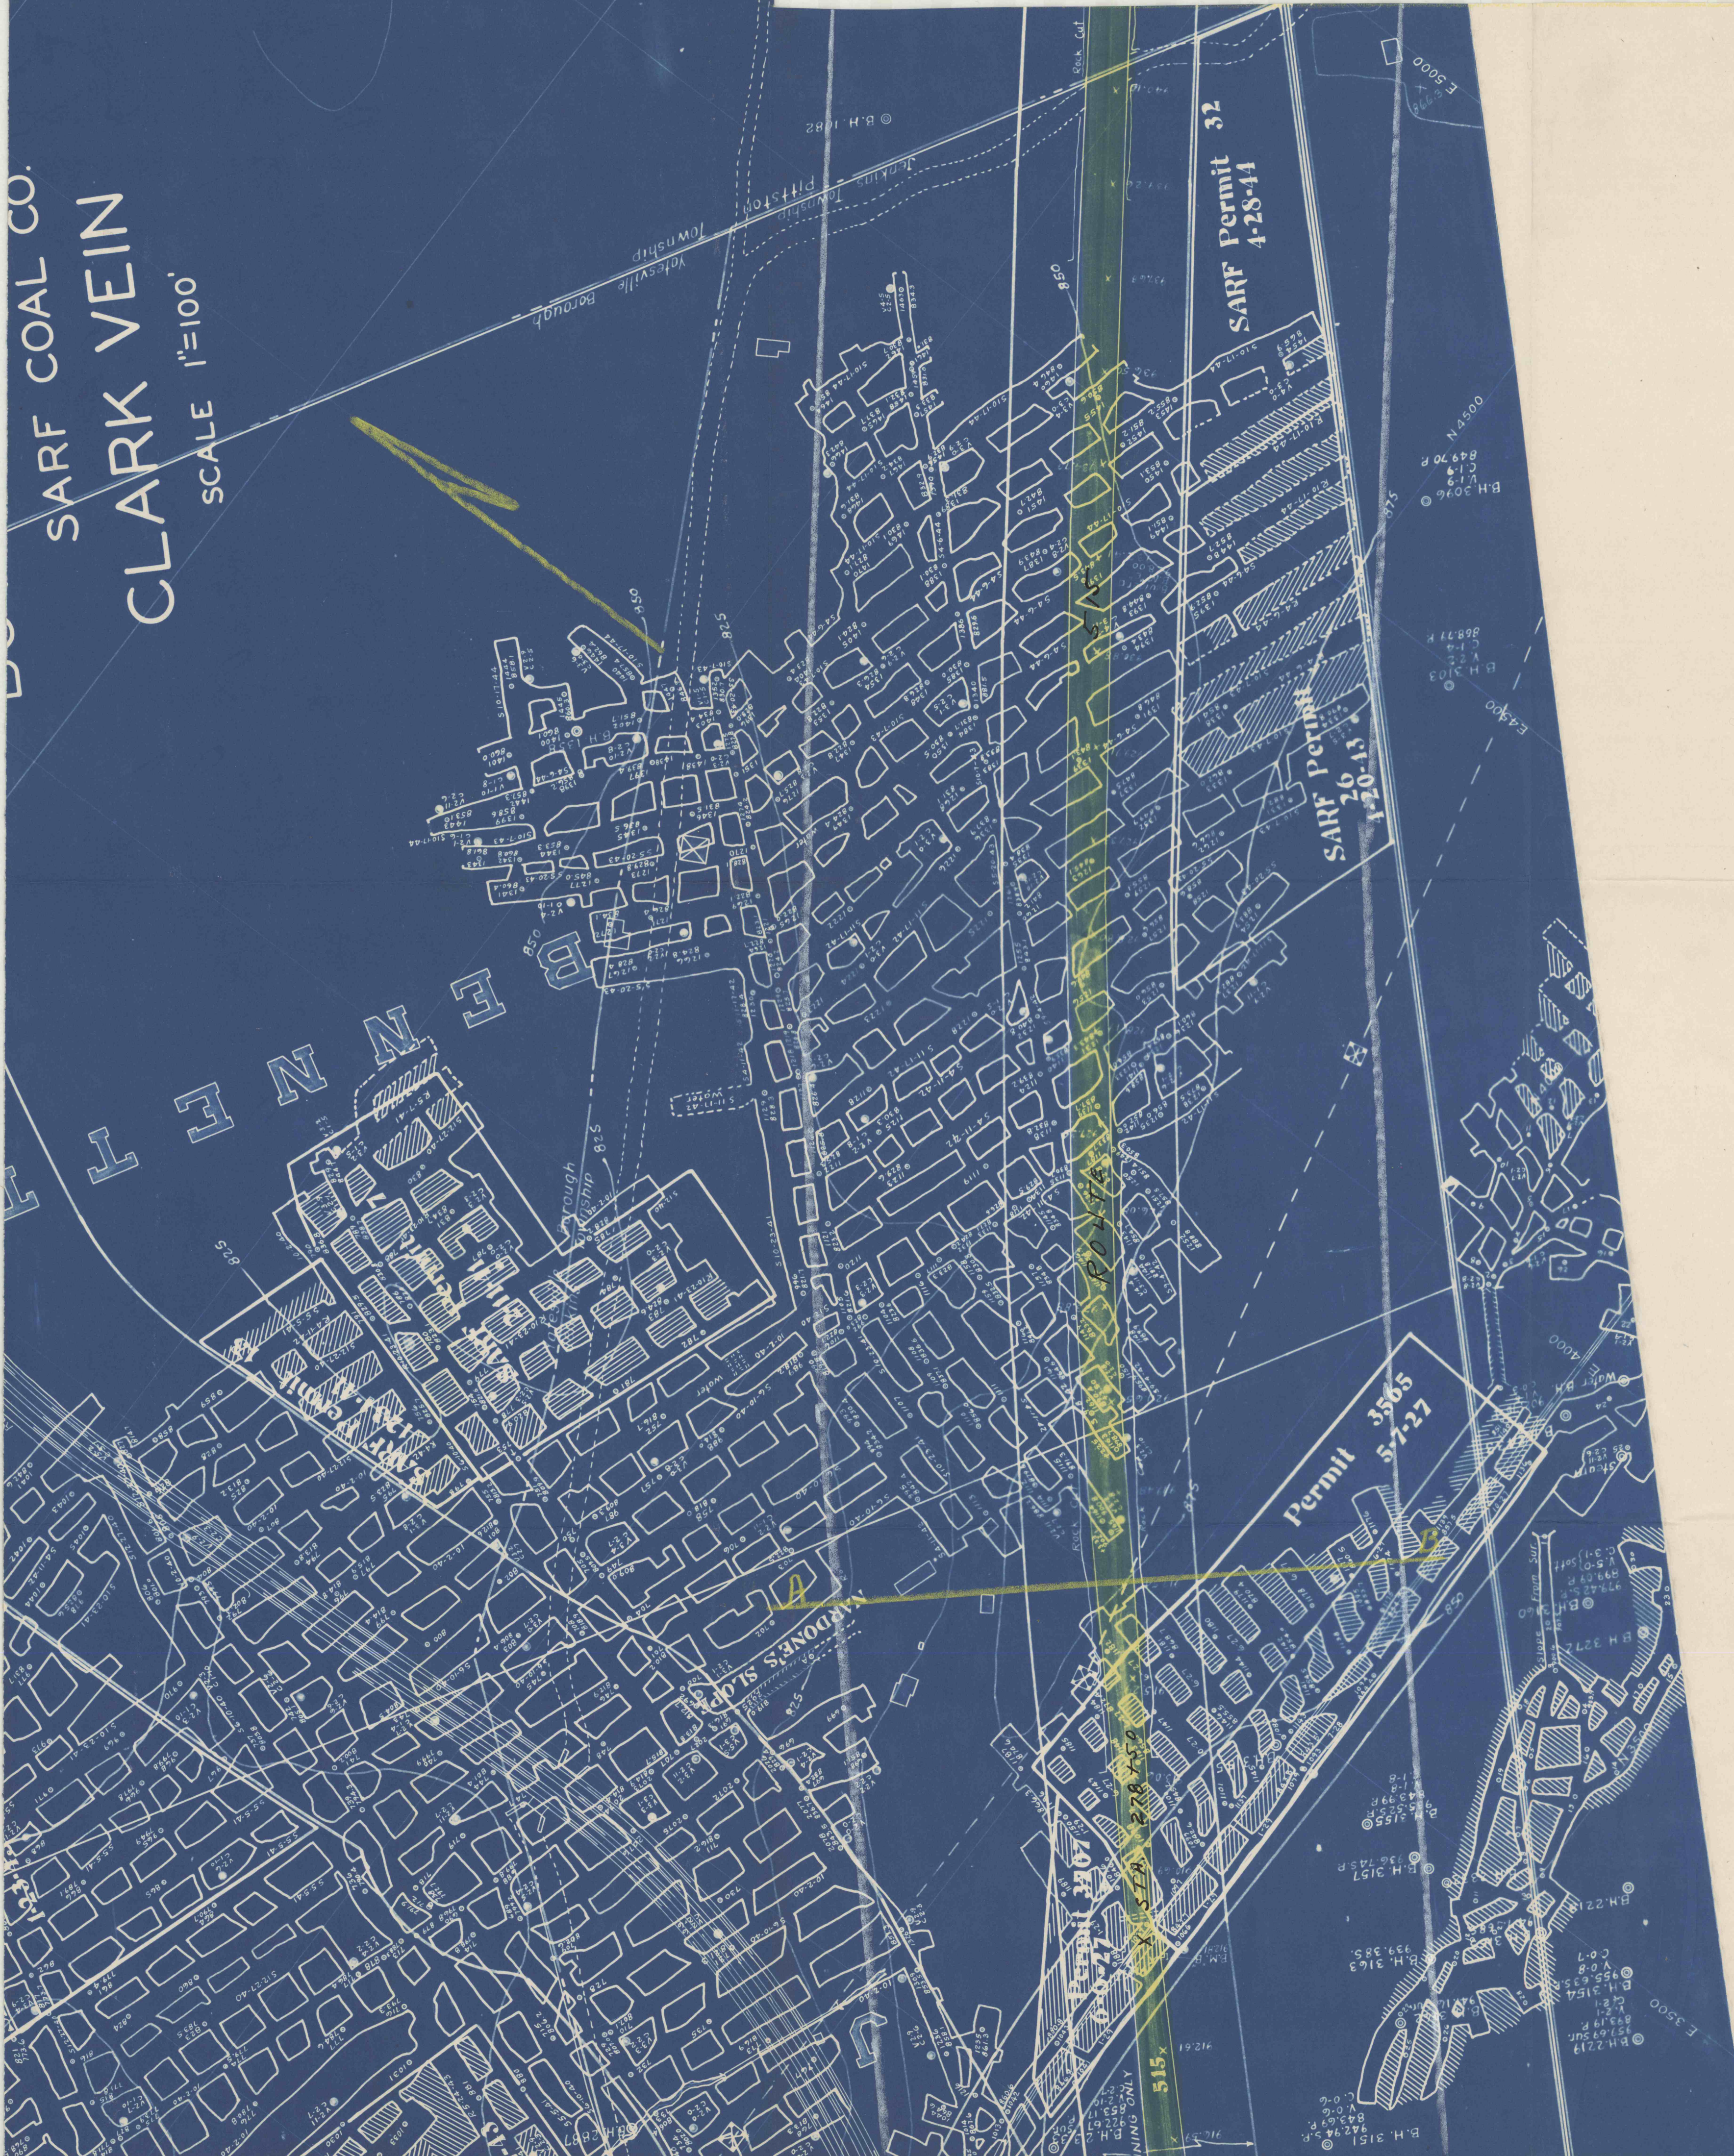

BUTLER COLLIERY  
 SARF SLOPE --- CLARK VEIN

PENNSYLVANIA COAL CO. (Owner) SMITH & MILL STS.,  
 DUNMORE, PA.

SARF COAL CO. (Operator) STATE ROAD, YATESVILLE,  
 PITTSTON, PA.

No Mining Engineer at present.

GREEN - Leg. Route #515.  
 YELLOW - Cross Sections.  
 WHITE - 300 Ft. line adjacent to center of road.  
 VIOLET - 6 months contemplated 2nd mining.  
 RED - 6 months contemplated 1st mining.