


RECEIVED
PENNA. DEPT. OF HIGHWAYS
NOV 25 1942
DIST. ENGR. 4-0
SCRANTON, PA.

LEG. ROUTE # 515

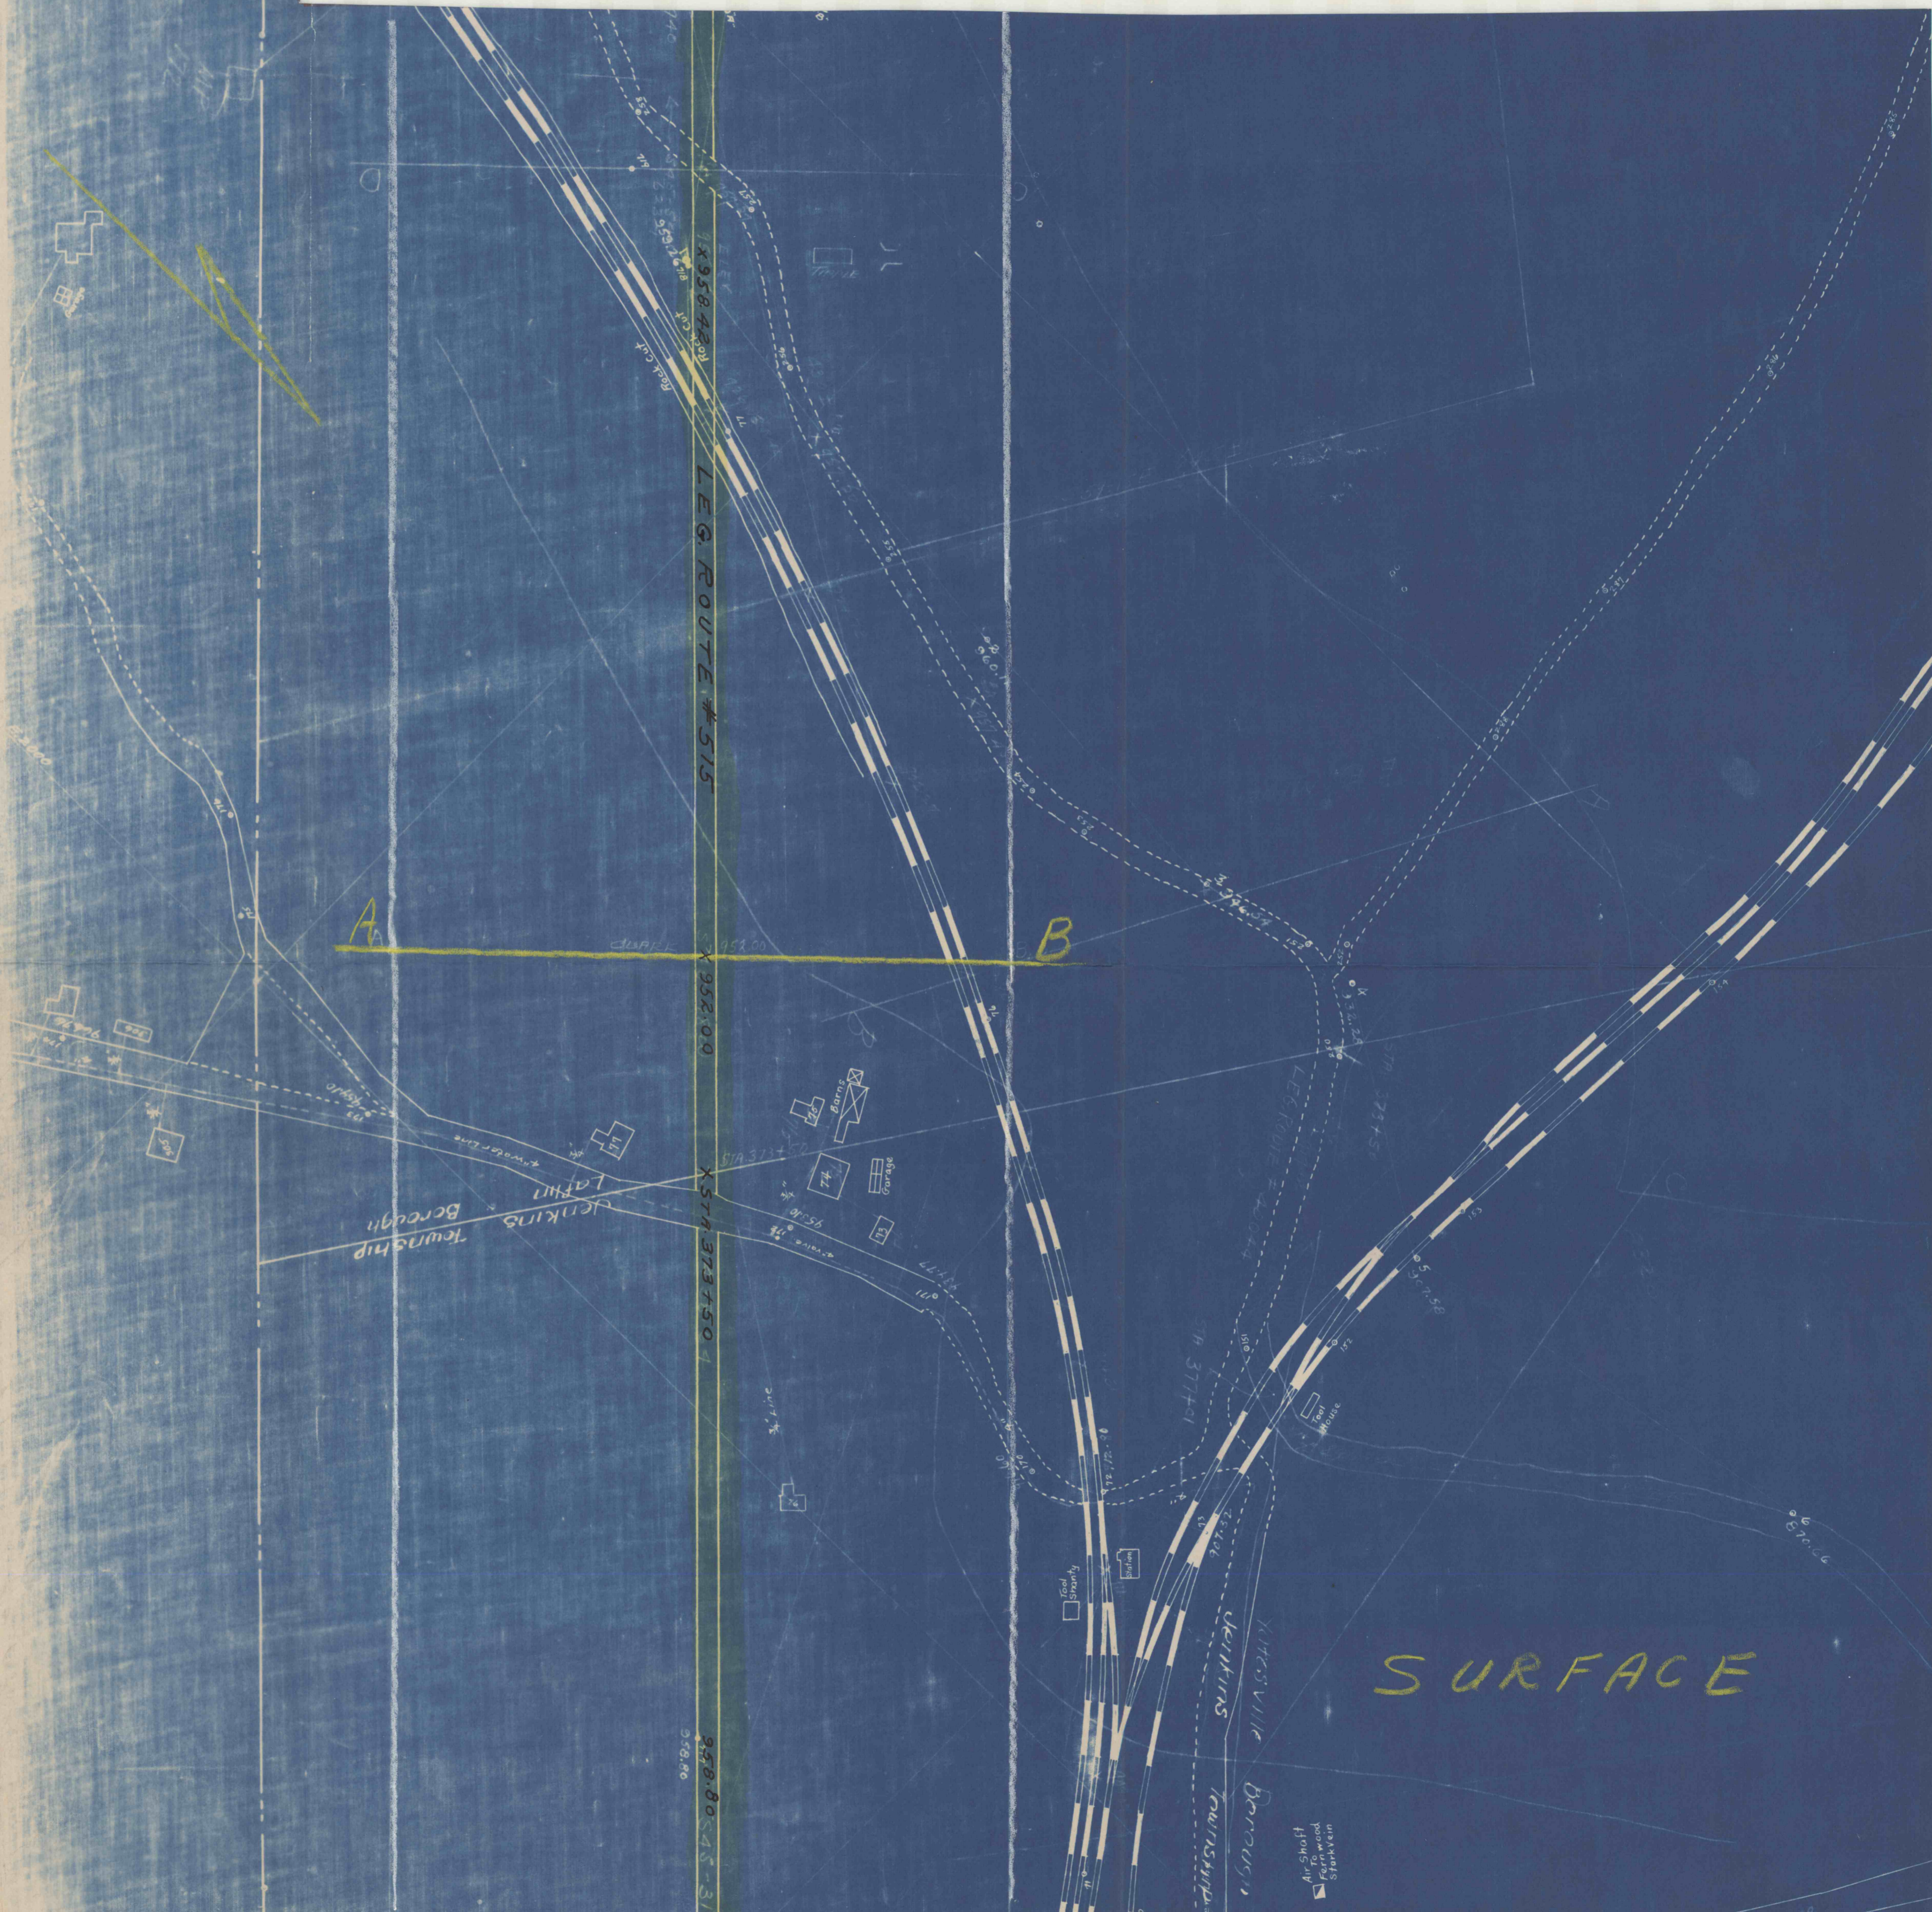

SURFACE

Air Photo
Furnished
Starkwin

958.00 545.31
958.00

533.94