


RECEIVED
 PENN. DEPT. OF HIGHWAYS
 NOV 25 1942
 DIST. ENGR. 4-0
 SORANTON

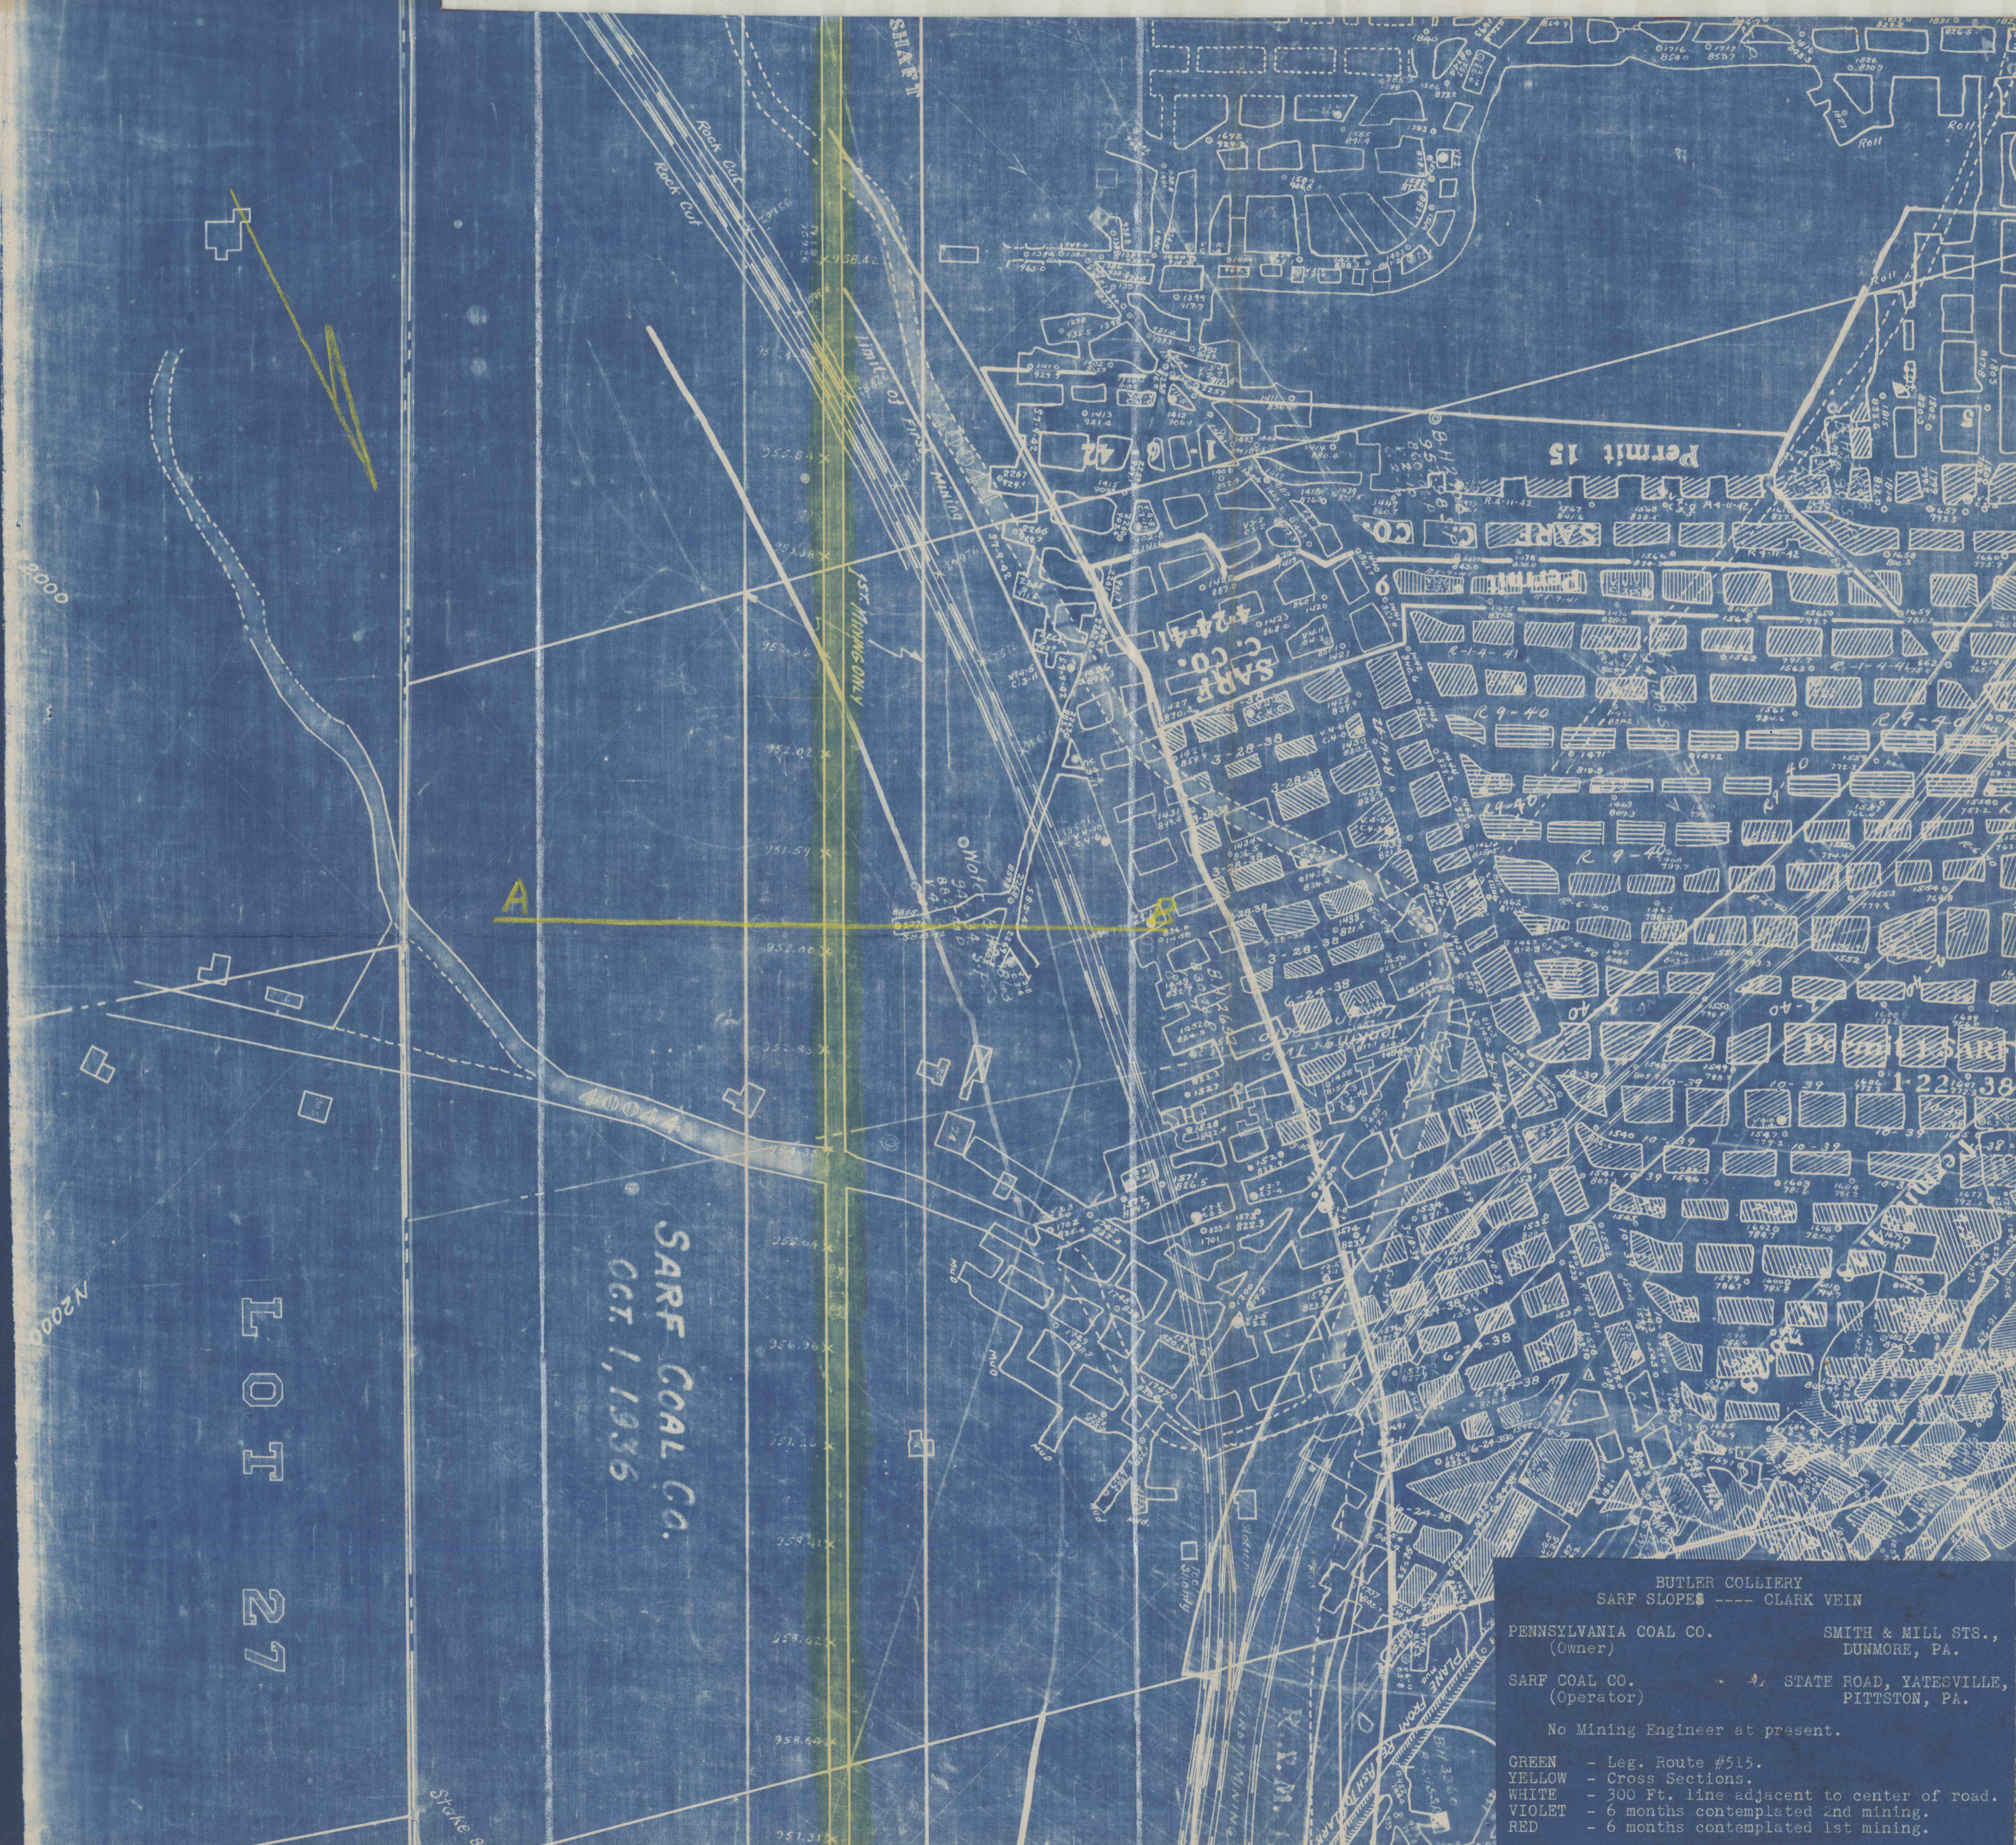

2000

N2000

LOT 27

SARF COAL CO.
 OCT. 1, 1936

Stake 8

BUTLER COLLIERY
 SARF SLOPES --- CLARK VEIN

PENNSYLVANIA COAL CO. (Owner) SMITH & MILL STS., DUNMORE, PA.

SARF COAL CO. (Operator) STATE ROAD, YATESVILLE, PITTSTON, PA.

No Mining Engineer at present.

GREEN - Leg. Route #515.
 YELLOW - Cross Sections.
 WHITE - 300 Ft. line adjacent to center of road.
 VIOLET - 6 months contemplated 2nd mining.
 RED - 6 months contemplated 1st mining.