


Section A - B

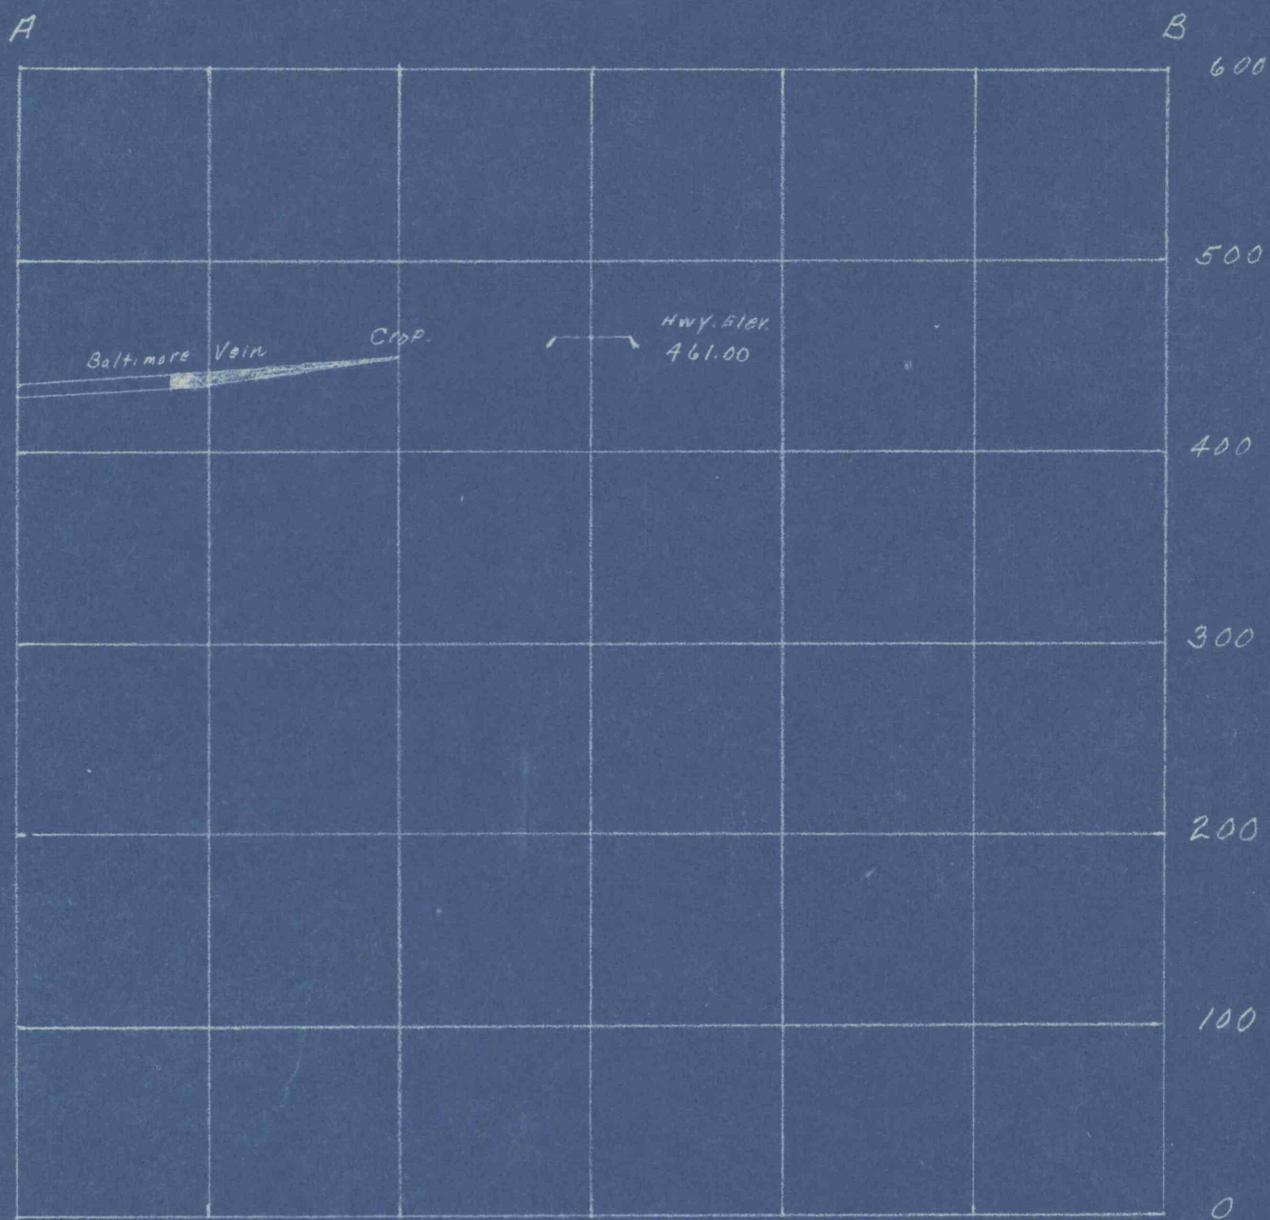

KEYSTONE COLLIERY
 Baltimore Drifts-Baltimore Vein
 Scale 1" - 100'
 Cross section of Baltimore Vein
 underlying Leg. Route #515 in
 Plains Twp., Luzerne Co., Penna.

Virgin coal
 First mining
 Complete mining