

PITTSTON


TOWNSHIP

To WILKES-BARRE

STA. 338+00

3' DIA. - 2' DEEP

NEW OPEN AIR THEATRE

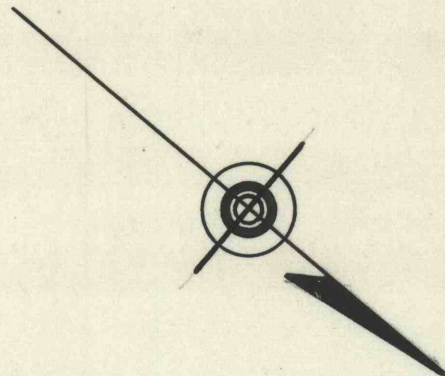

ROUTE 515

To SCRANTON

JERMYN-GREEN COAL CO.

PITTSTON TOWNSHIP

LUZERNE COUNTY

SKETCH:- DO NOT SCALE

Penn'a. Dept. of Highways - Scranton, Pa.  
May 10, 1948

T.F.S.