

PITTSTON

TOWNSHIP

To WILKES-BARRE


ROUTE 515

To SCRANTON

STA. 338+00

3' DIA. - 2' DEEP

NEW OPEN AIR THEATRE

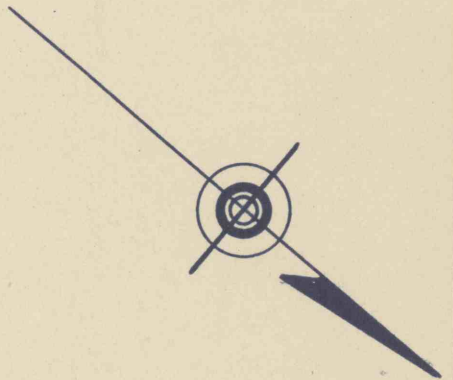

JERMYN-GREEN COAL CO.

PITTSTON TOWNSHIP

LUZERNE COUNTY

SKETCH:-DO NOT SCALE

Pennia. Dept. of Highways - Scranton, Pa.
May 10, 1948
T.F.S.