

MINER

Yatesville Borough

2-17-48

SARF

Permit 51

AIR SHAF

X 342+80

STATE HIGHWAY 515

B


E 2000

E 1500

E 1500

E 1000

E 1000

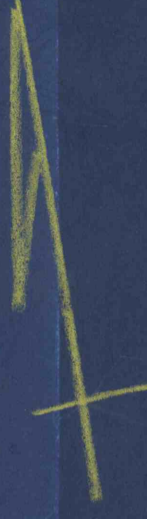

BUTLER COLLIERY  
 SARF SLOPES - BABYLON VEIN

PENNSYLVANIA COAL CO.      SMITH & MILL STS.,  
 (Owner)                              DUNMORE, PA.

SARF COAL CO.                      STATE ROAD, YATESVILLE,  
 (Operator)                              PITTSTON, PA.

No Mining Engineer at present.

GREEN - Leg. Route #515.  
 YELLOW - Cross Sections.  
 WHITE - 300 Ft. line adjacent to center of road.  
 VIOLET - 6 months contemplated 2nd mining.  
 RED - 6 months contemplated 1st mining.