

BLAKELY



BORO

To JUSTUS →

533

ROUTE

← To DICKSON CITY

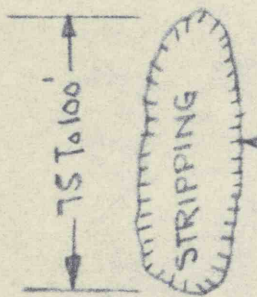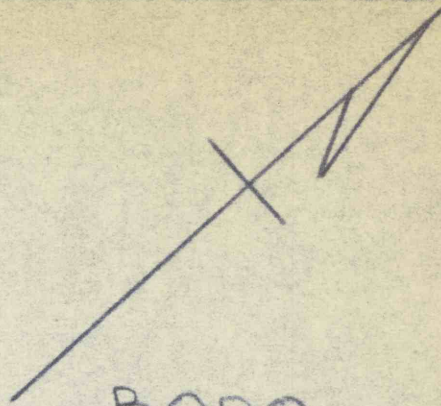

60'

STA. 80+50

SKETCH-DO NOT SCALE

10-14-48

T.F.S.