


ALBERT VENTURES INC.
RAYMOND COLLIERY CO.
STM. 6415

END OF CONSTRUCTION 33126

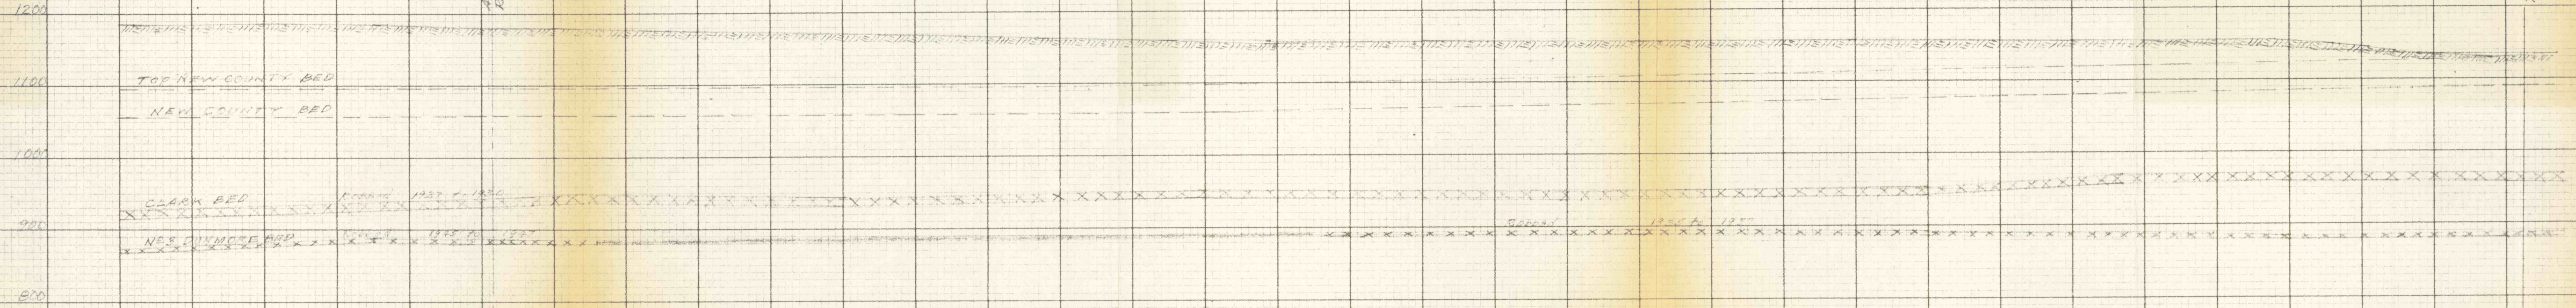

PROFILE ALONG E. OF GLENVIEW ROAD
FROM L.R. 649 ET. TO VALLEY VIEW
JUNIOR-SENIOR HIGH SCHOOL
ARTHUR H. BLOOMER L.A. 36. 34.
SCALE VERT. 1"=100' APRIL 11, 1956