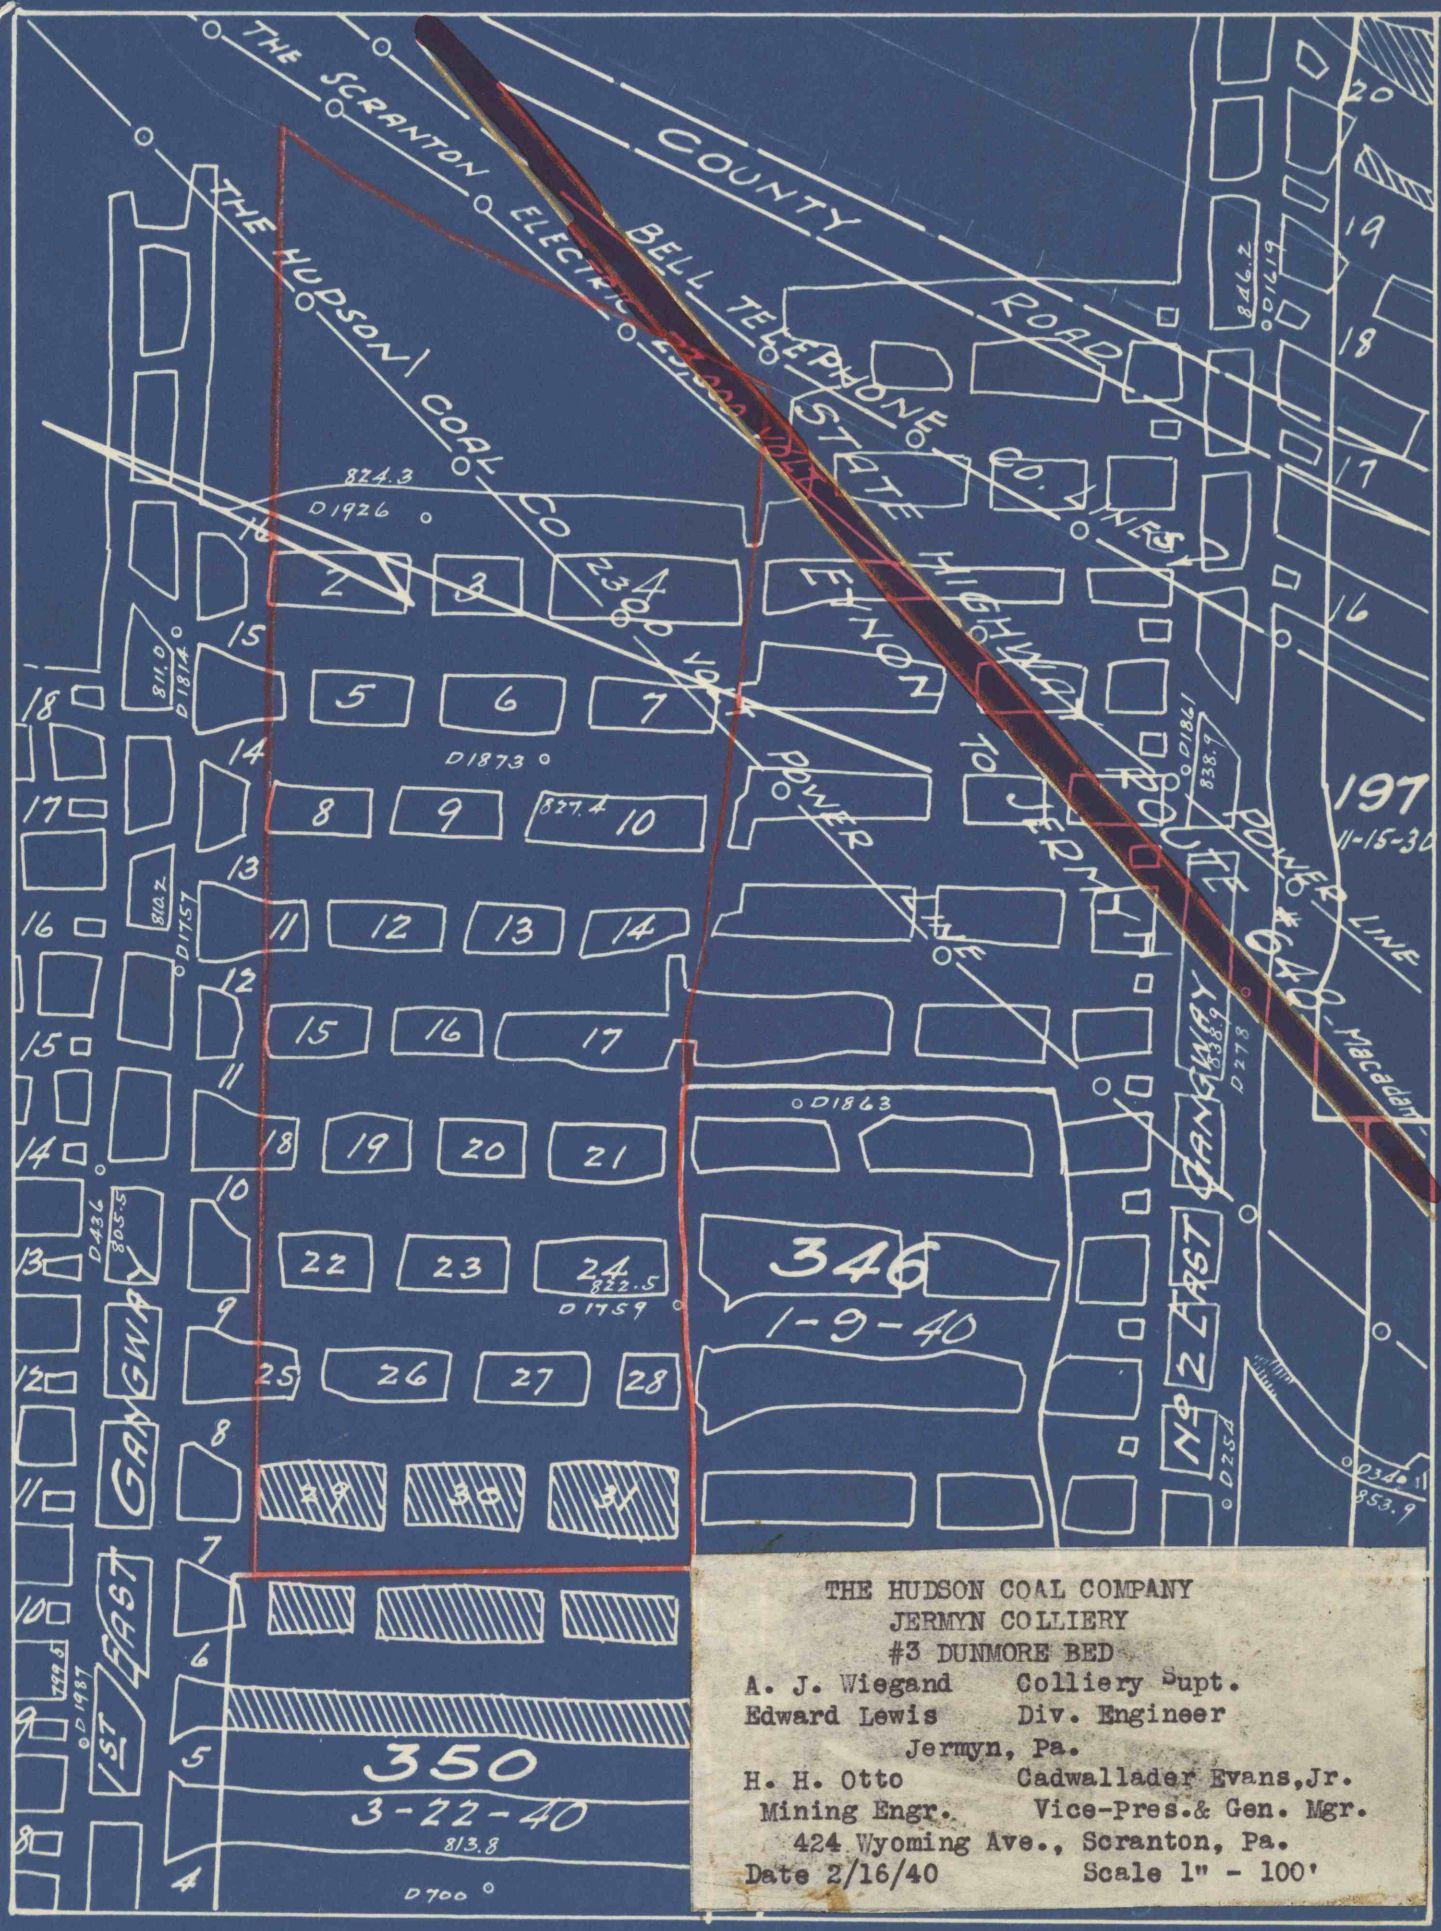
THE SCRANTON ELECTRIC
COUNTY
BELL TELEPHONE CO. LINES
ROAD
THE HUDSON COAL CO
STATE HIGHWAY
ELVON
TO JERMYN
ROUTE #640 - Macadam
POWER LINE
POWER LINE
GANGWAY
1ST EAST
GANGWAY
2ND EAST
346
1-9-40
350
3-22-40
197
11-15-30
THE HUDSON COAL COMPANY
JERMYN COLLIERY
#3 DUNMORE BED
A. J. Wiegand Colliery Supt.
Edward Lewis Div. Engineer
Jermyn, Pa.
H. H. Otto Cadwallader Evans, Jr.
Mining Engr. Vice-Pres. & Gen. Mgr.
424 Wyoming Ave., Scranton, Pa.
Date 2/16/40 Scale 1" - 100'