


- Albert Little

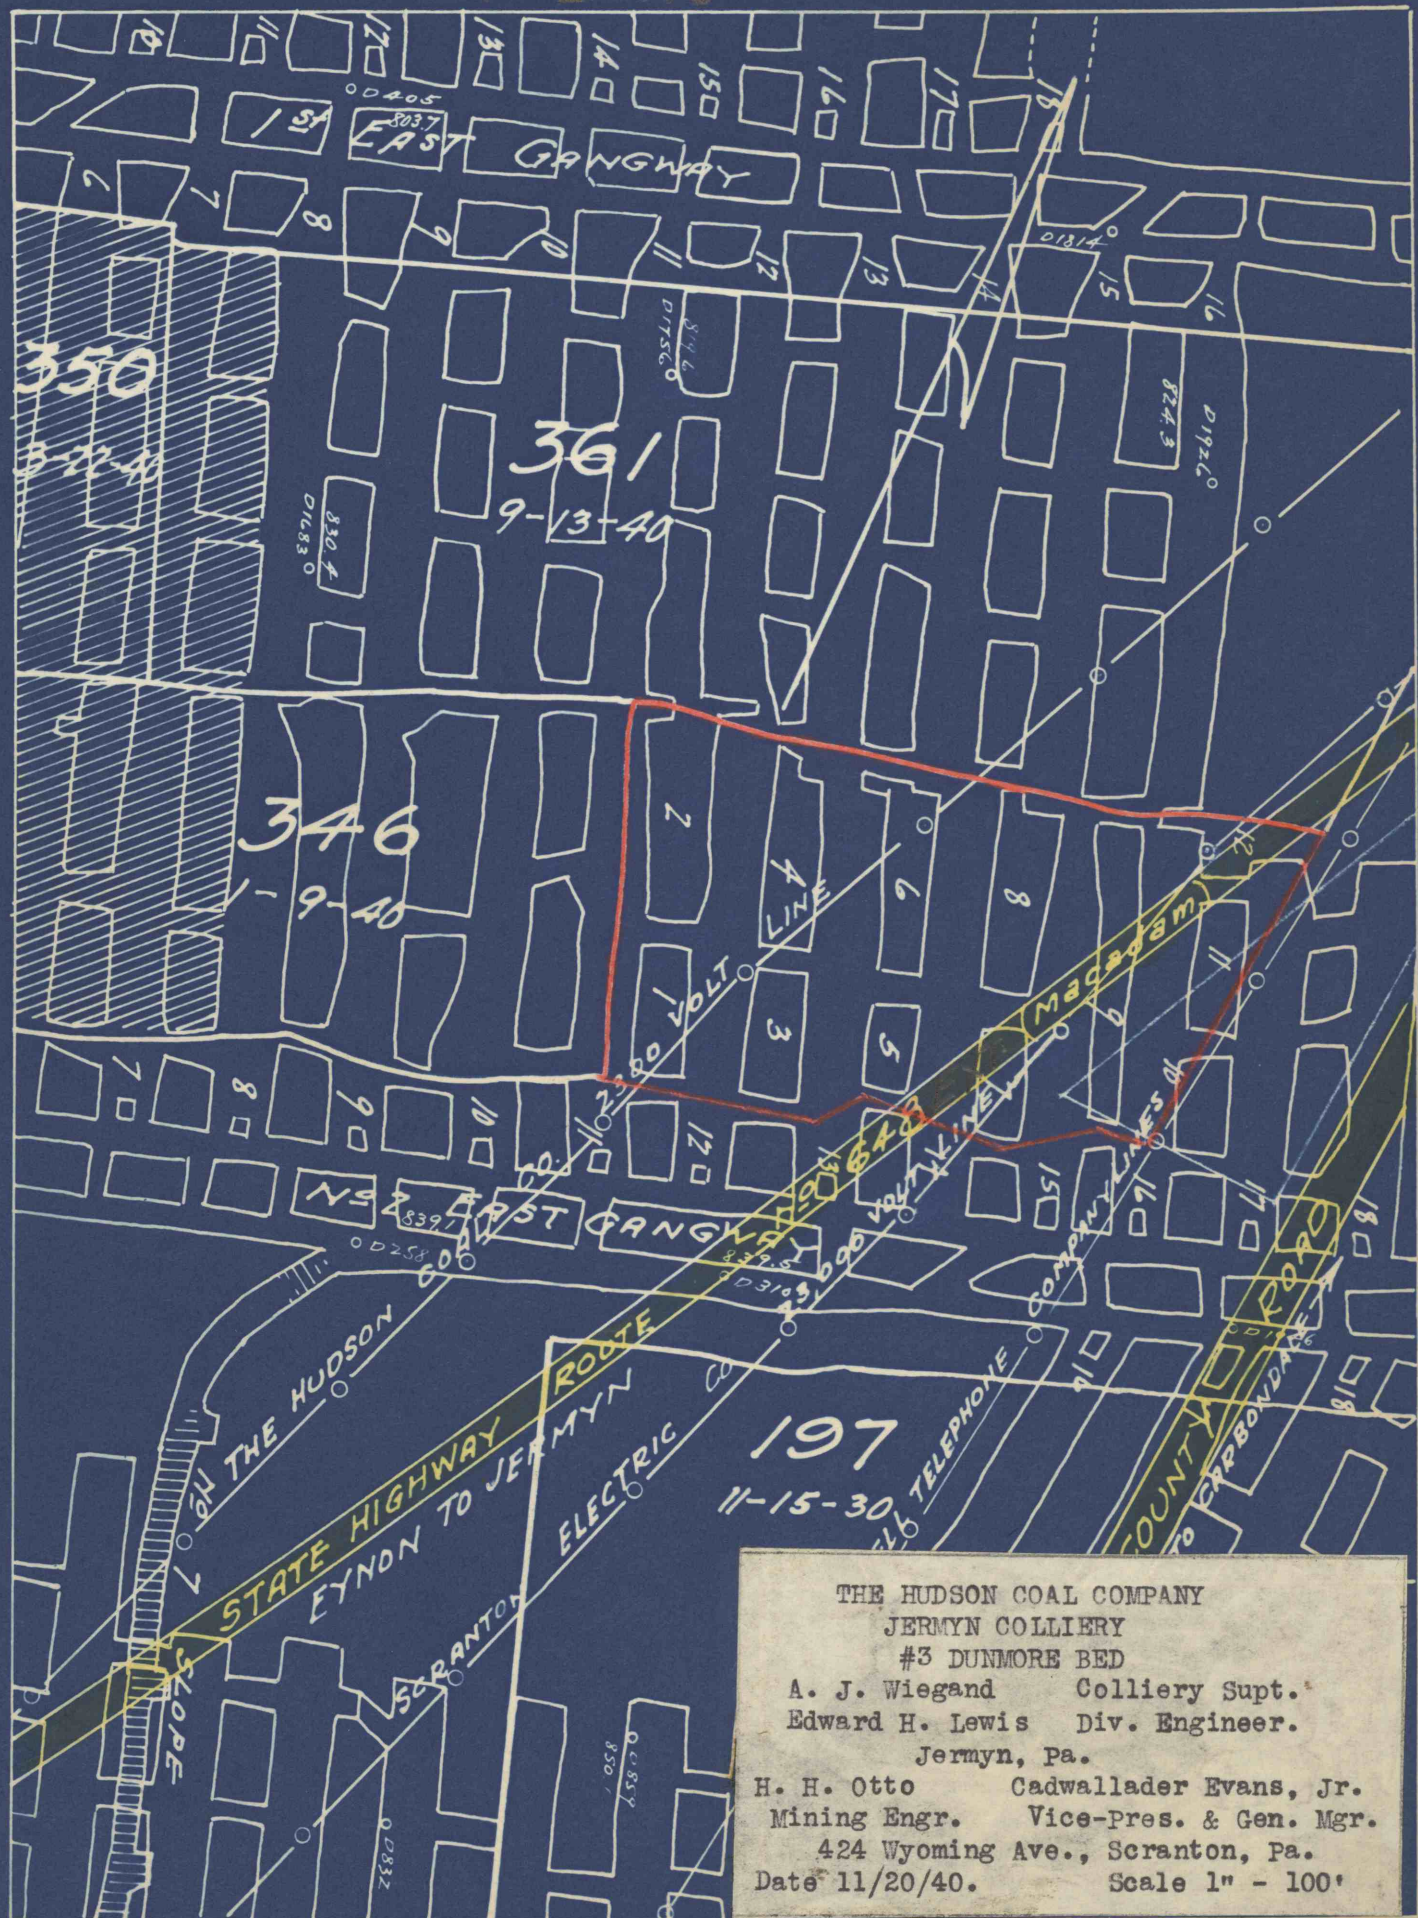

THE HUDSON COAL COMPANY
 JERMYN COLLIERY
 #3 DUNMORE BED
 A. J. Wiegand Colliery Supt.
 Edward H. Lewis Div. Engineer.
 Jermyn, Pa.
 H. H. Otto Cadwallader Evans, Jr.
 Mining Engr. Vice-Pres. & Gen. Mgr.
 424 Wyoming Ave., Scranton, Pa.
 Date 11/20/40. Scale 1" - 100'