


ARCHBALD

BORO.

COAL & IRON Co.
NORTHWEST COAL Co

STA. 130+00

HUDSON COAL Co.

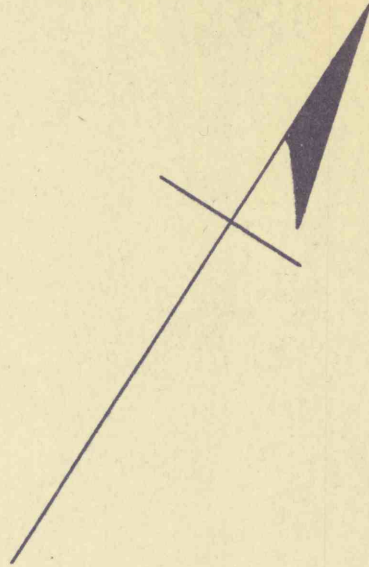

← To BLAKELY


ROUTE 648 EXT.

To JERMYN →

EAST EDGE OF FORMER SUBSIDENCE
5-26-47
STA. 129+50

FLK HILL

ABOUT 400'

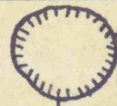

SUBSIDENCE
8' DIA.
3' DEEP

133+50

ROUTE 648 EXTENSION

ARCHBALD BOROUGH

LACKAWANNA COUNTY

OVER WORKINGS OF HUDSON COAL Co.

SKETCH:- DO NOT SCALE

P.D.H. SCRANTON, PA. FEB. 17, 1950 T.F.S.