

4


ARCHBALD

BORO.

COAL & IRON CO.  
NORTHWEST COAL CO.

HUDSON COAL Co.

STA. 130+00

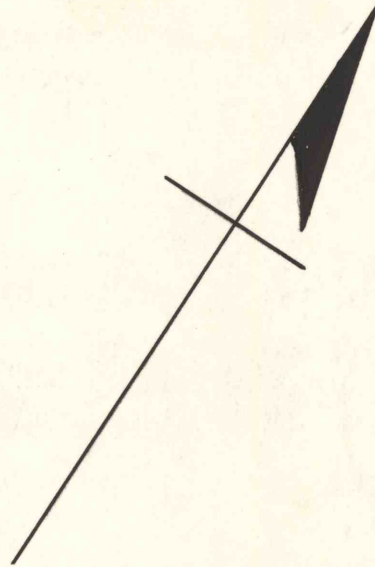

← TO BLAKELY


ROUTE 648 EXT.

TO JERMYN →

EAST EDGE OF FORMER SUBSIDENCE  
STA. 129+50

FLK HILL

ABOUT 400'

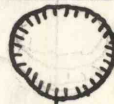

SUBSIDENCE  
8' DIA.  
3' DEEP

133+50

ROUTE 648 EXTENSION

ARCHBALD BOROUGH

LACKAWANNA COUNTY

OVER WORKINGS OF HUDSON COAL Co.

SKETCH:- DO NOT SCALE

P.D.H. SCRANTON, PA. FEB. 17, 1950 T.F.S.