


State Highway Route No. 648 EXT

CORP 276

ROUTE 79648 SURFACE ELEV. 974.0

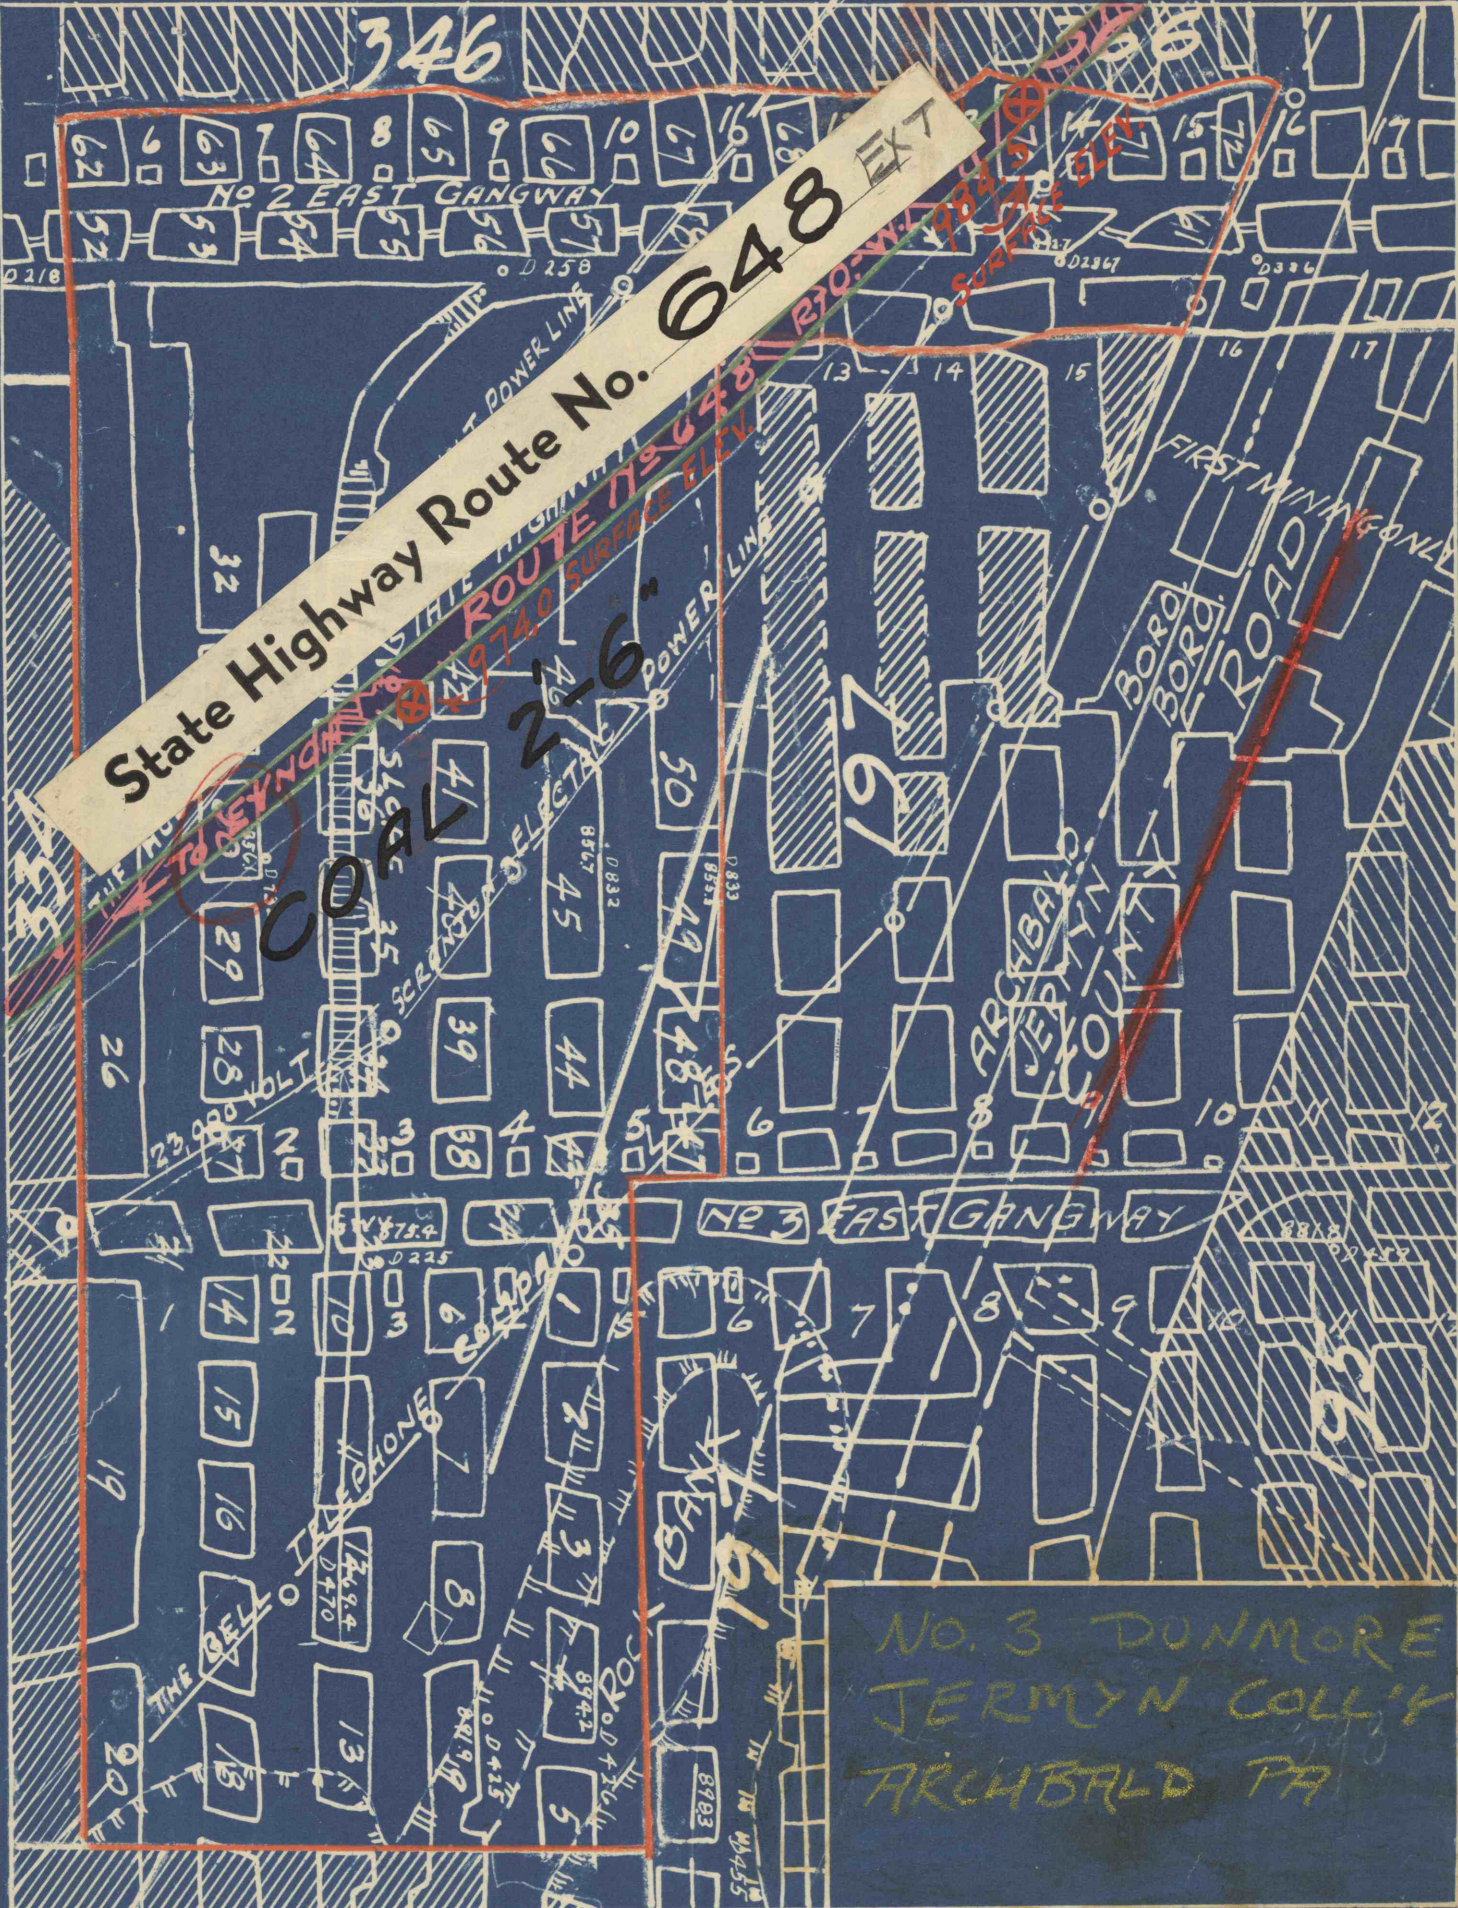

NO. 3 DUNMORE
JERMYN COLLIER
ARCHBOLD PA