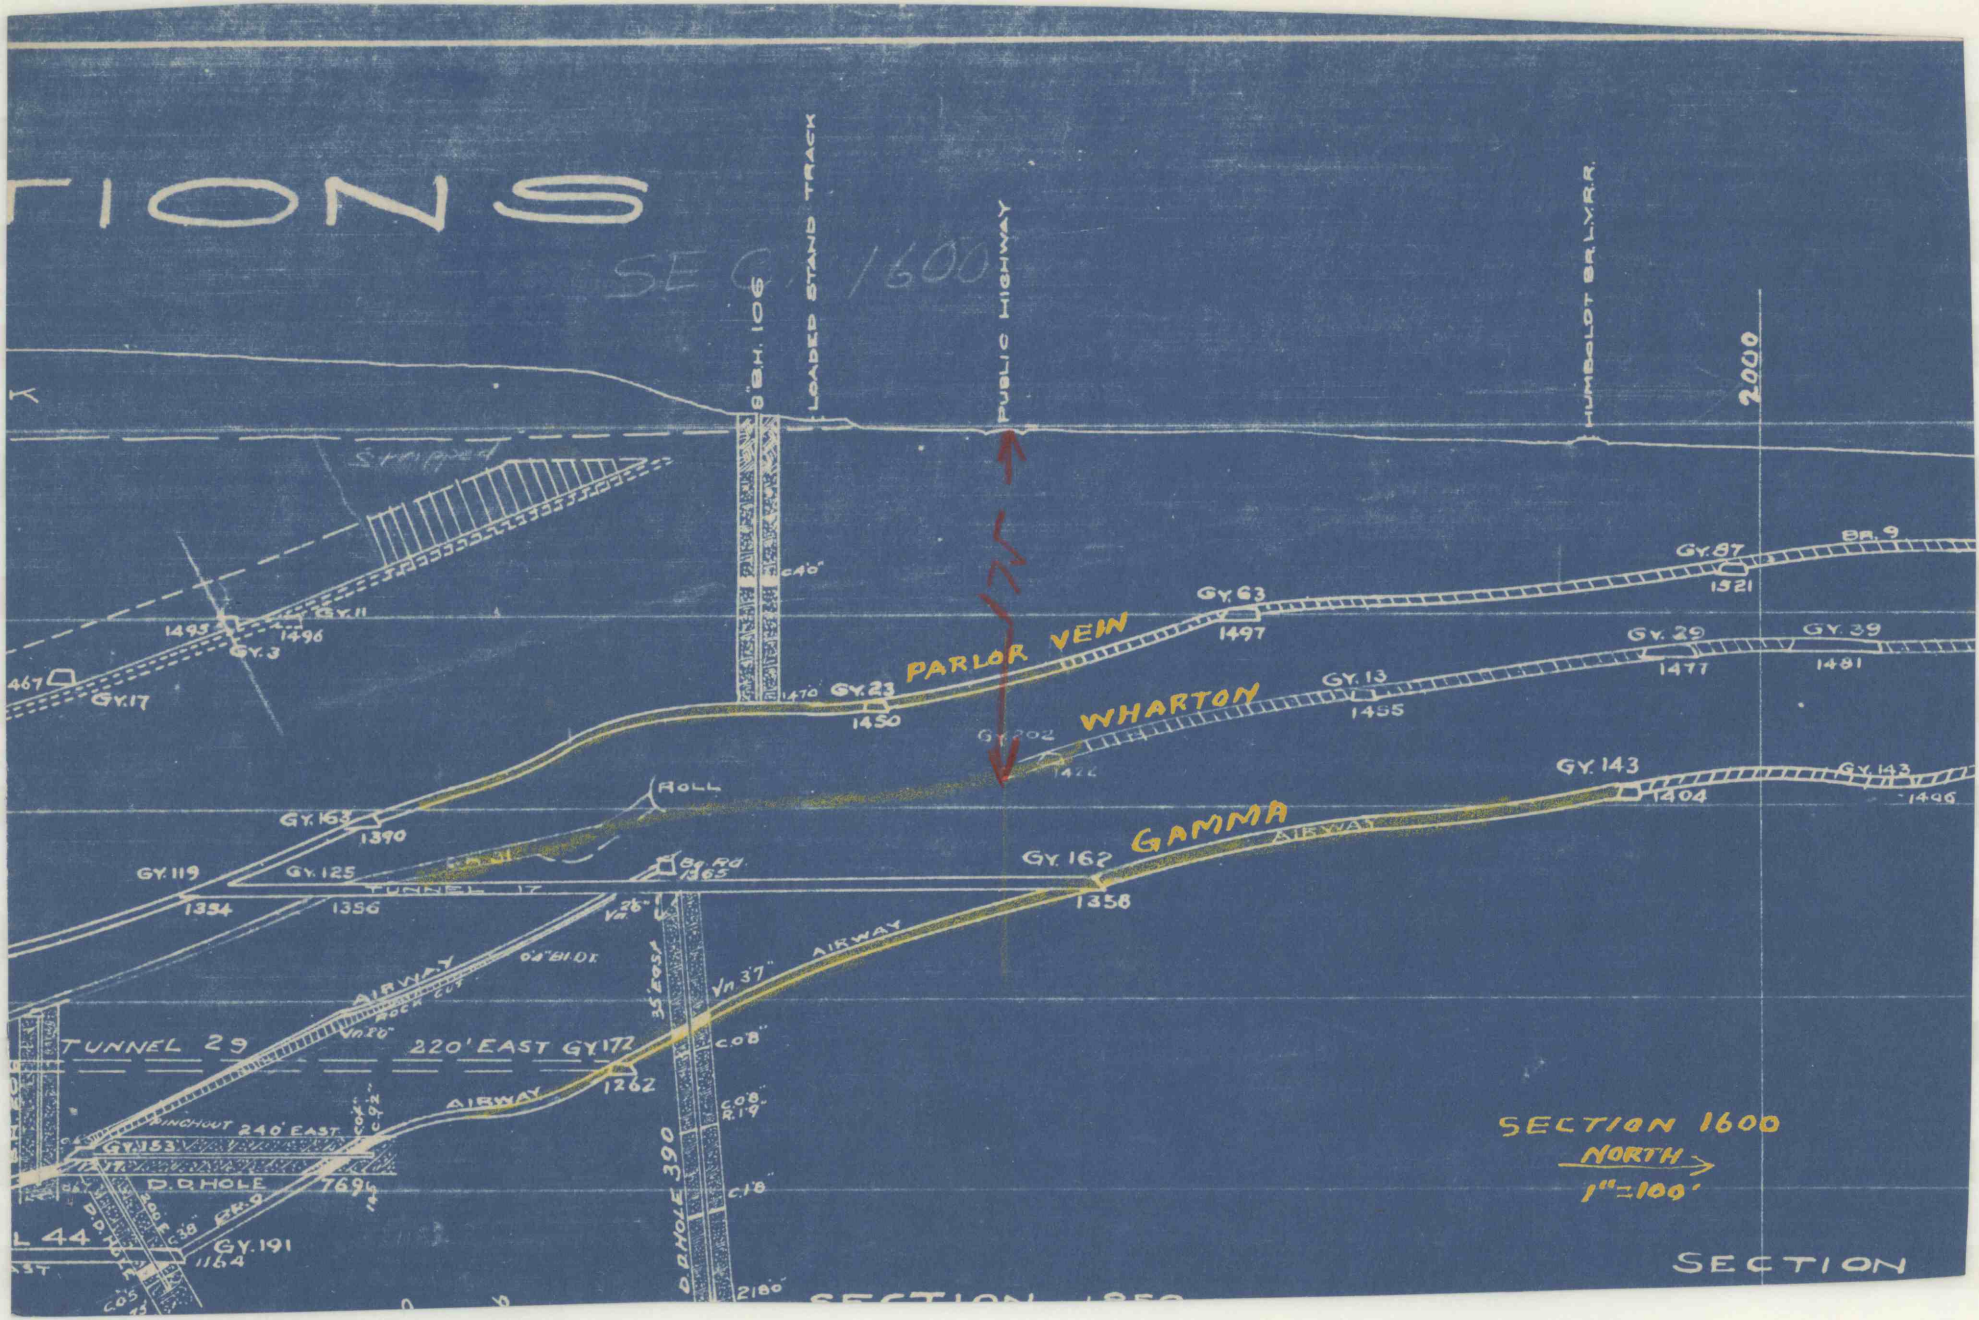

TIONS
SEC. 1600
8" B.H. 106
LOADED STAND TRACK
PUBLIC HIGHWAY
HUMBOLDT BR. L.Y.R.R.
2000
Stripped
PARLOR VEIN
WHARTON
GAMMA
GY. 87
1521
BR. 9
GY. 63
1497
GY. 29
1477
GY. 39
1481
GY. 13
1455
GY. 202
GY. 23
1450
GY. 11
1495
1496
GY. 3
GY. 17
GY. 163
1390
GY. 119
1354
GY. 125
1356
ROLL
TUNNEL 17
GY. 162
1358
GY. 143
1404
GY. 143
1406
AIRWAY
TUNNEL 29
220' EAST GY. 172
1262
PINCHOUT 240' EAST
GY. 153
D.D. HOLE
GY. 191
1164
D.D. HOLE 390
SECTION 1600
NORTH
1" = 100'
SECTION