


2700

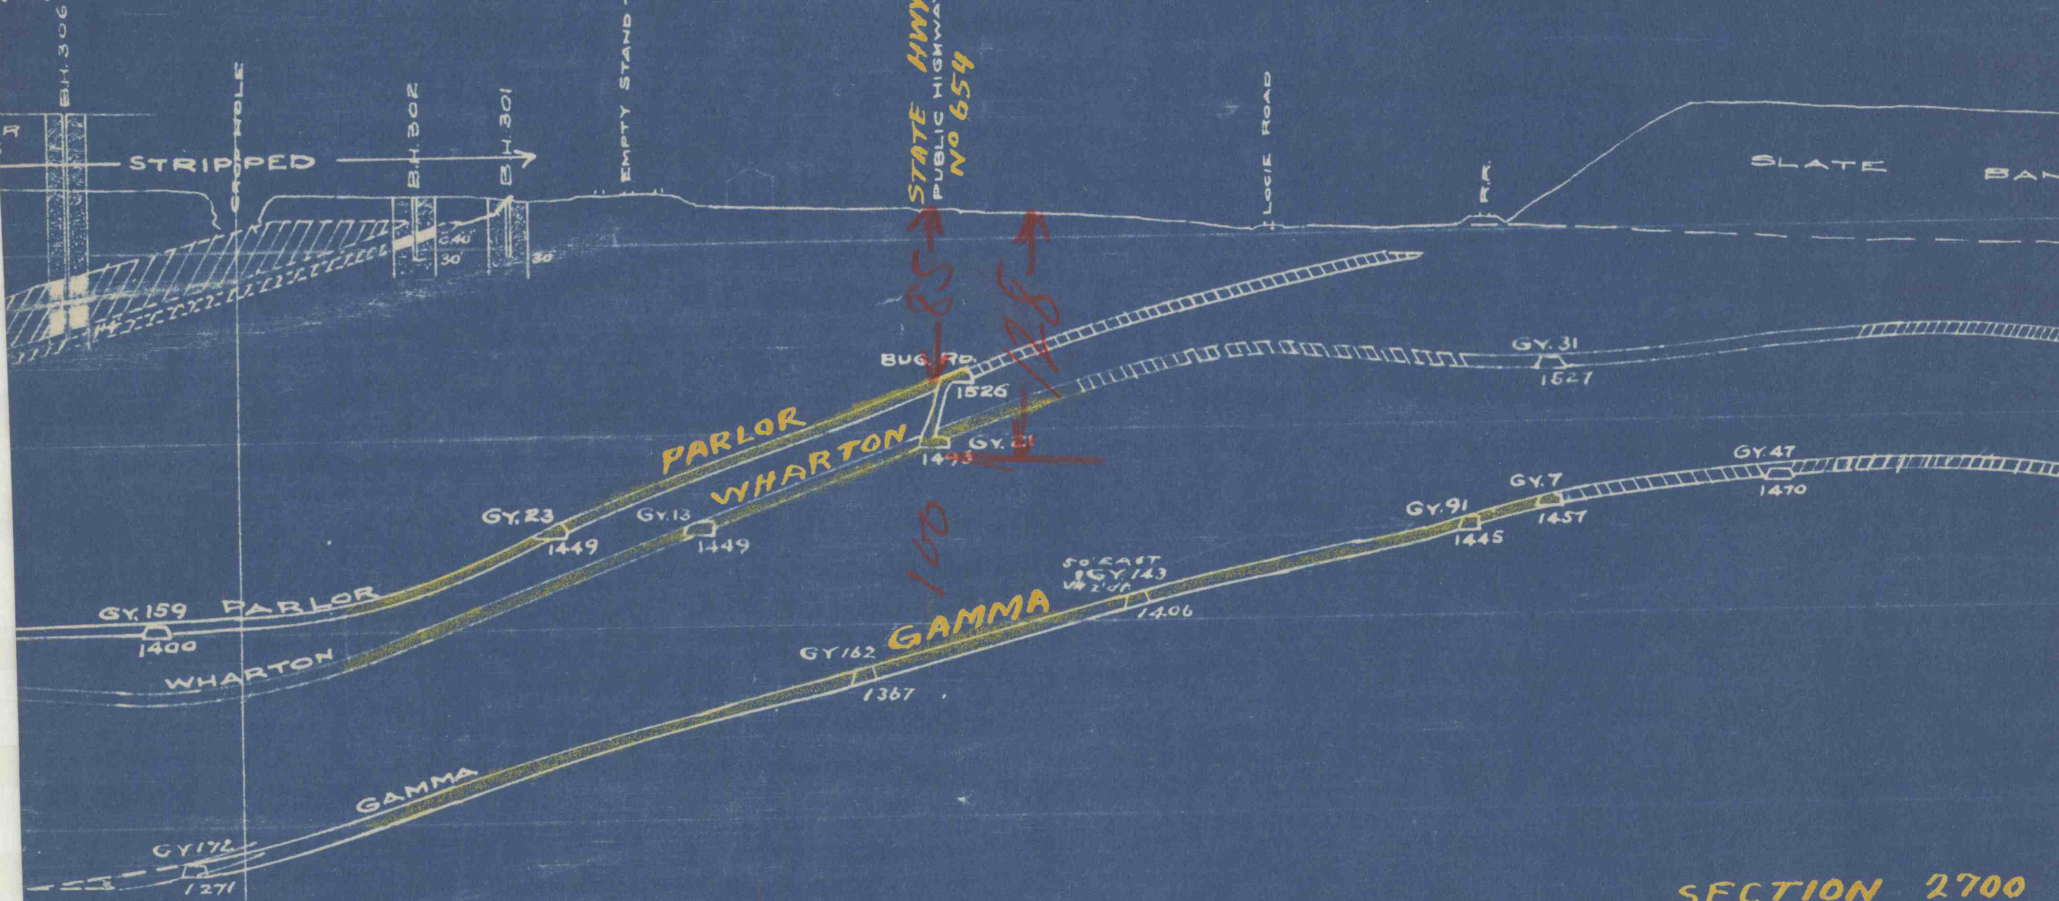

SECTION 2700

NORTH →

1"=100'