SEC. 3800

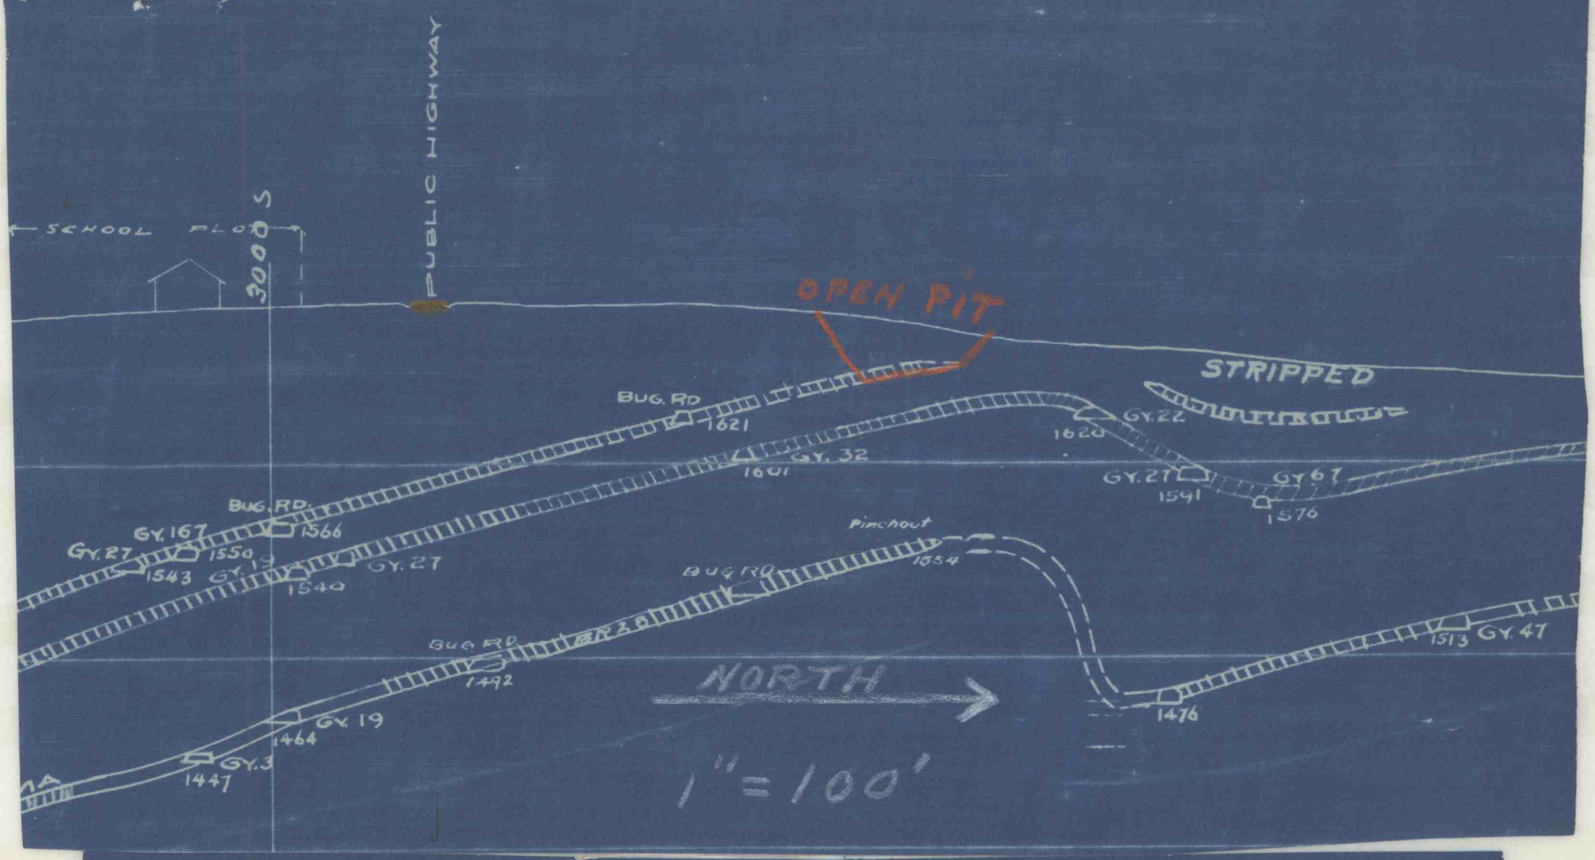

SEC 4300

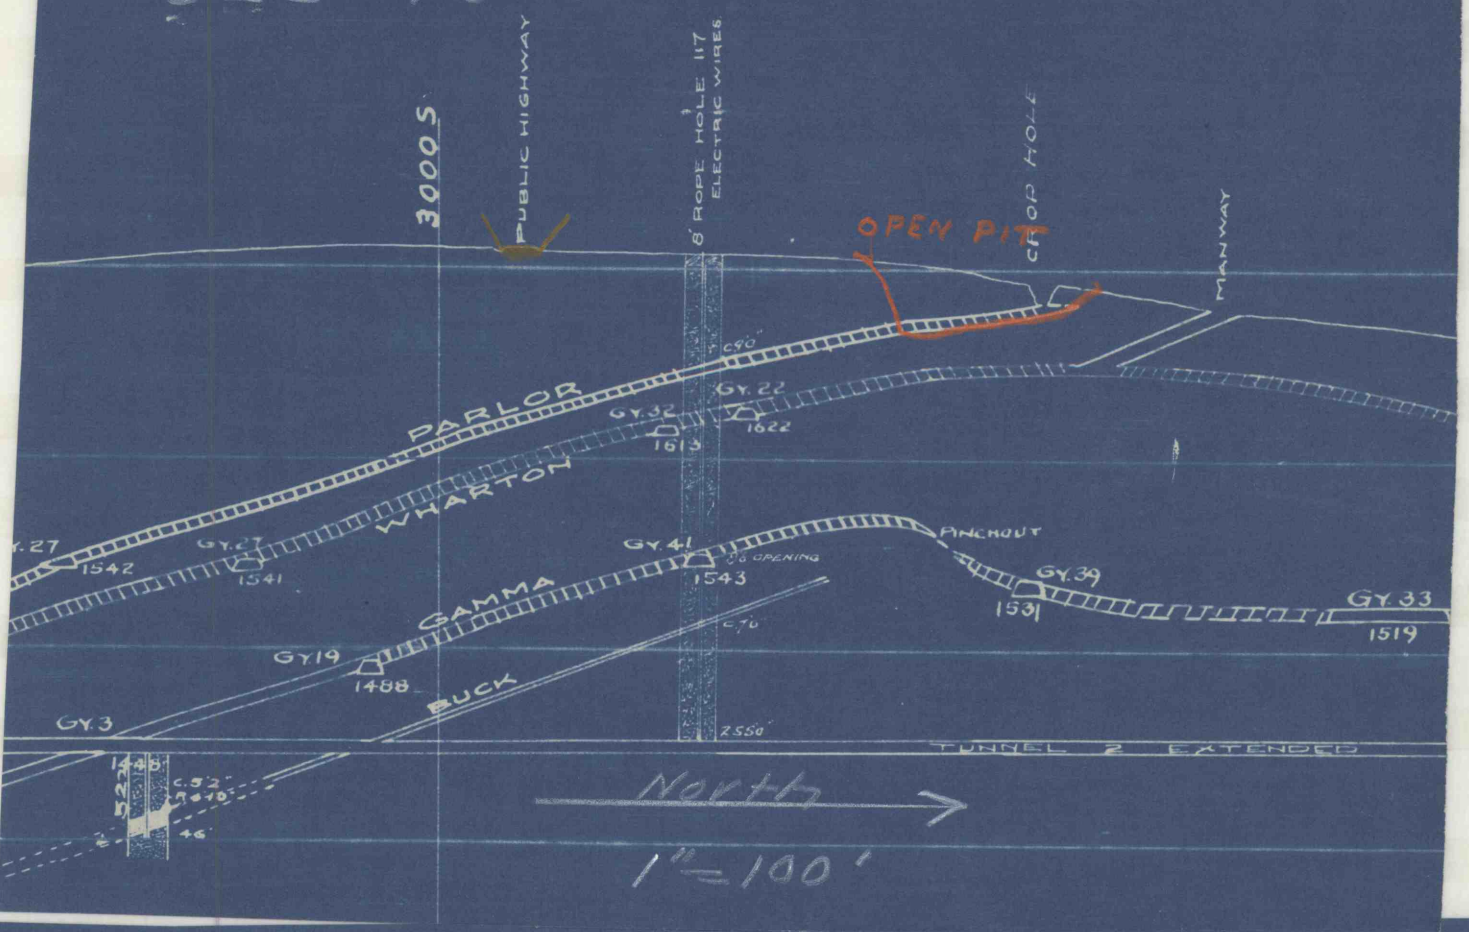
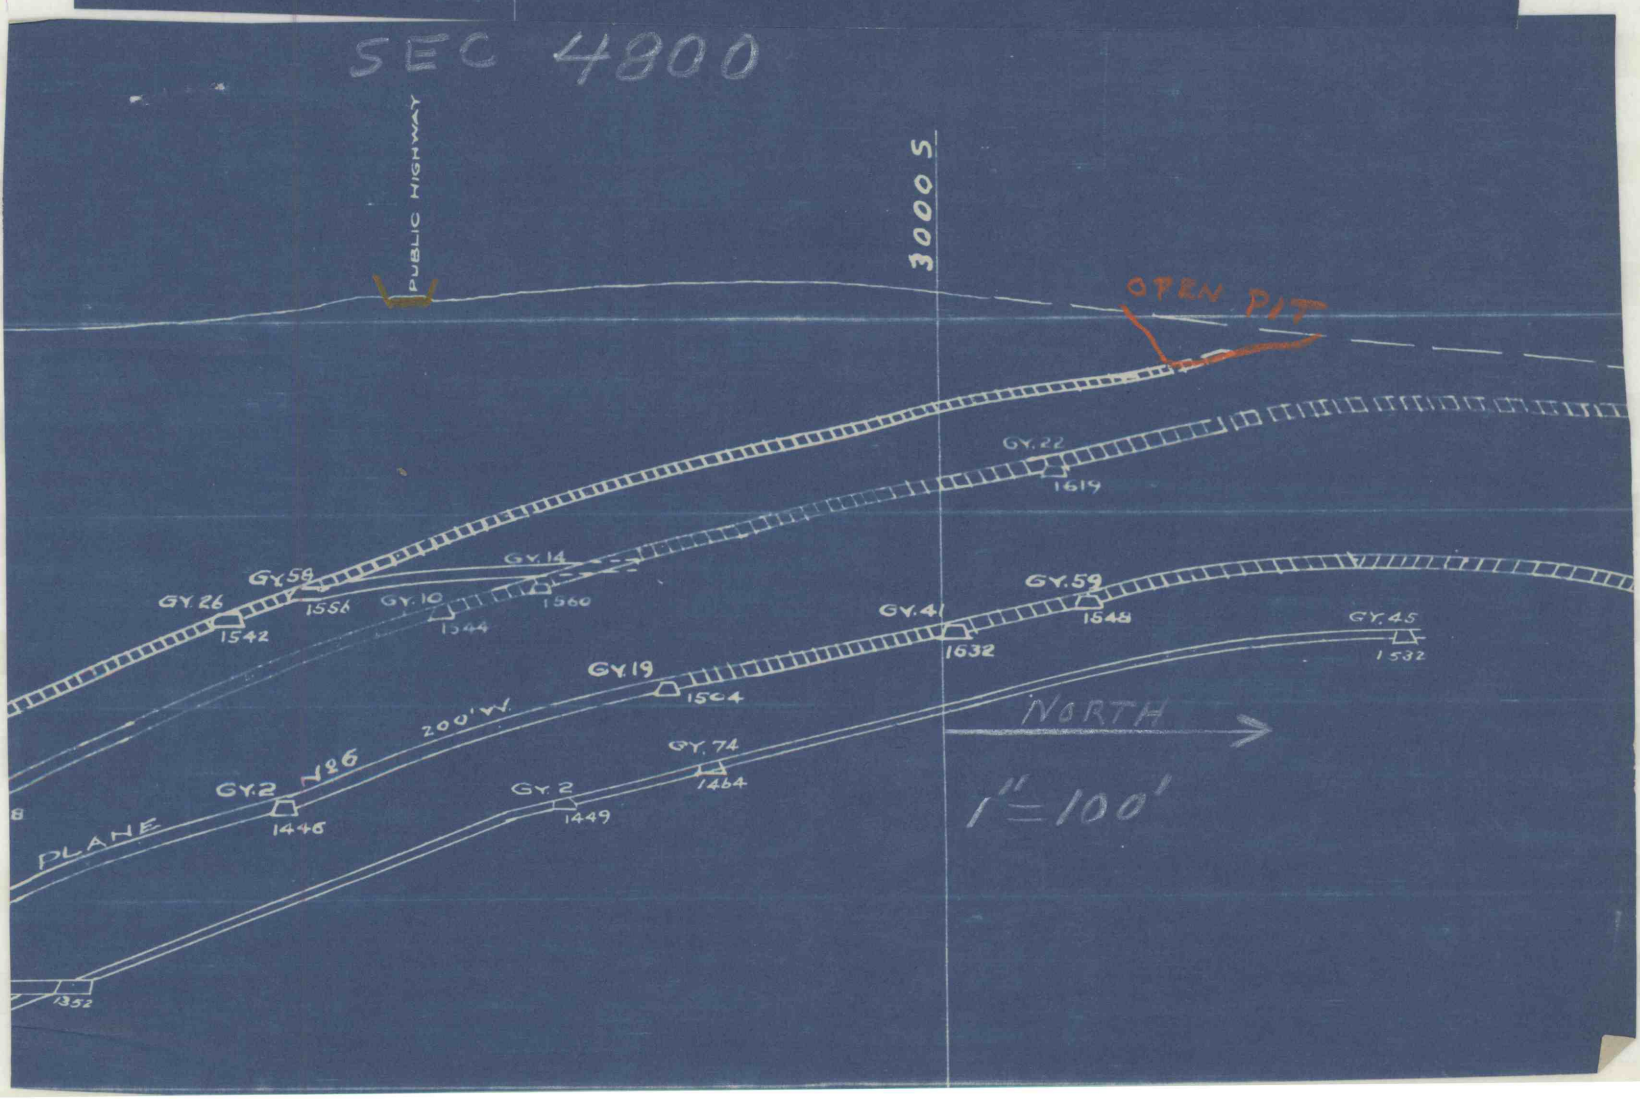
SEC 4800