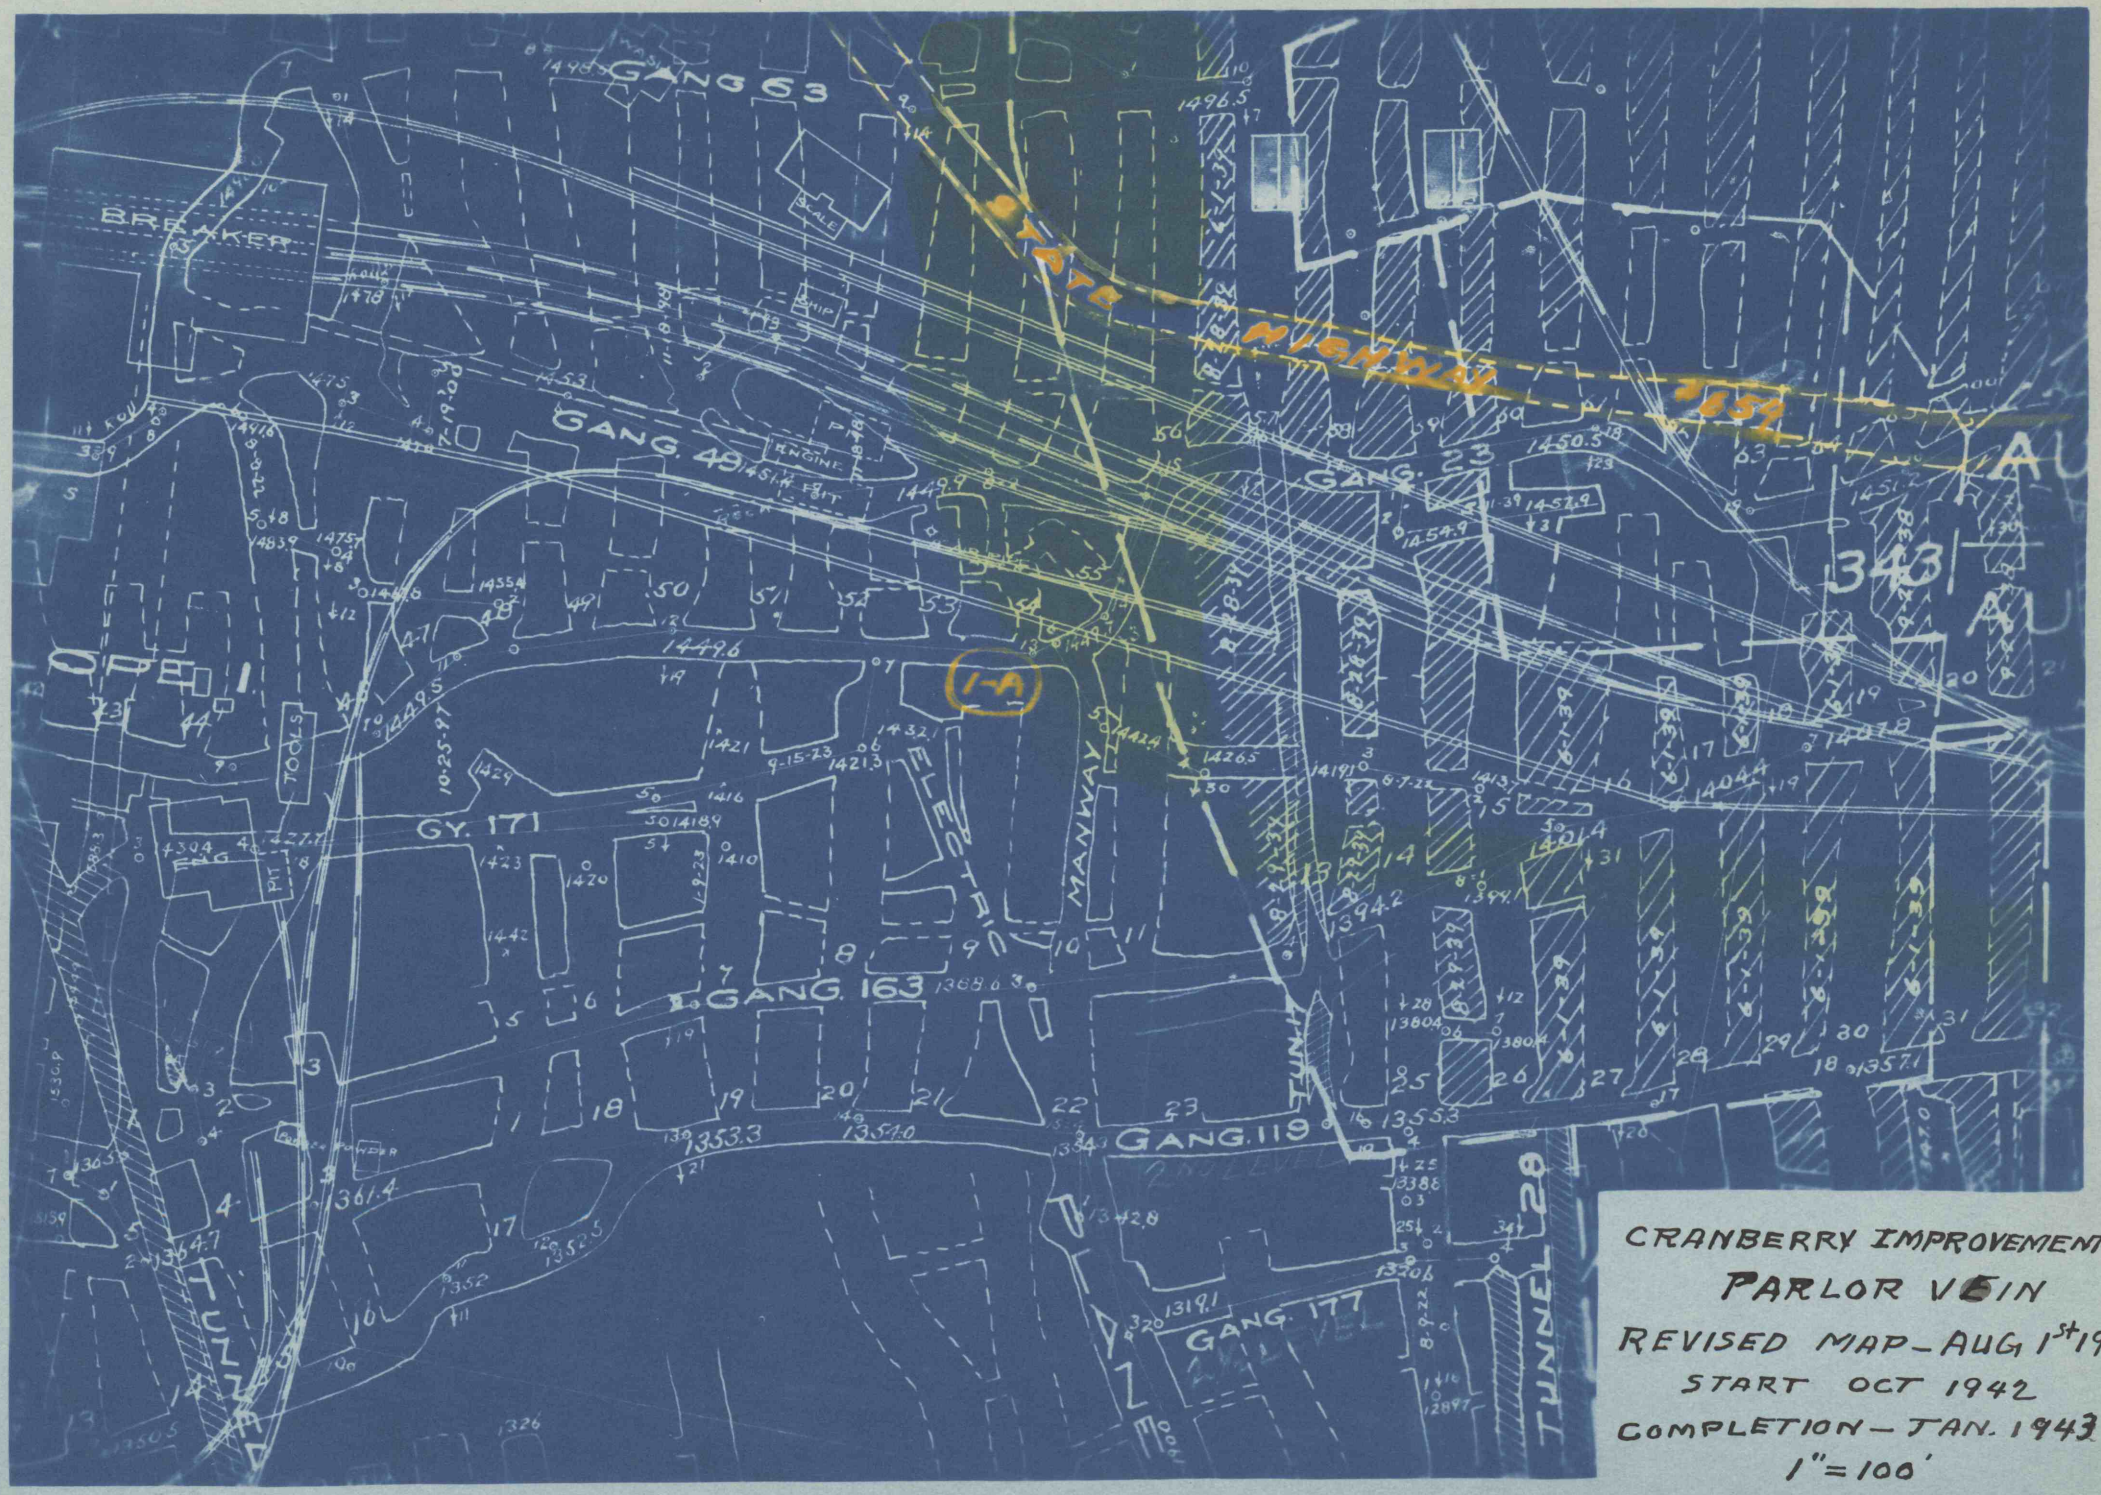

CRANBERRY IMPROVEMENT CO

PARLOR VEIN

REVISED MAP - AUG 1st 1942

START OCT 1942

COMPLETION - JAN. 1943

1" = 100'