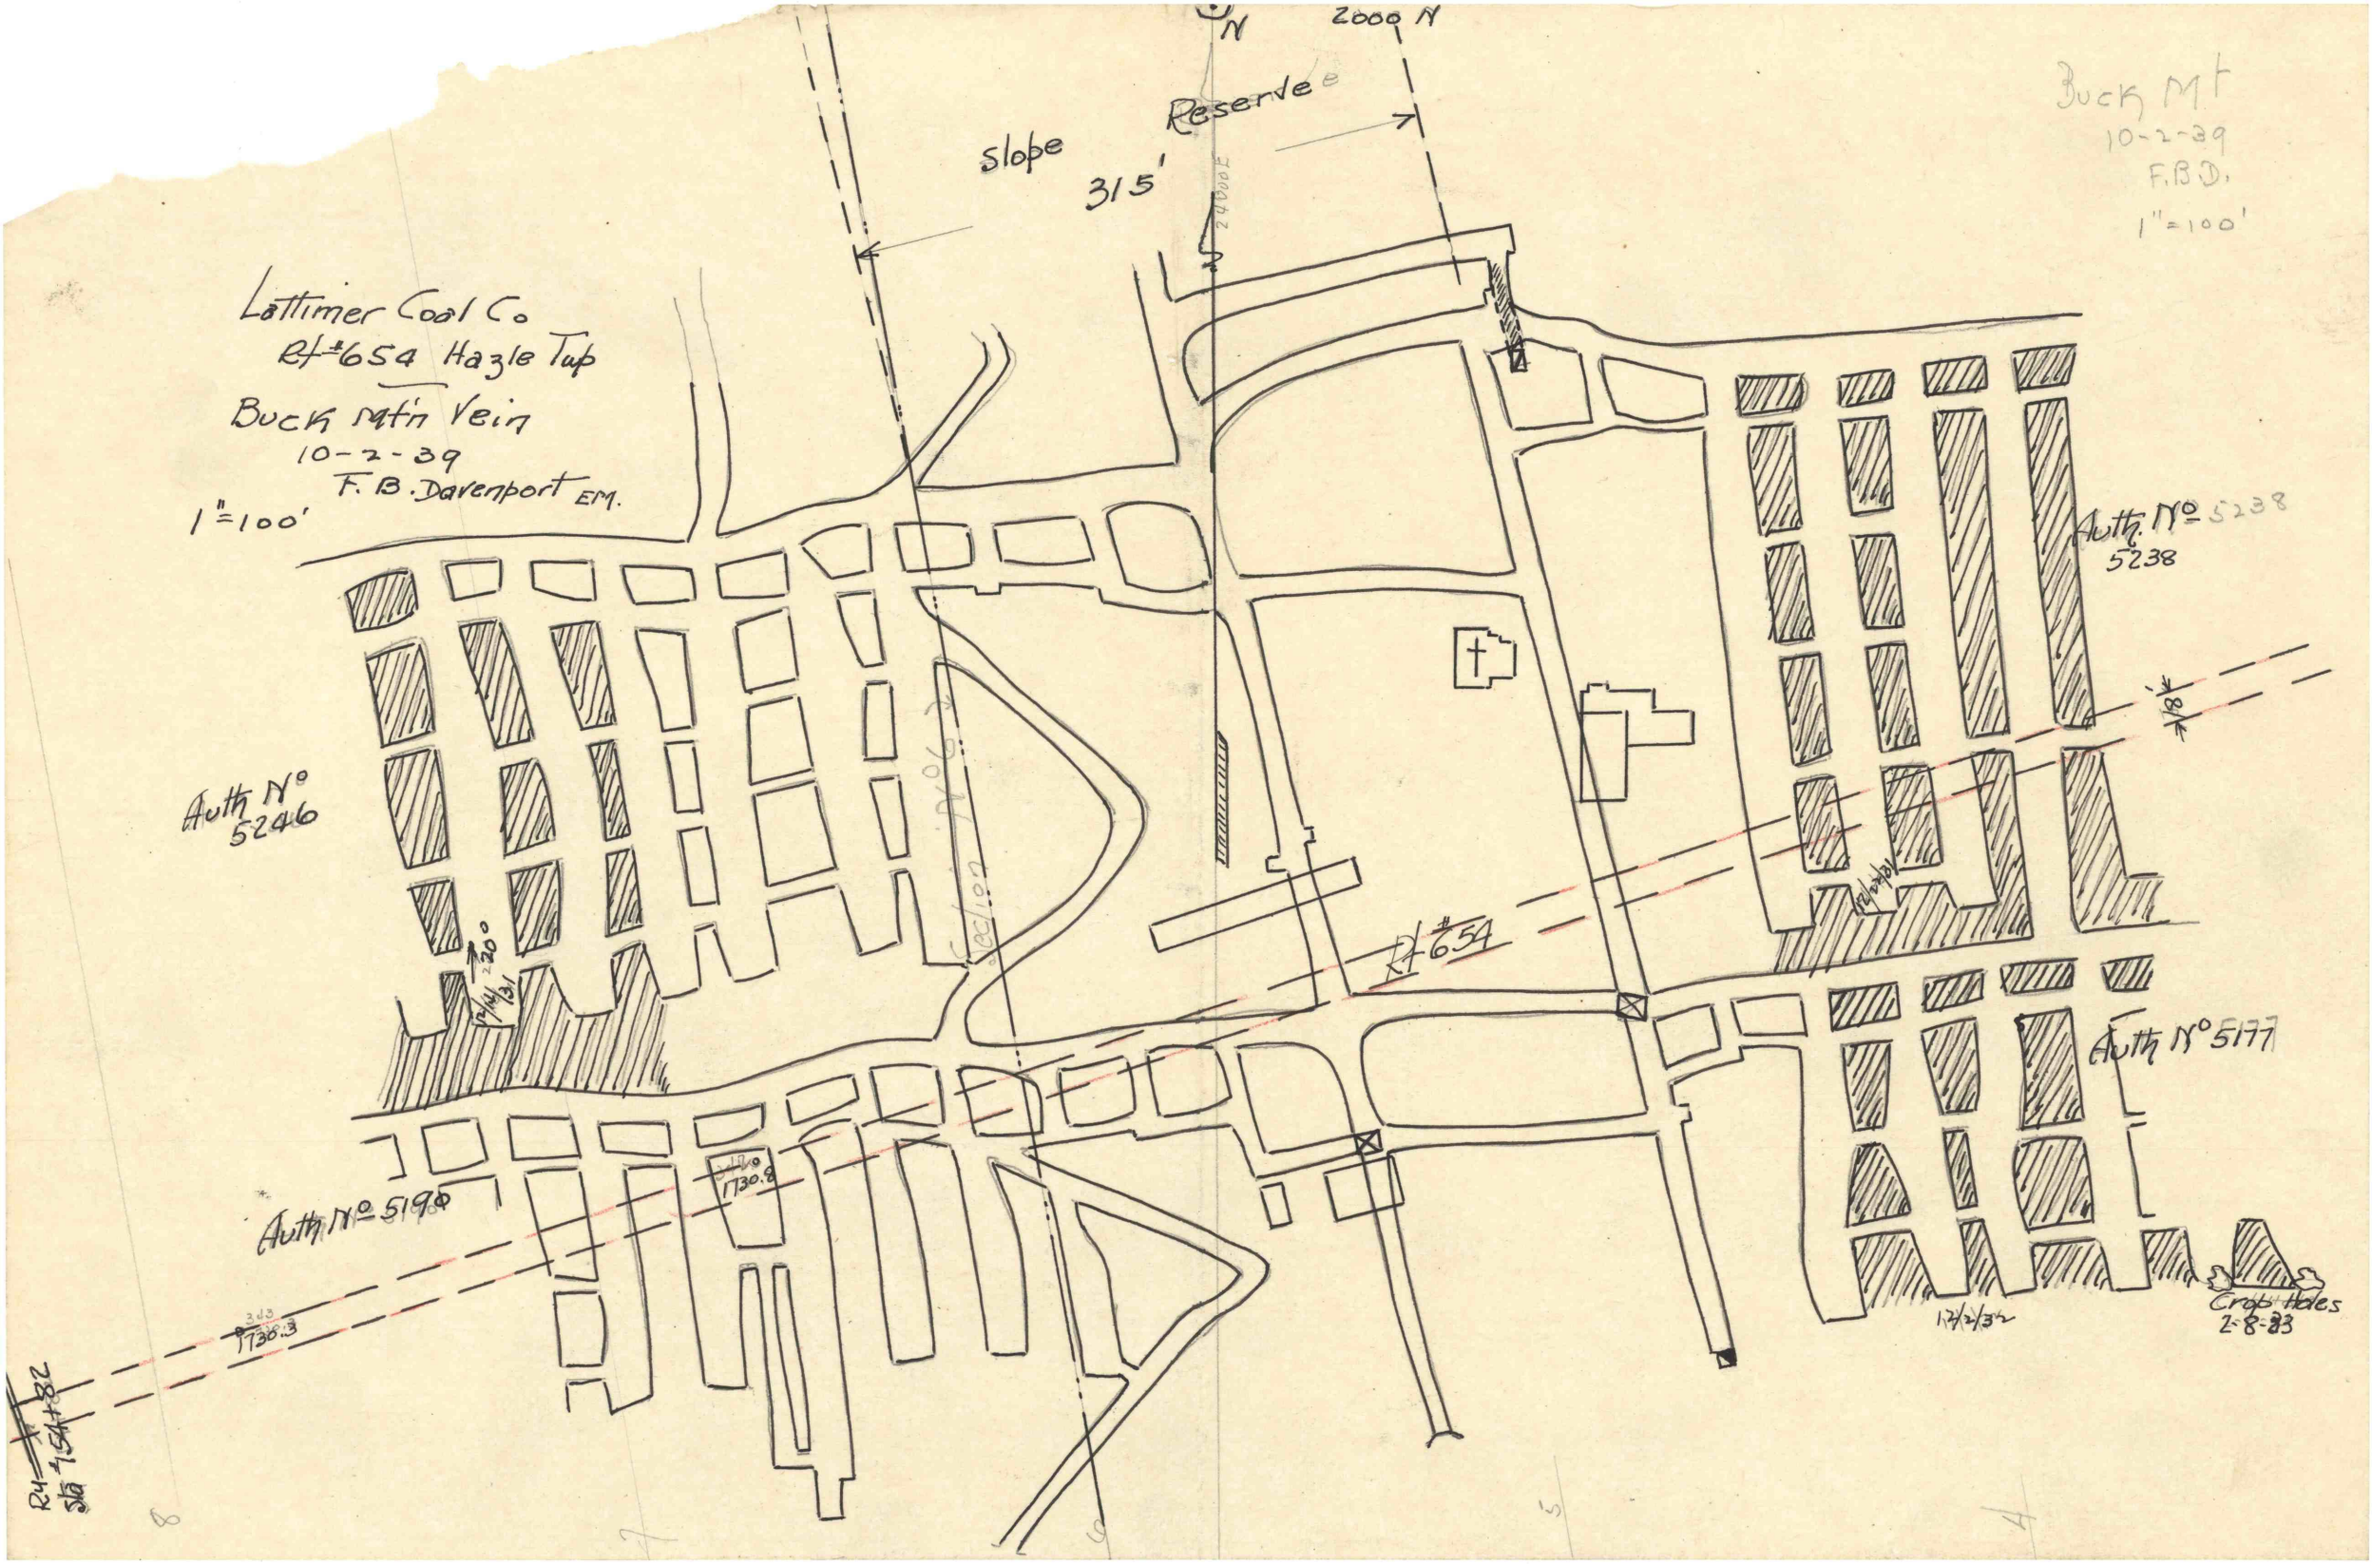
Buck Mt
10-2-39
F.B.D.
1"=100'
Lattimer Coal Co
Rt #654 Hazle Twp
Buck Mtn Vein
10-2-39
F. B. Davenport EM.
1"=100'
2000 N
Reserve
Slope
315'
Auth N° 5238
Auth N° 5246
Auth N° 5177
Auth N° 5190
Rt #654
Section
Crop Holes
2-8-33