


Section No 6  
Lattimer Coal Corp.

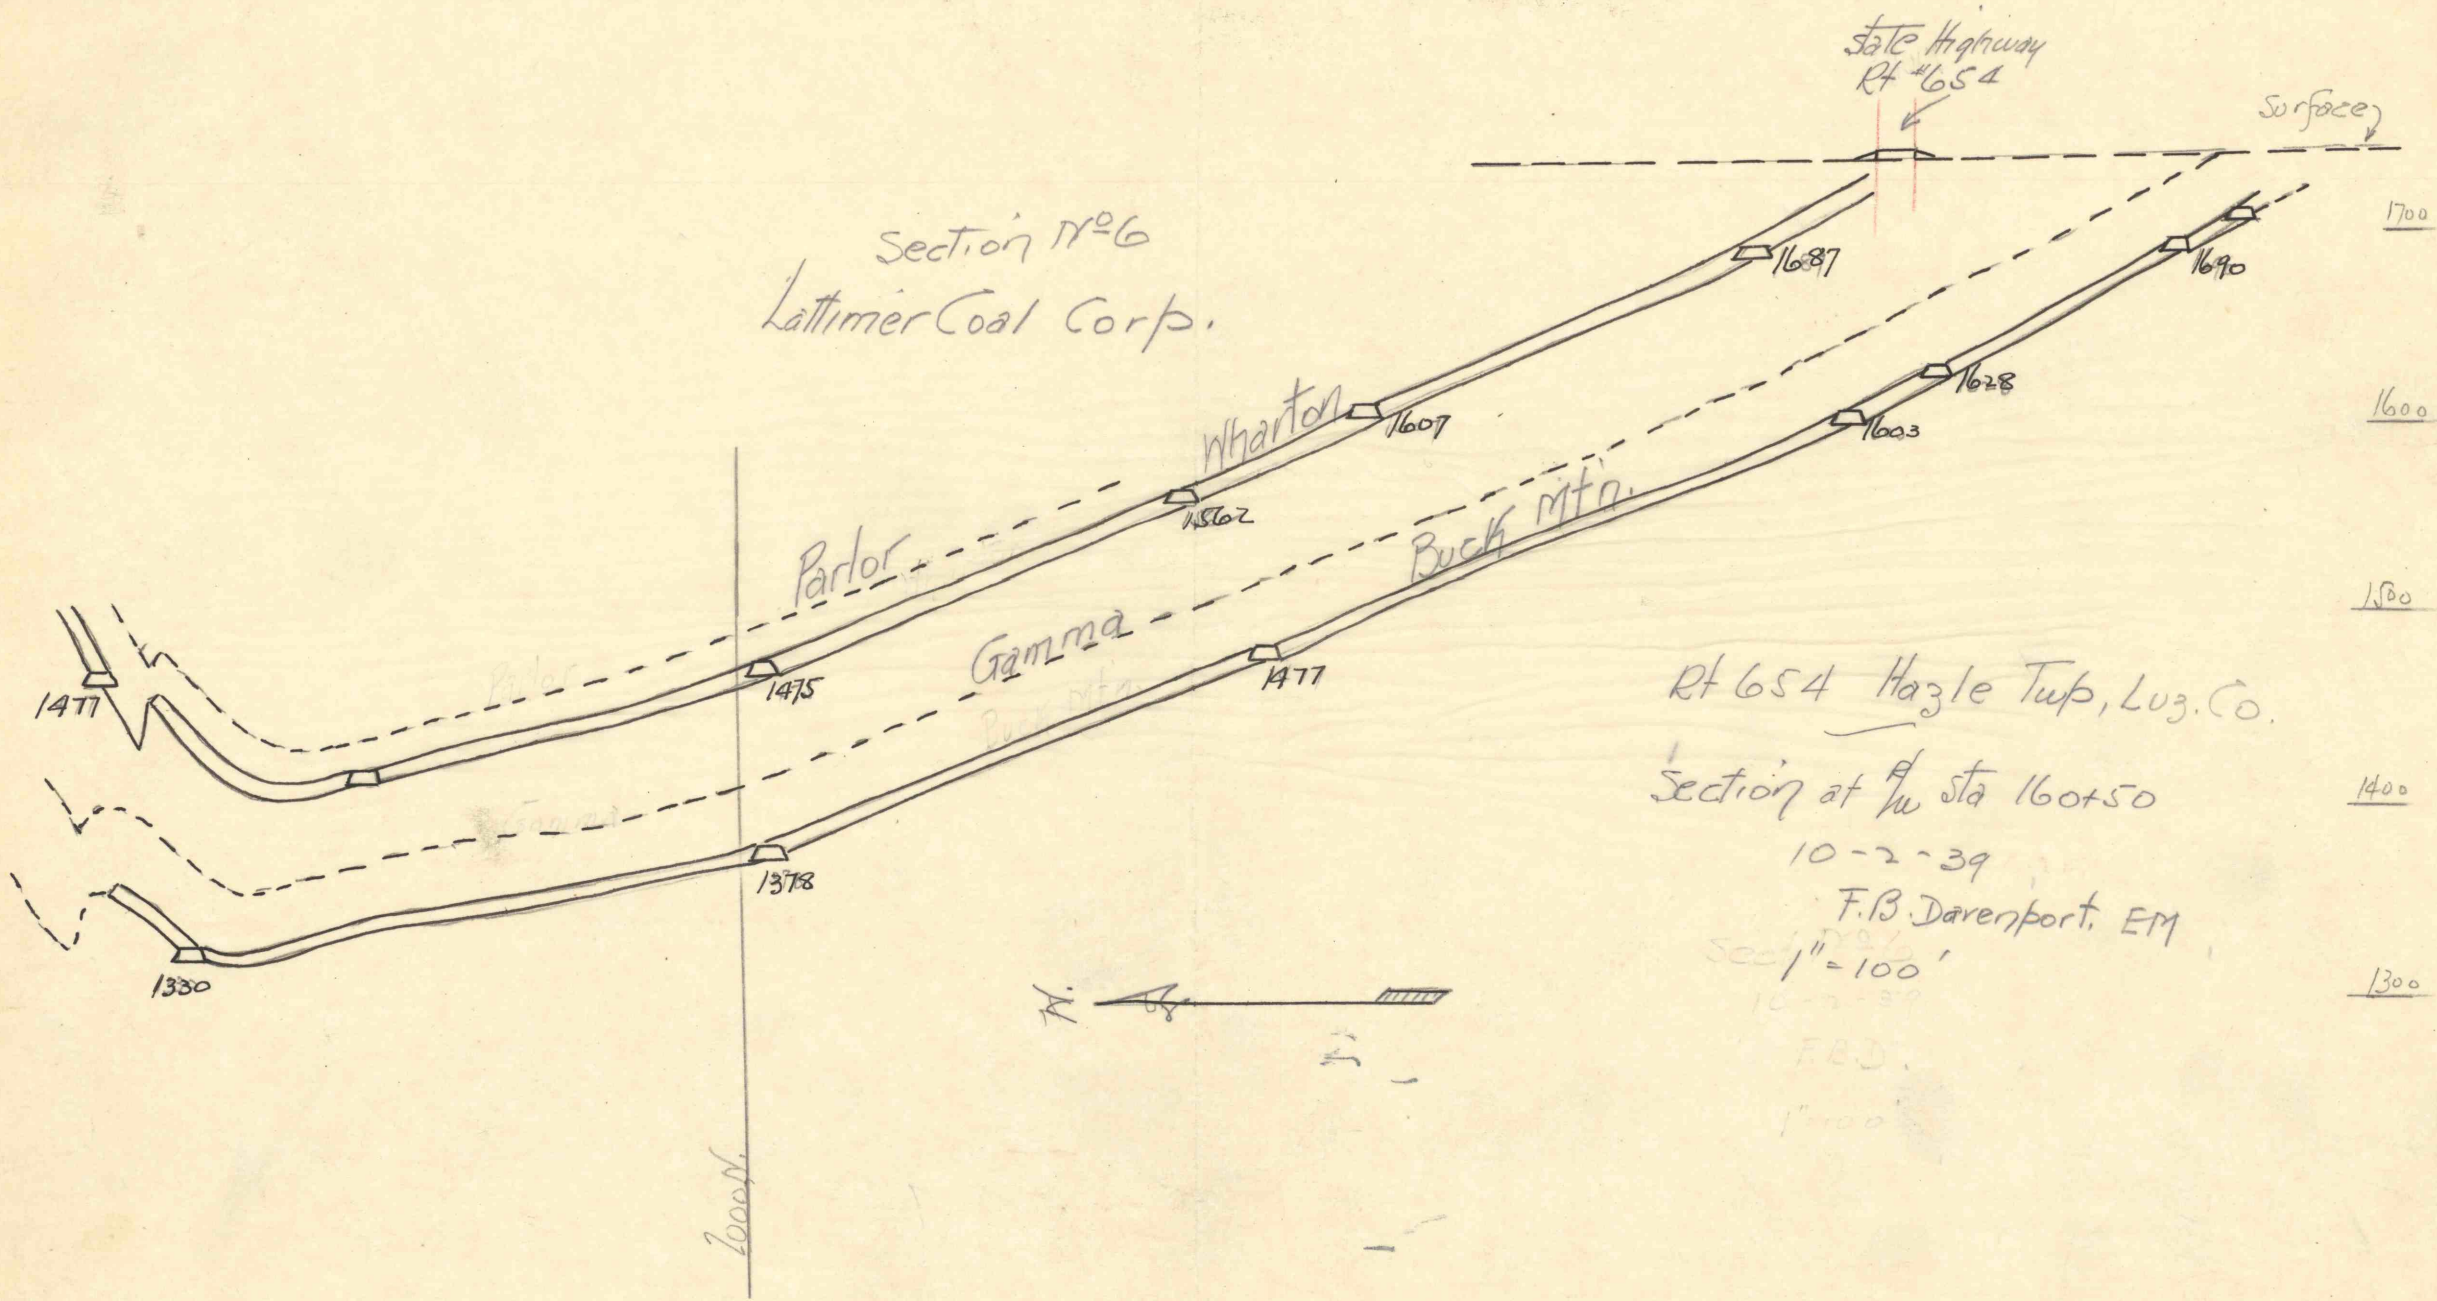

Rt 654 Hazle Twp, Luz. Co.  
Section at Sta 160+50  
10-2-39  
F.B. Davenport, EM  
Scale 1" = 100'  
10-2-39  
F.B.D.  
1" = 100'

