

14 13 12 11 10 9 8 7 6

HUMBOLDT COLLIERY
Lattimer Coal Corp. Lessee
Lattimer Mines Pa
Lehigh Valley Coal Co Lessor
Wilkes-Barre, Pa


G.M. Chisnell Mng Engr. T.J. PRICE Supr
Scale 1" = 100'

JOHN SITGREAVES
ROBERT SHAW

HOISTING ENGINE
NO 2 SLOPE

3000 N

SLOPE NO. 5

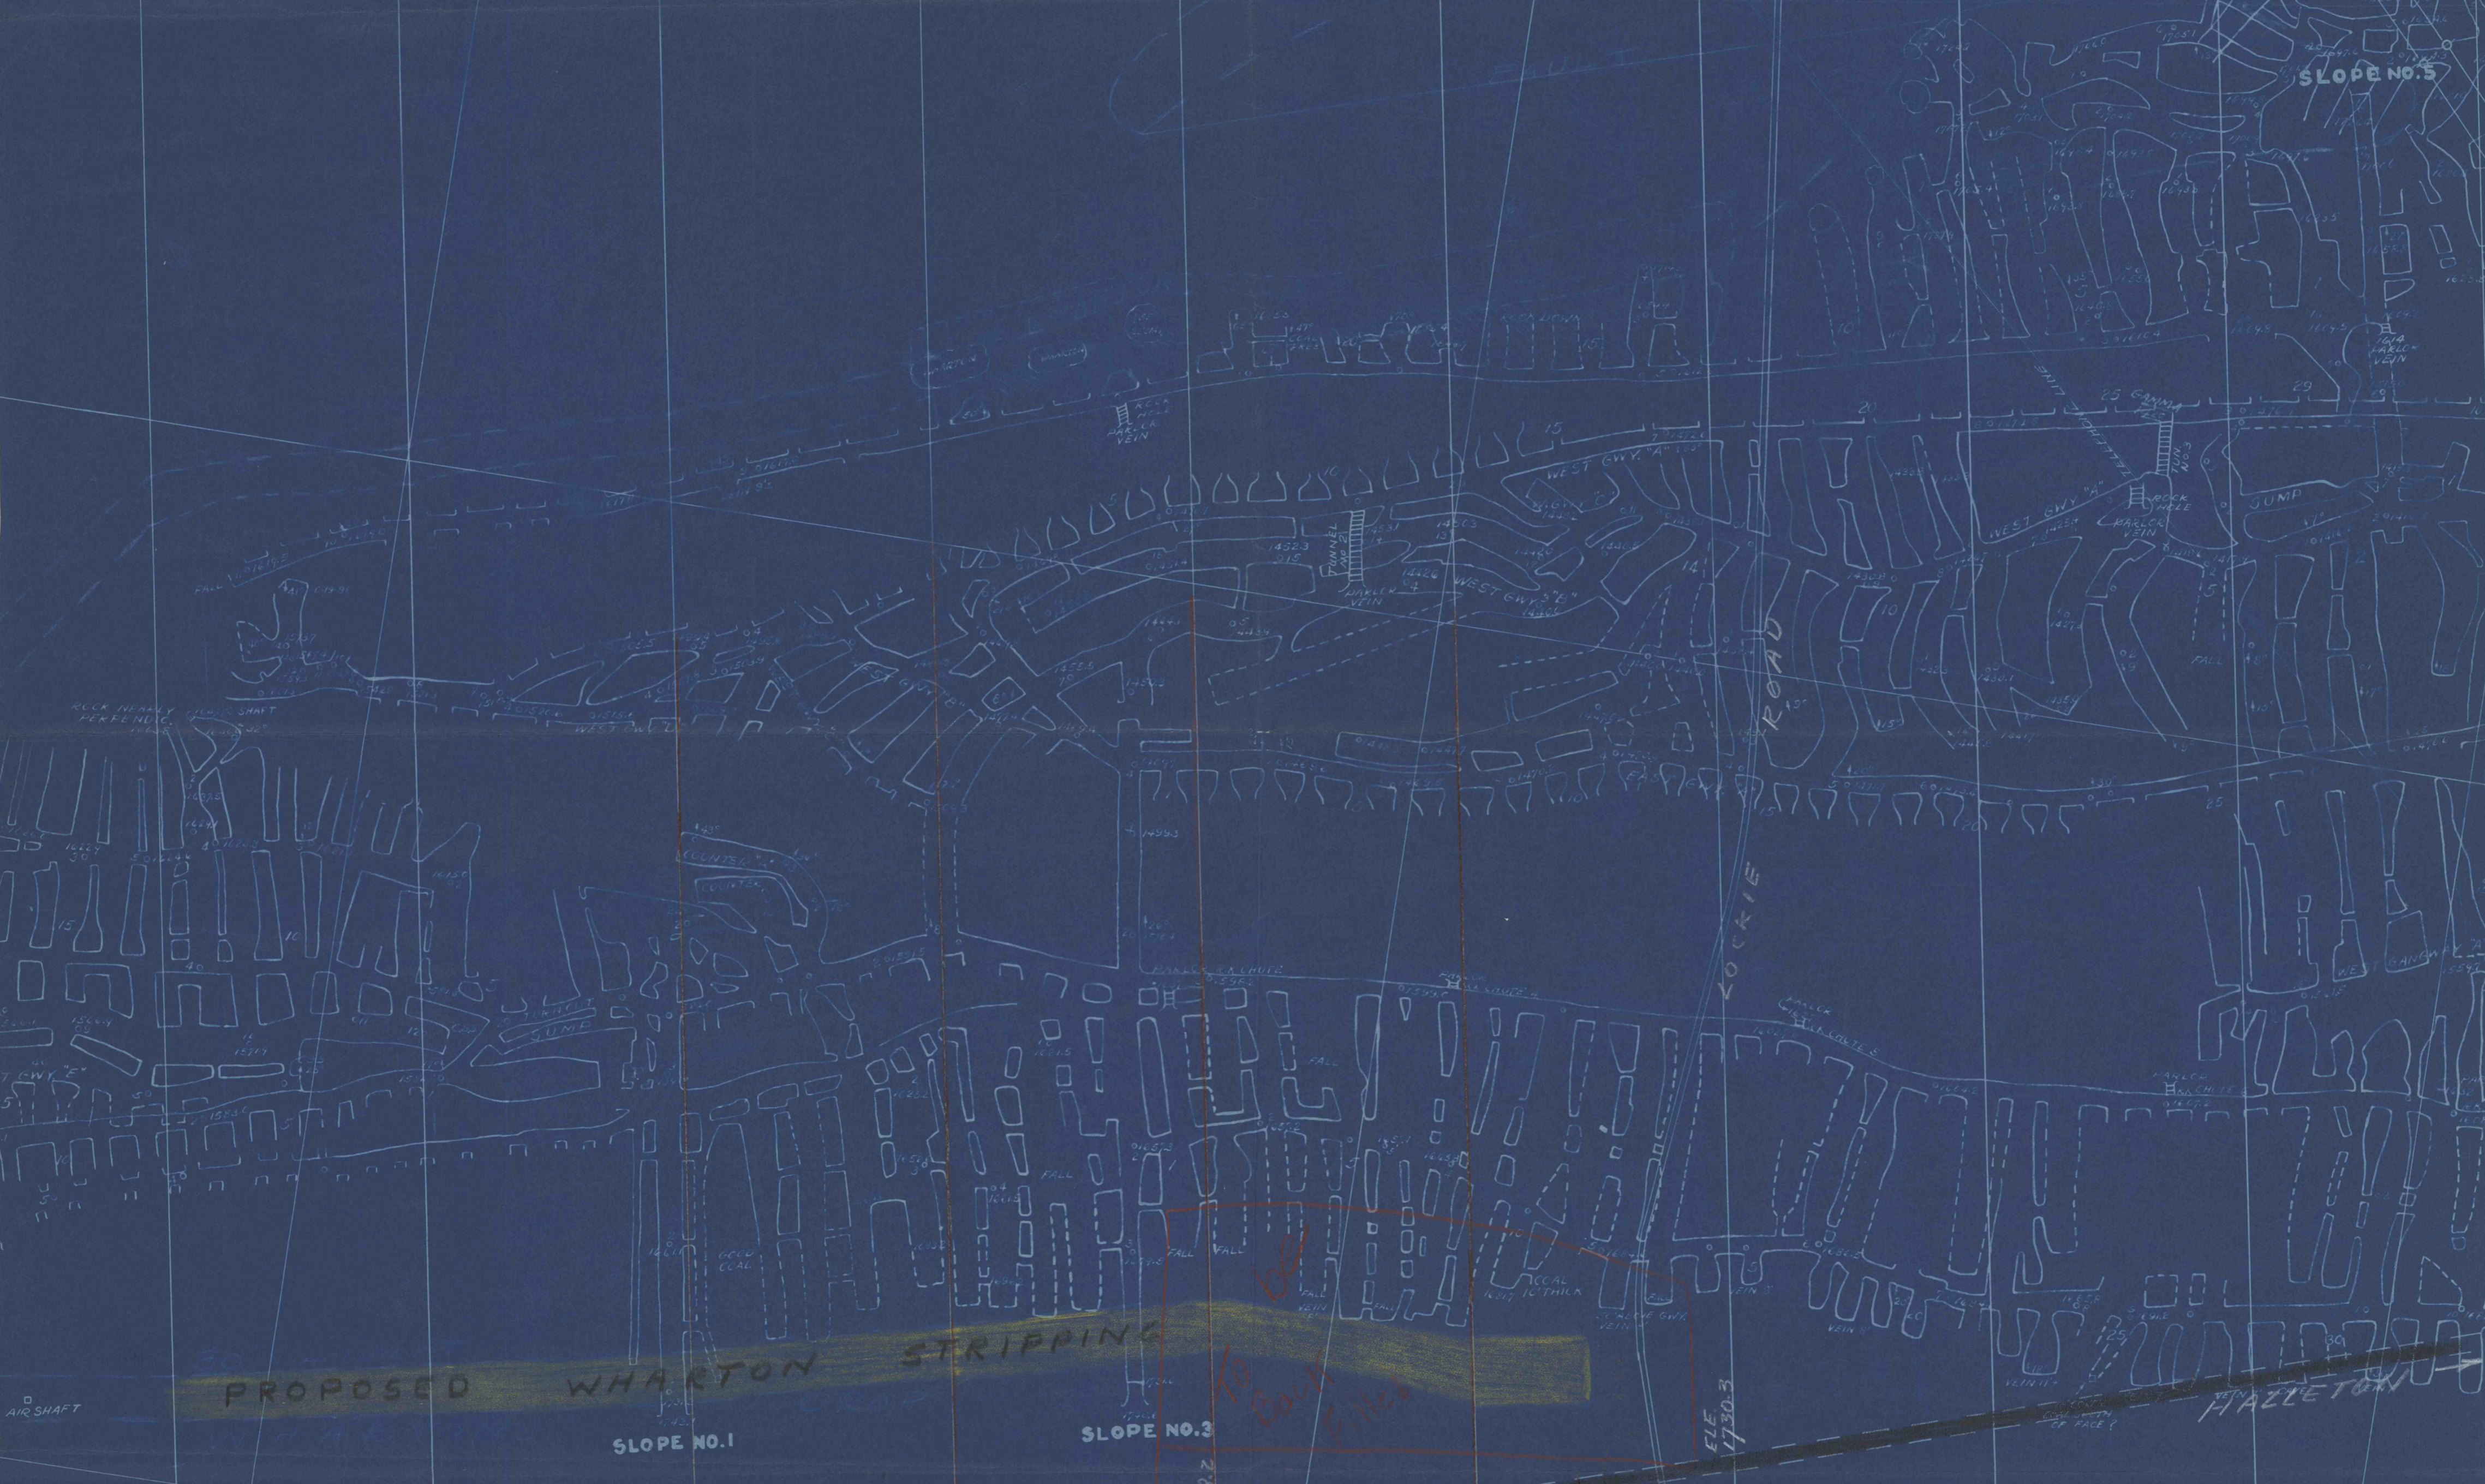

PROPOSED WHARTON STRIPPING

SLOPE NO. 1

SLOPE NO. 3

ELE 1730.3

STATE HIGHWAY #654

PROVING SLOPE

SLOPE NO. 6

SHEPPTON

1600

23000E
1000 N

14 13 12 11 10 9 8 7 6