



STRIPING

10

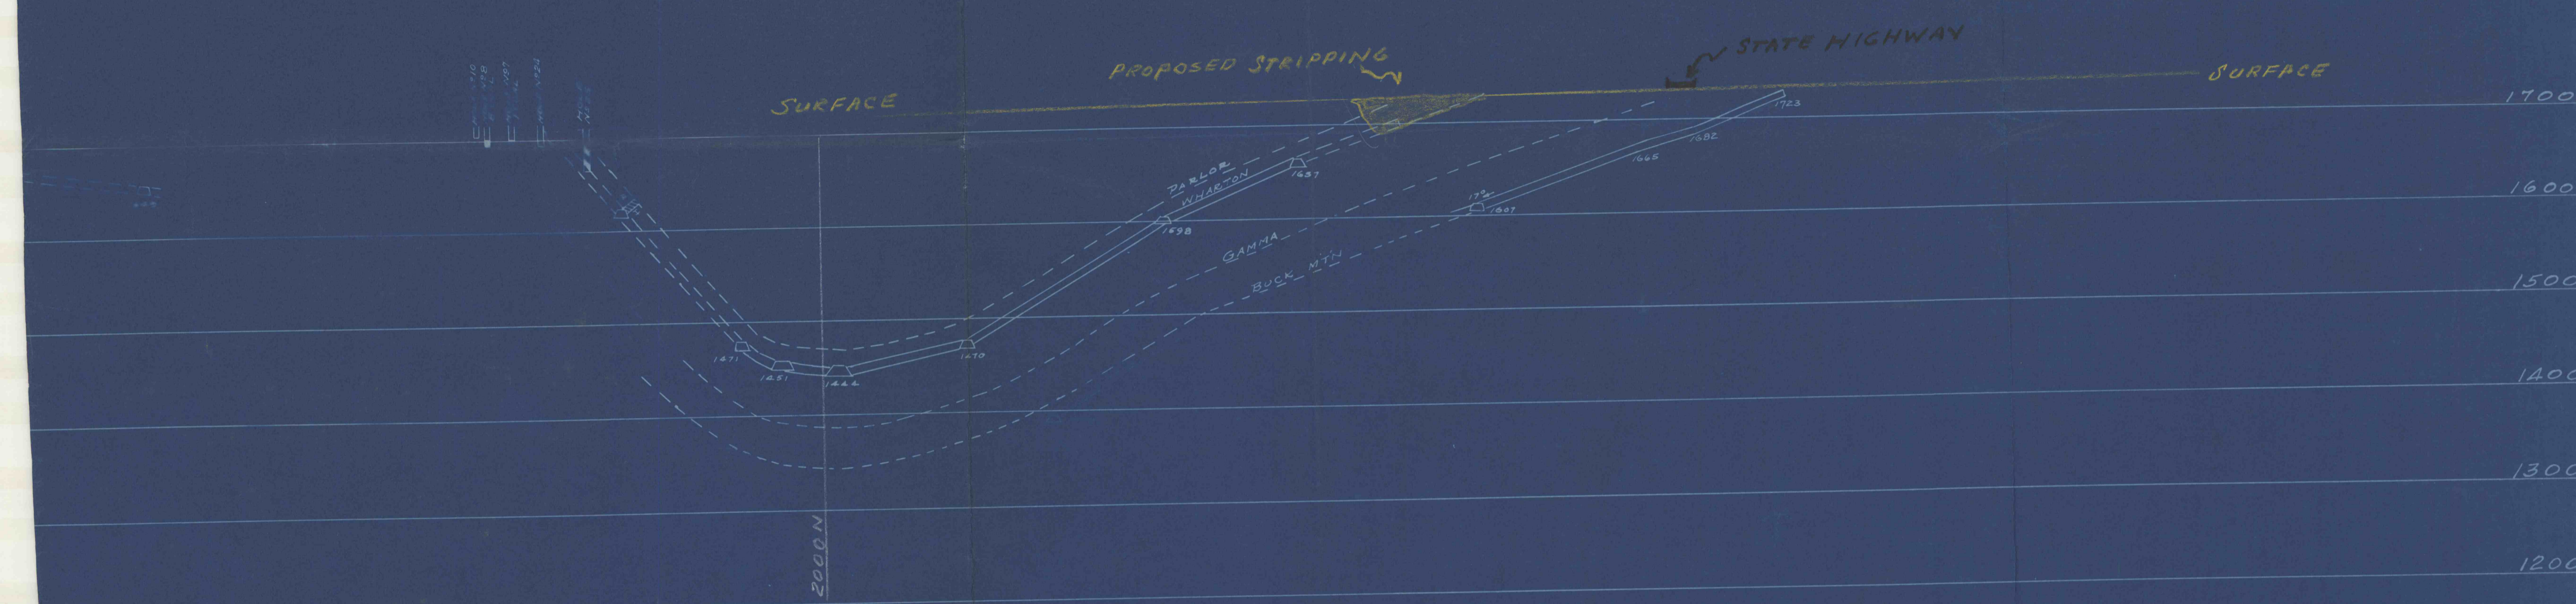

11

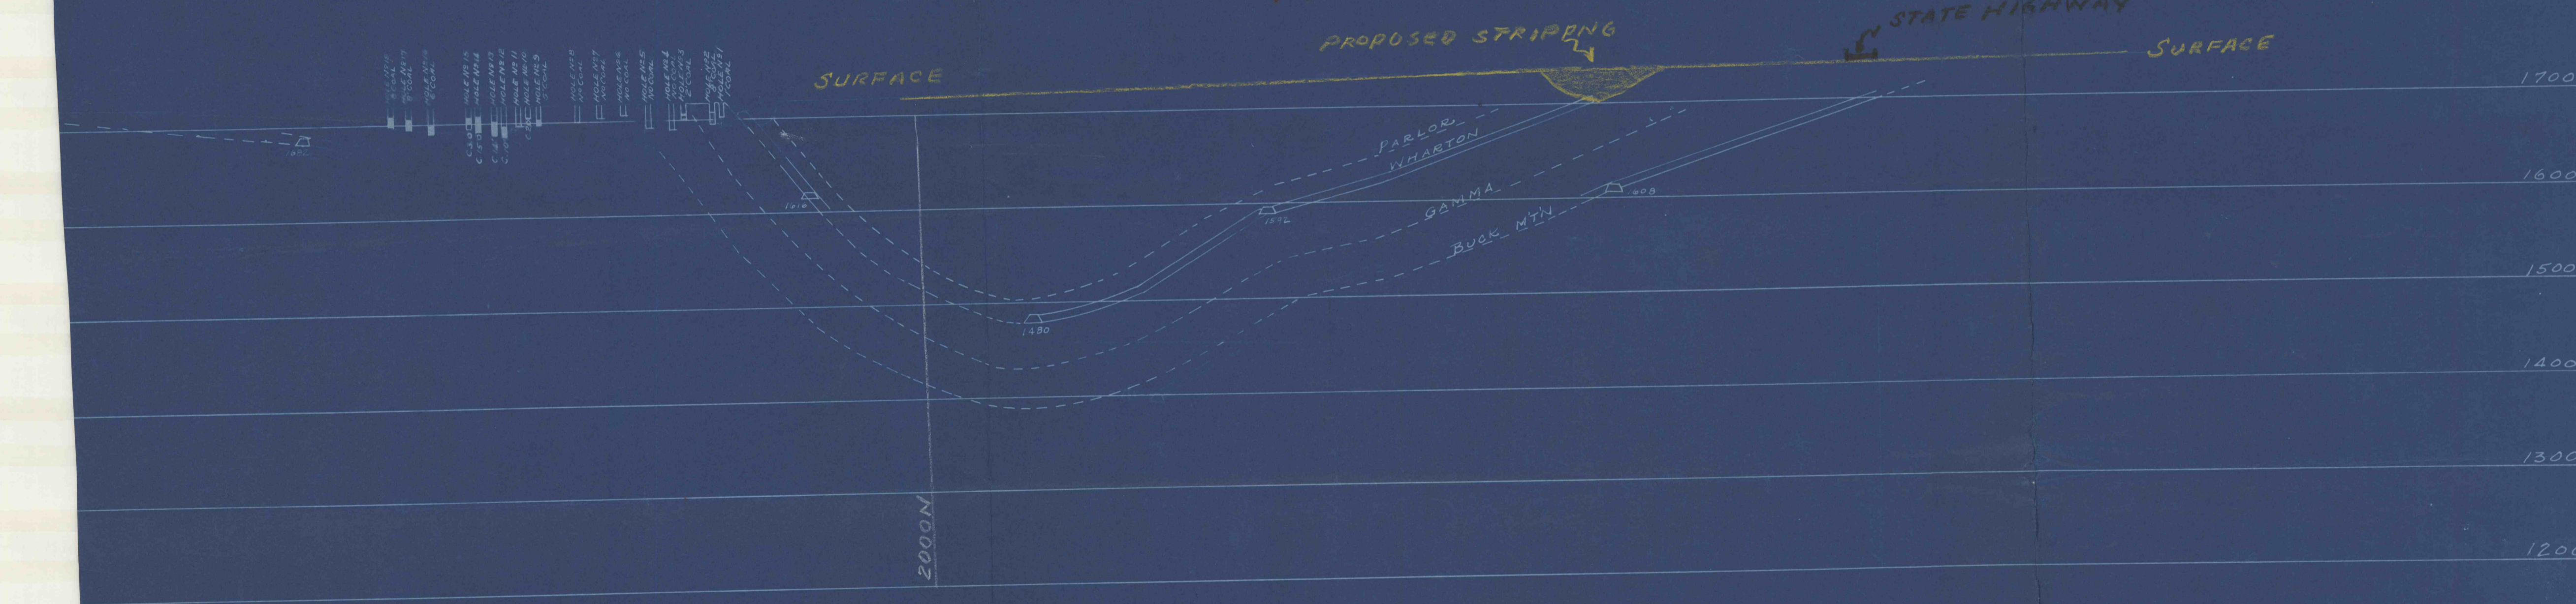

12

