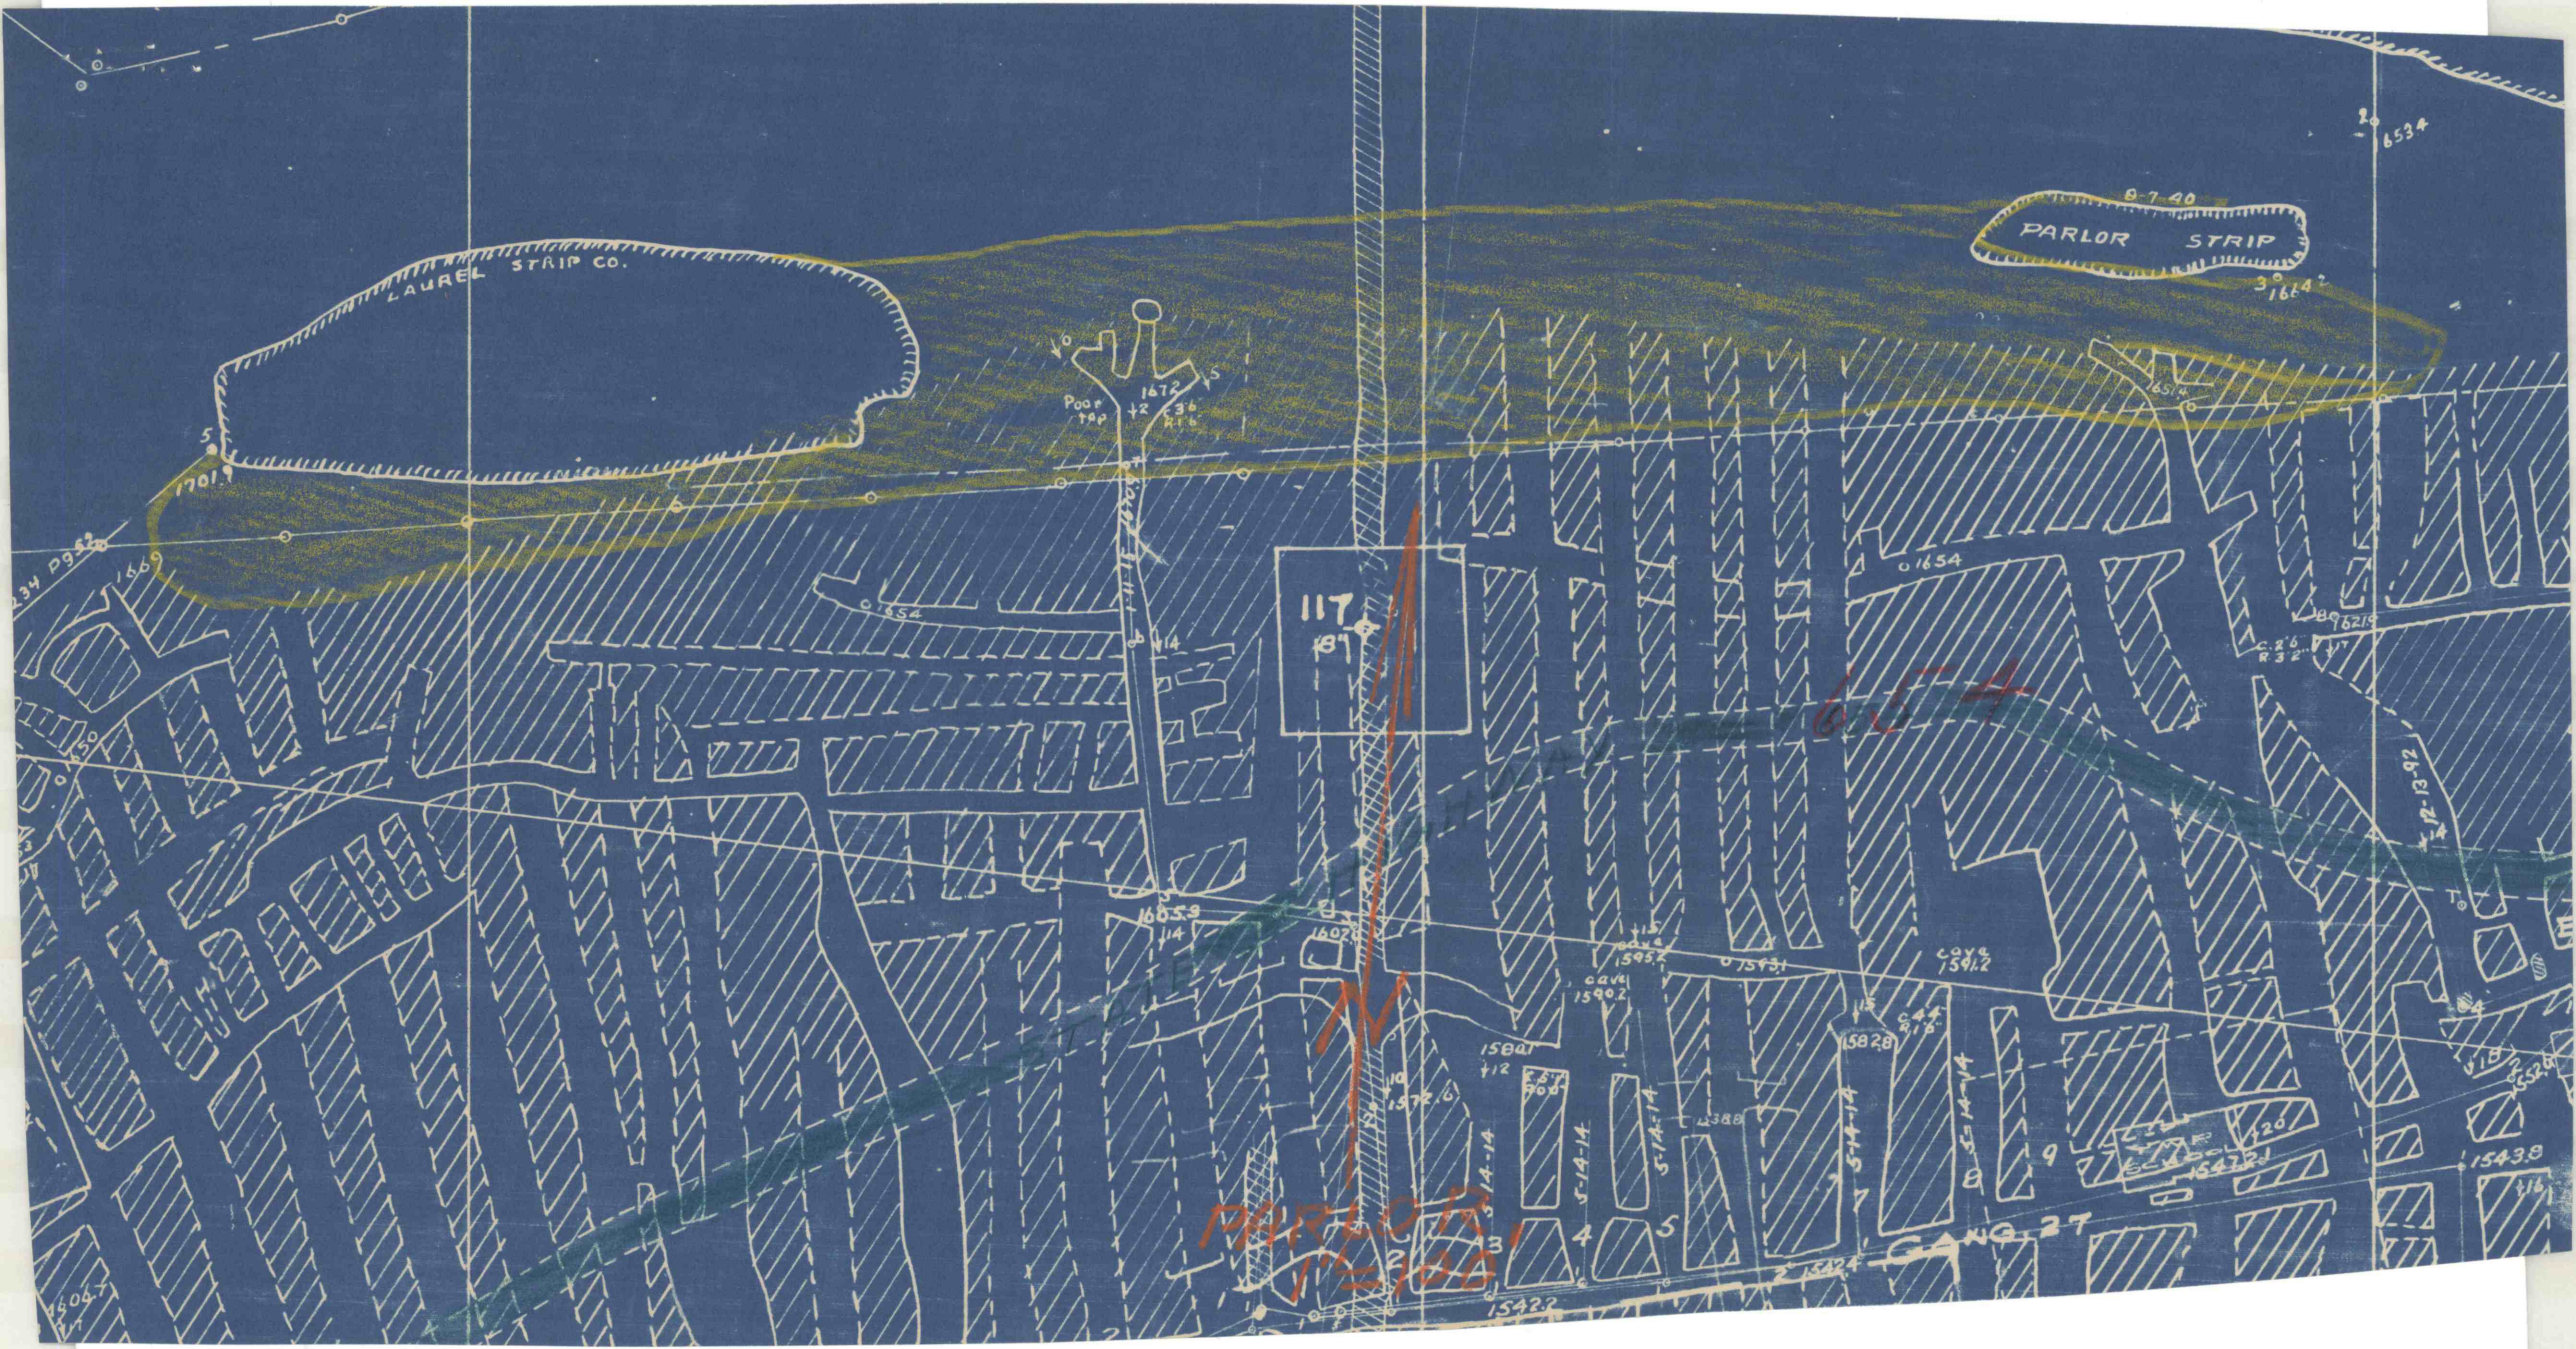
LAUREL STRIP CO.
PARLOR STRIP
8-7-40
117
PARLOR
1"=100'
GANG 27
1654
1543.8
1542.2
1542.4
1585.3
1602.8
1572.6
1580.1
1582.8
1543.1
1595.2
1590.2
1591.2
1654
1672
1701.9
1664.2
1653.4
1621.9
12-13-92
5-14-14
5-14-14
5-14-14
5-14-14
5-14-14
5-14-14
1388
1504.7
1660
1234 Pg 52
Poor top
1