
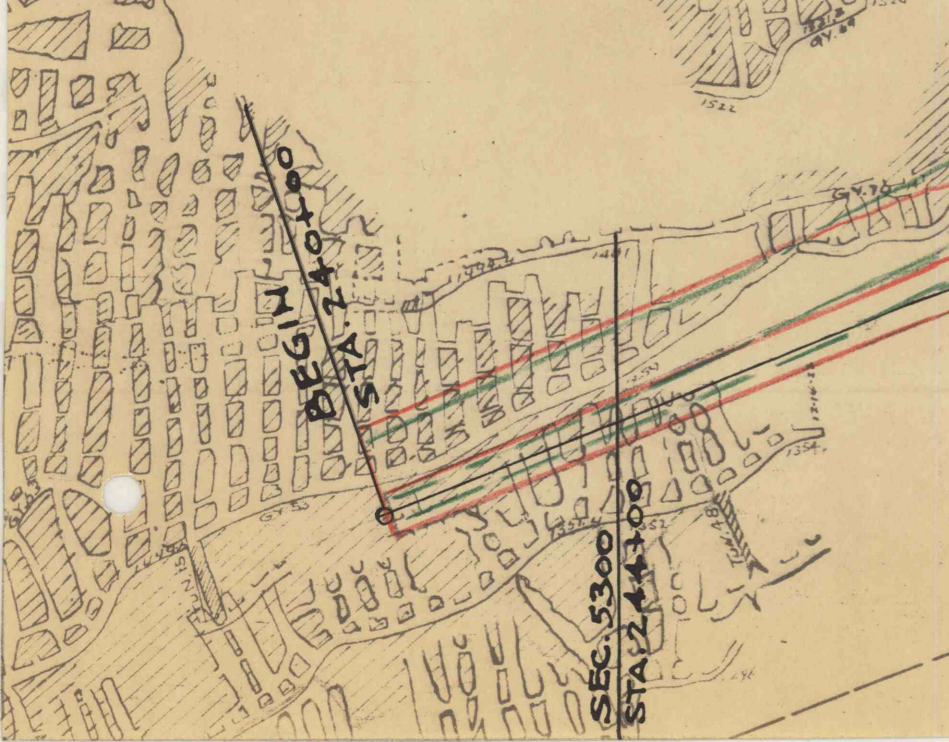
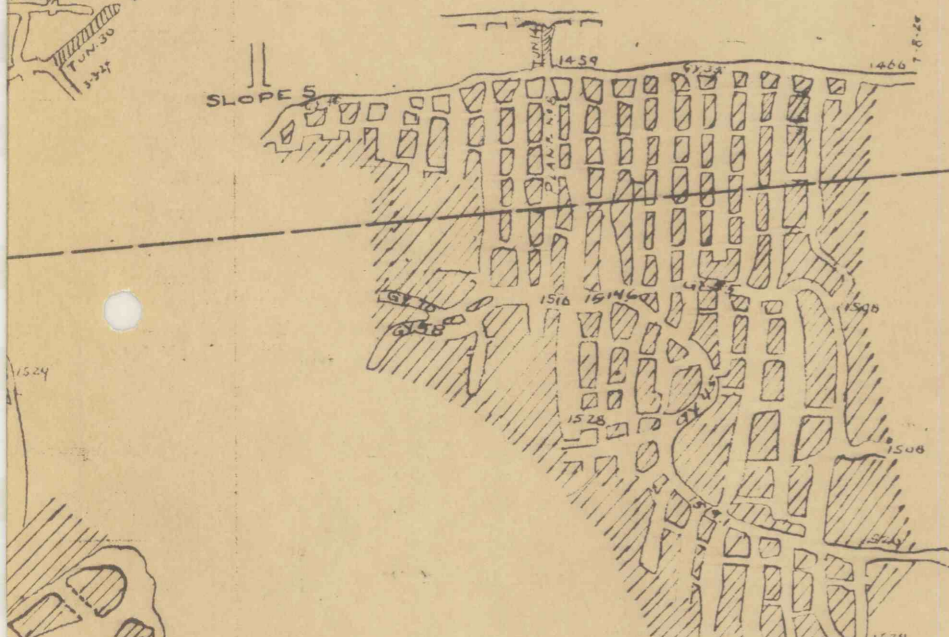


EDWARD

WINTERS

LIMIT ON L.V. COAL CO. LAND

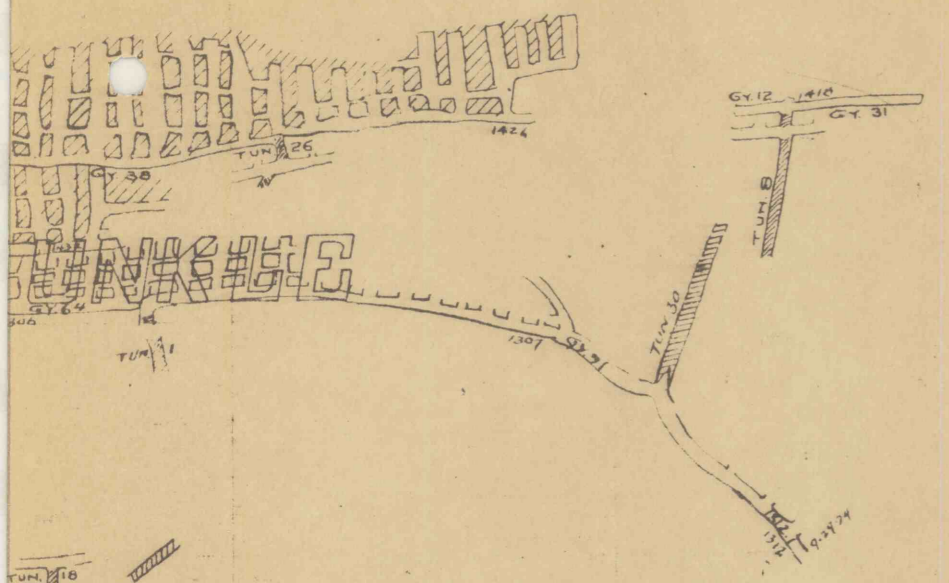

TUNNEL 2

VEIN UNMINEABLE

23 SL.

SEC. 4300
STA. 254+50

SEC. 5300
STA. 24100

BEGIN
STA. 24000

MARY

KUNKLE

BUCK MTN. VEIN

1" = 300'

