


N 6° 39' W

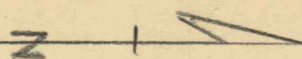

MAMMOTH

LYNN COLLIERY RR.

L.V.R.R.

STRIPPED

PUBLIC HIGHWAY


LYNN ABANDON S 2000

PUBLIC HIGHWAY

WATER LEVEL HAZ. NSI

OLD SWANBERRY

TOP OF ROCK

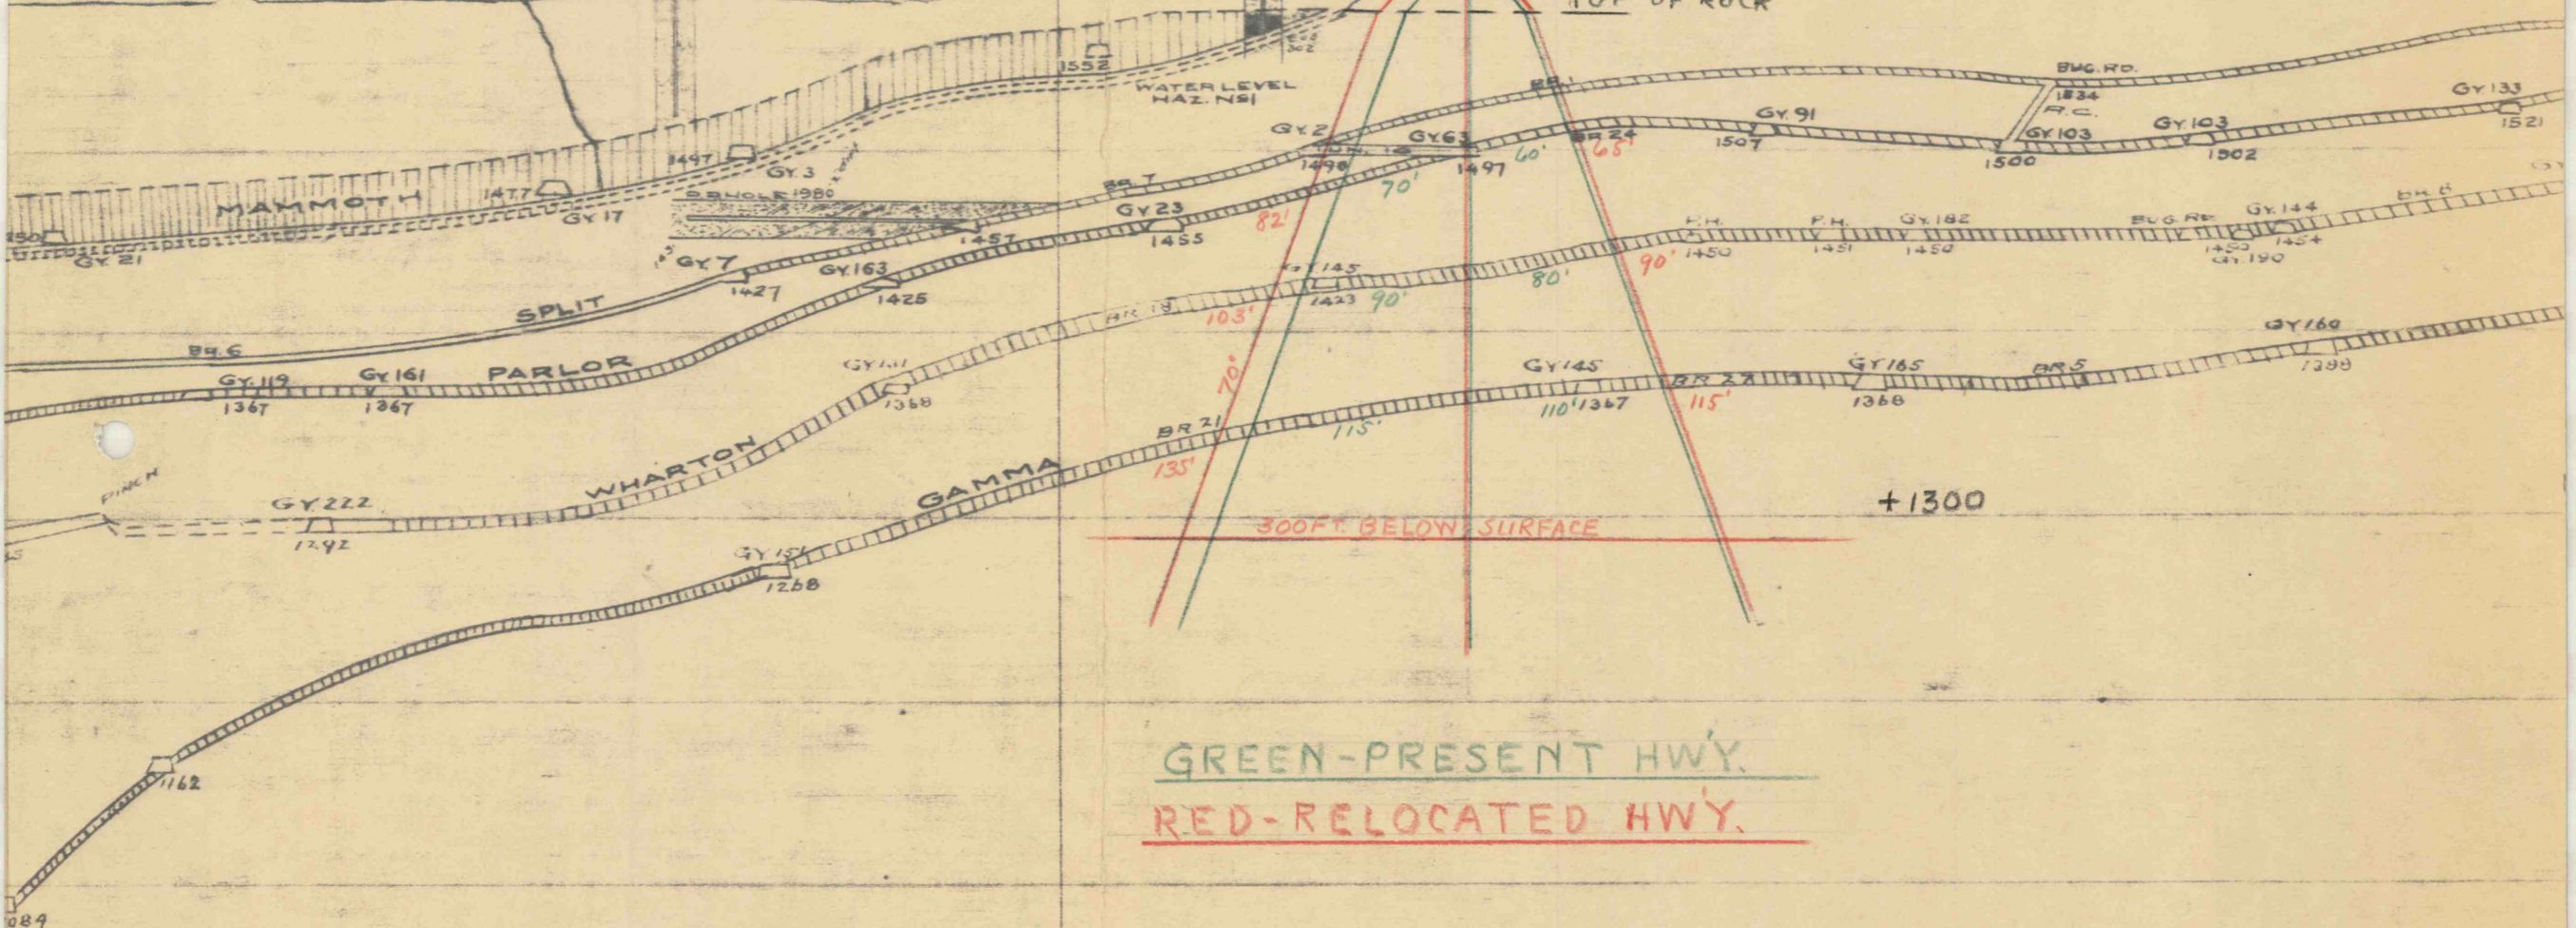

GREEN-PRESENT HWY.

RED-RELOCATED HWY.

SECTION-400

STA. 295+25

1"=100'