


1000

5 3000

5 2000

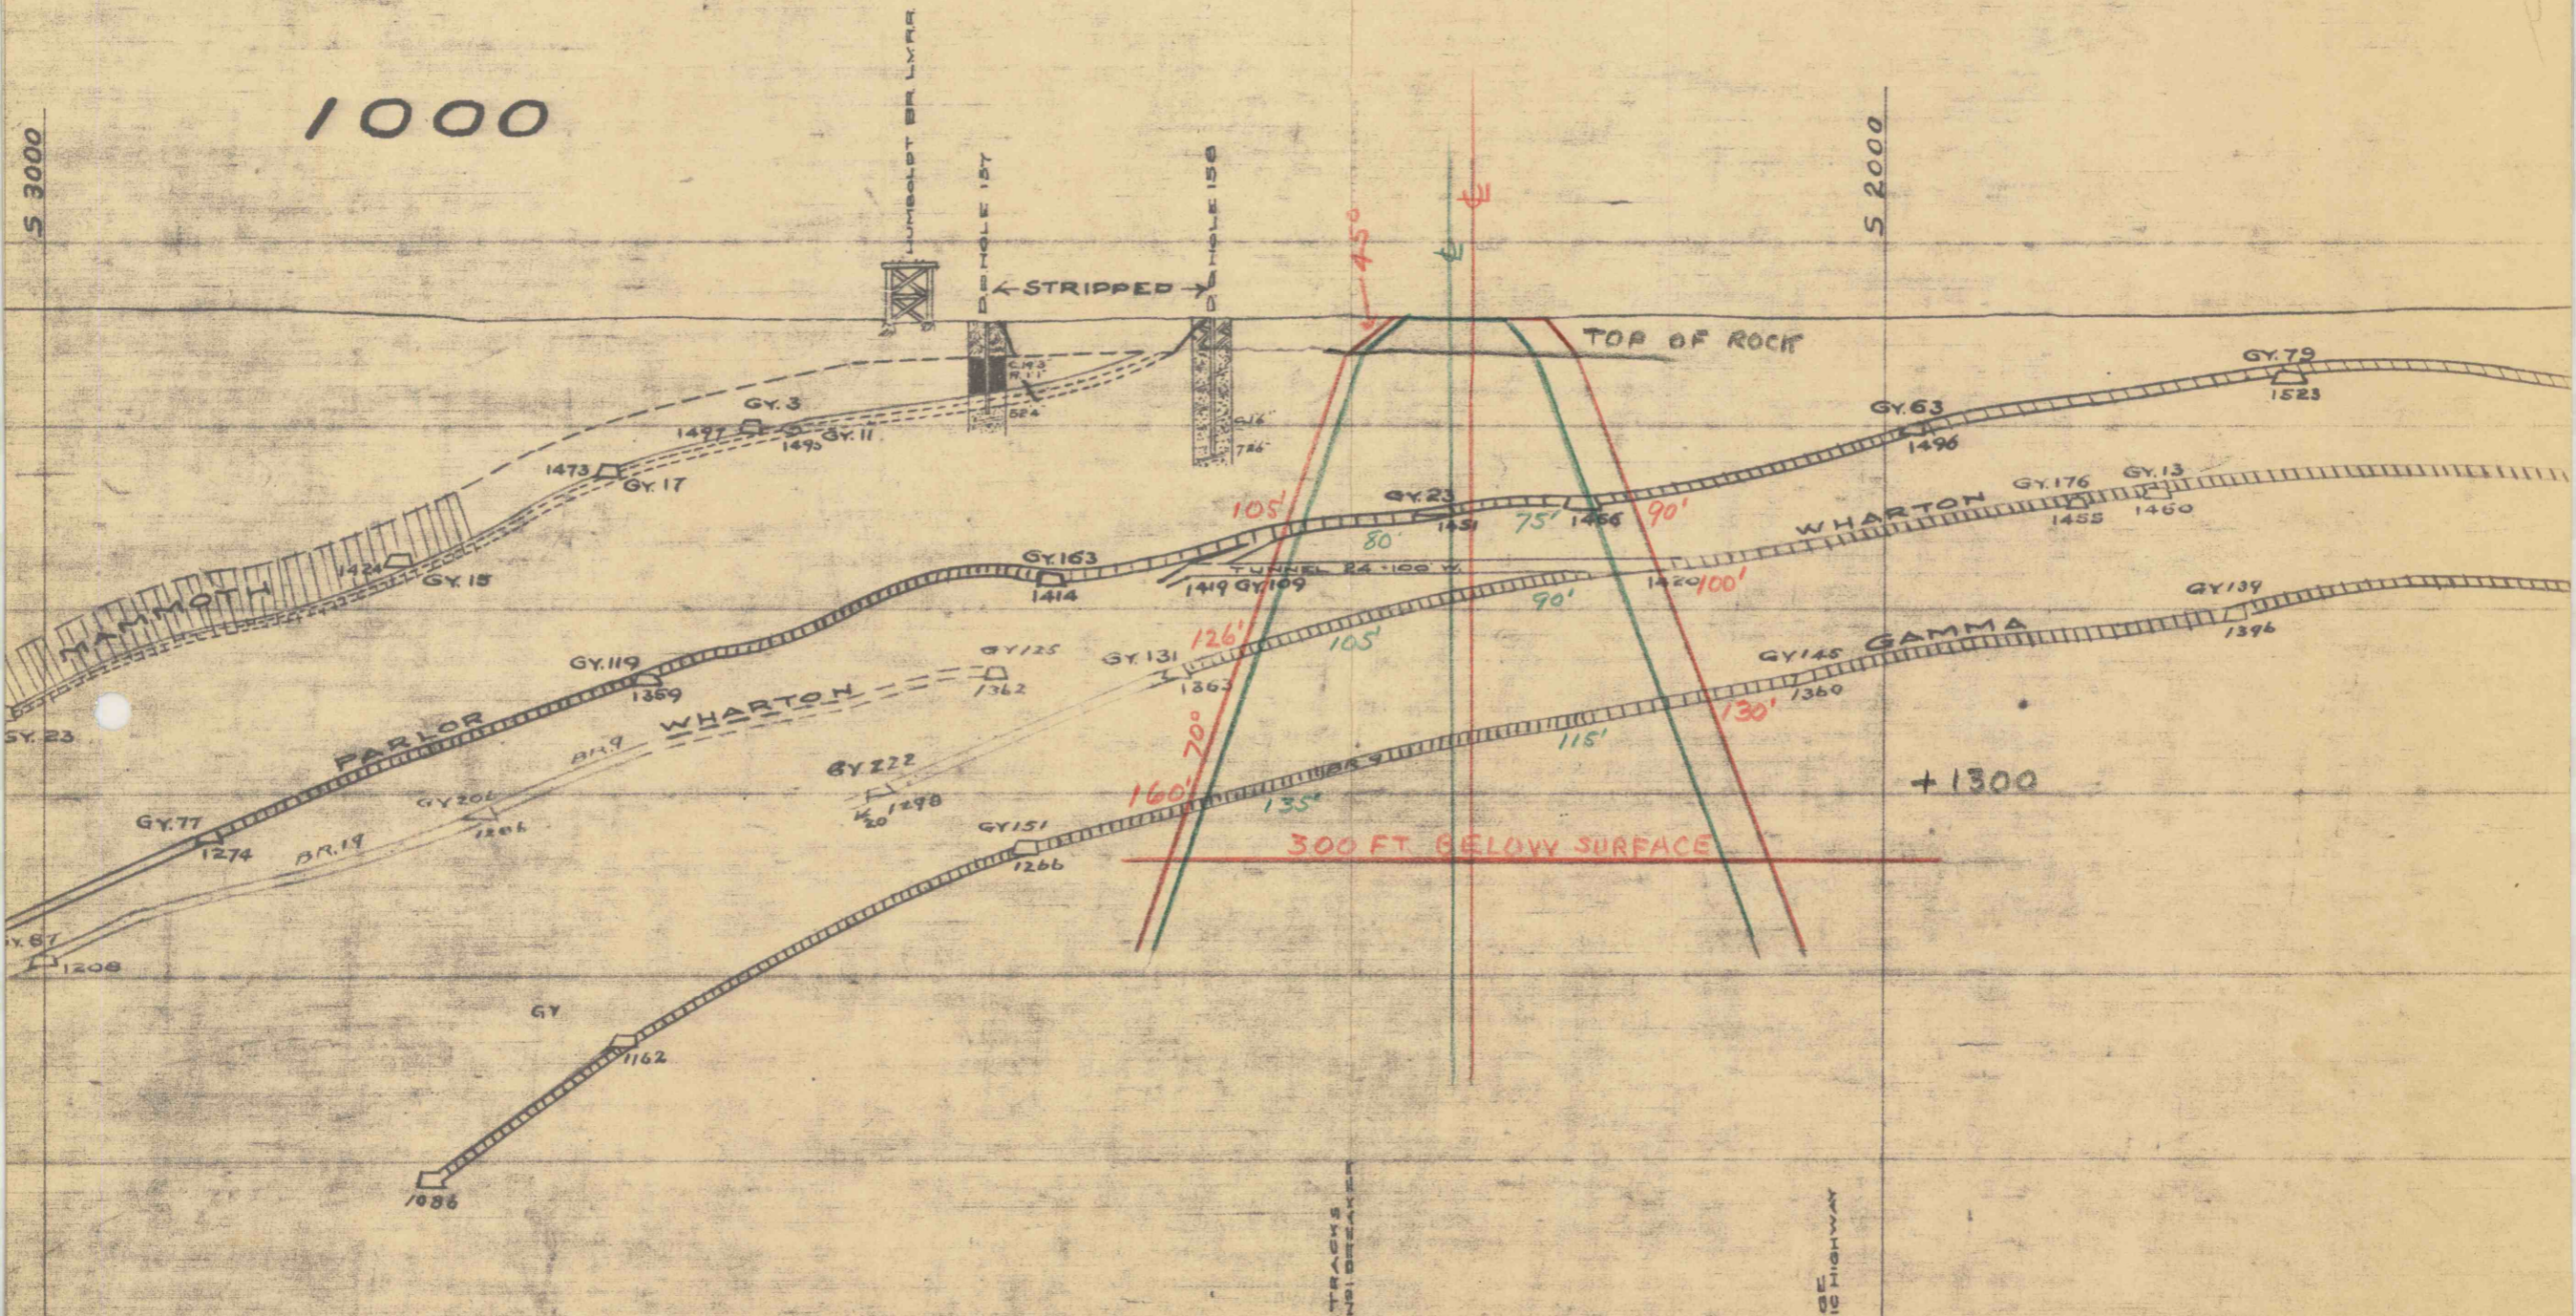

SECTION-1000

STA. 288+10

1" = 100'

