SECTIONS

1600

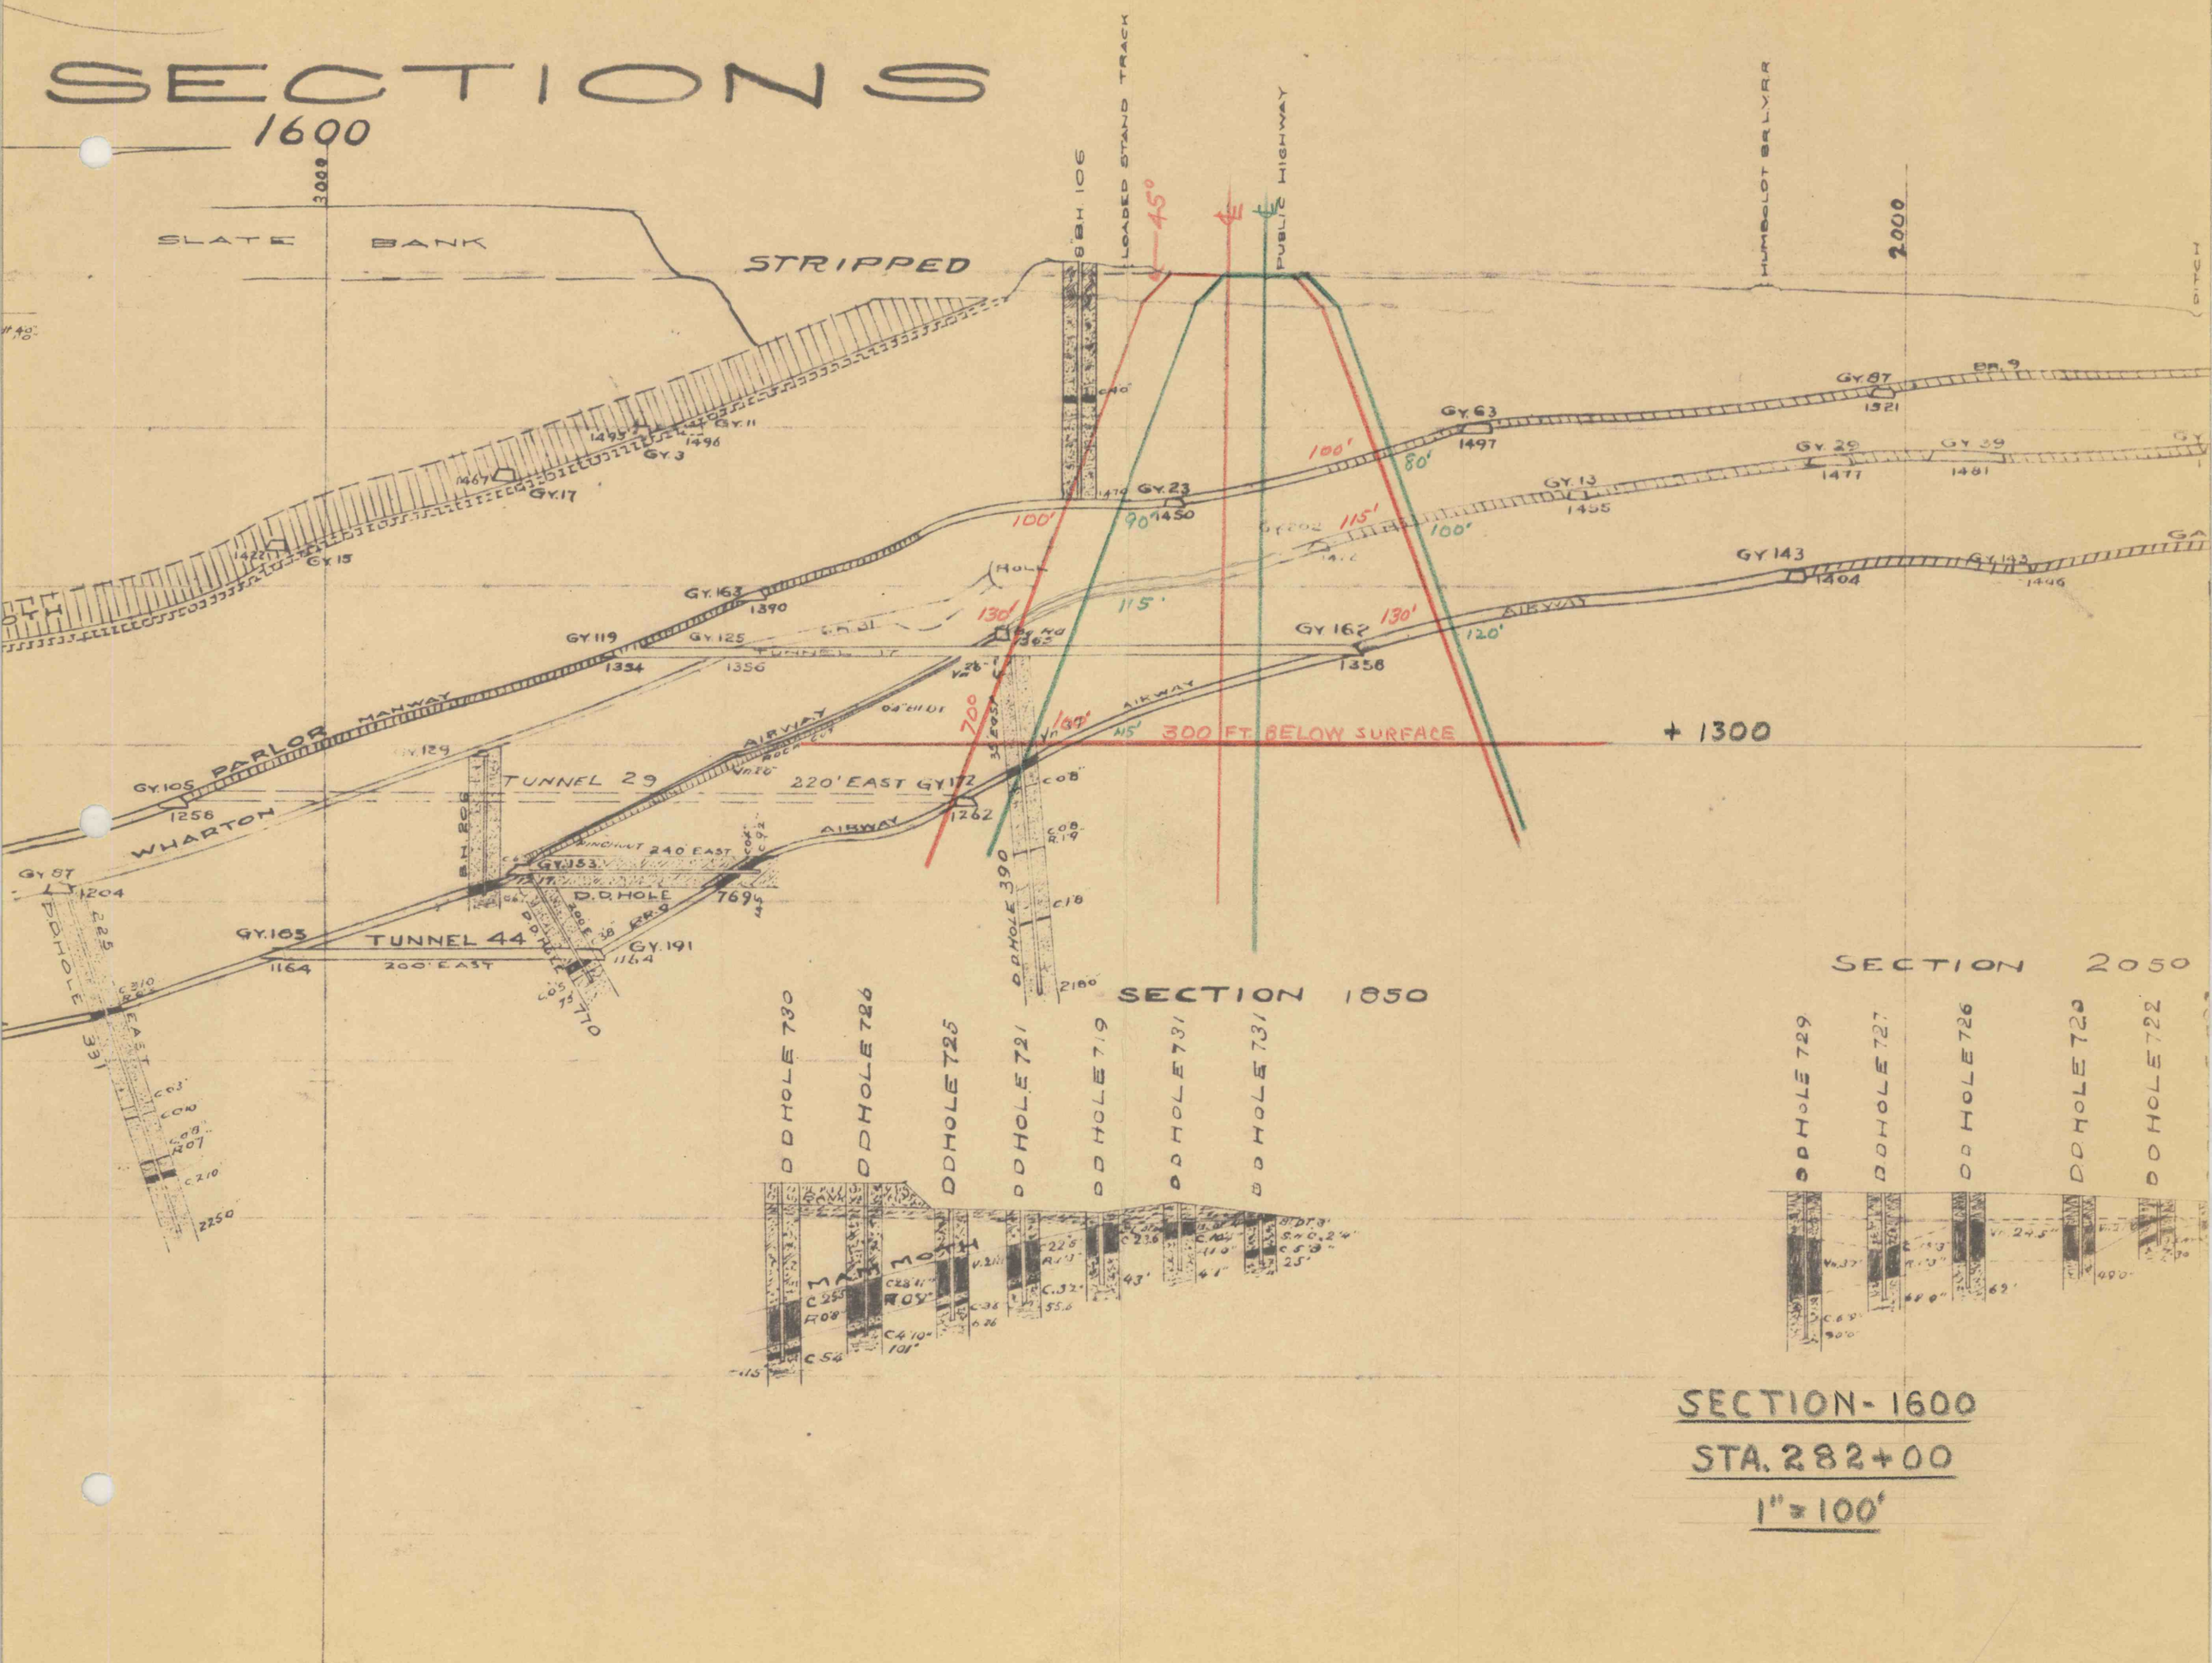

SECTION - 1600

STA. 282+00

1" = 100'