


BERRY

SECTIONS

N 6° 39' W

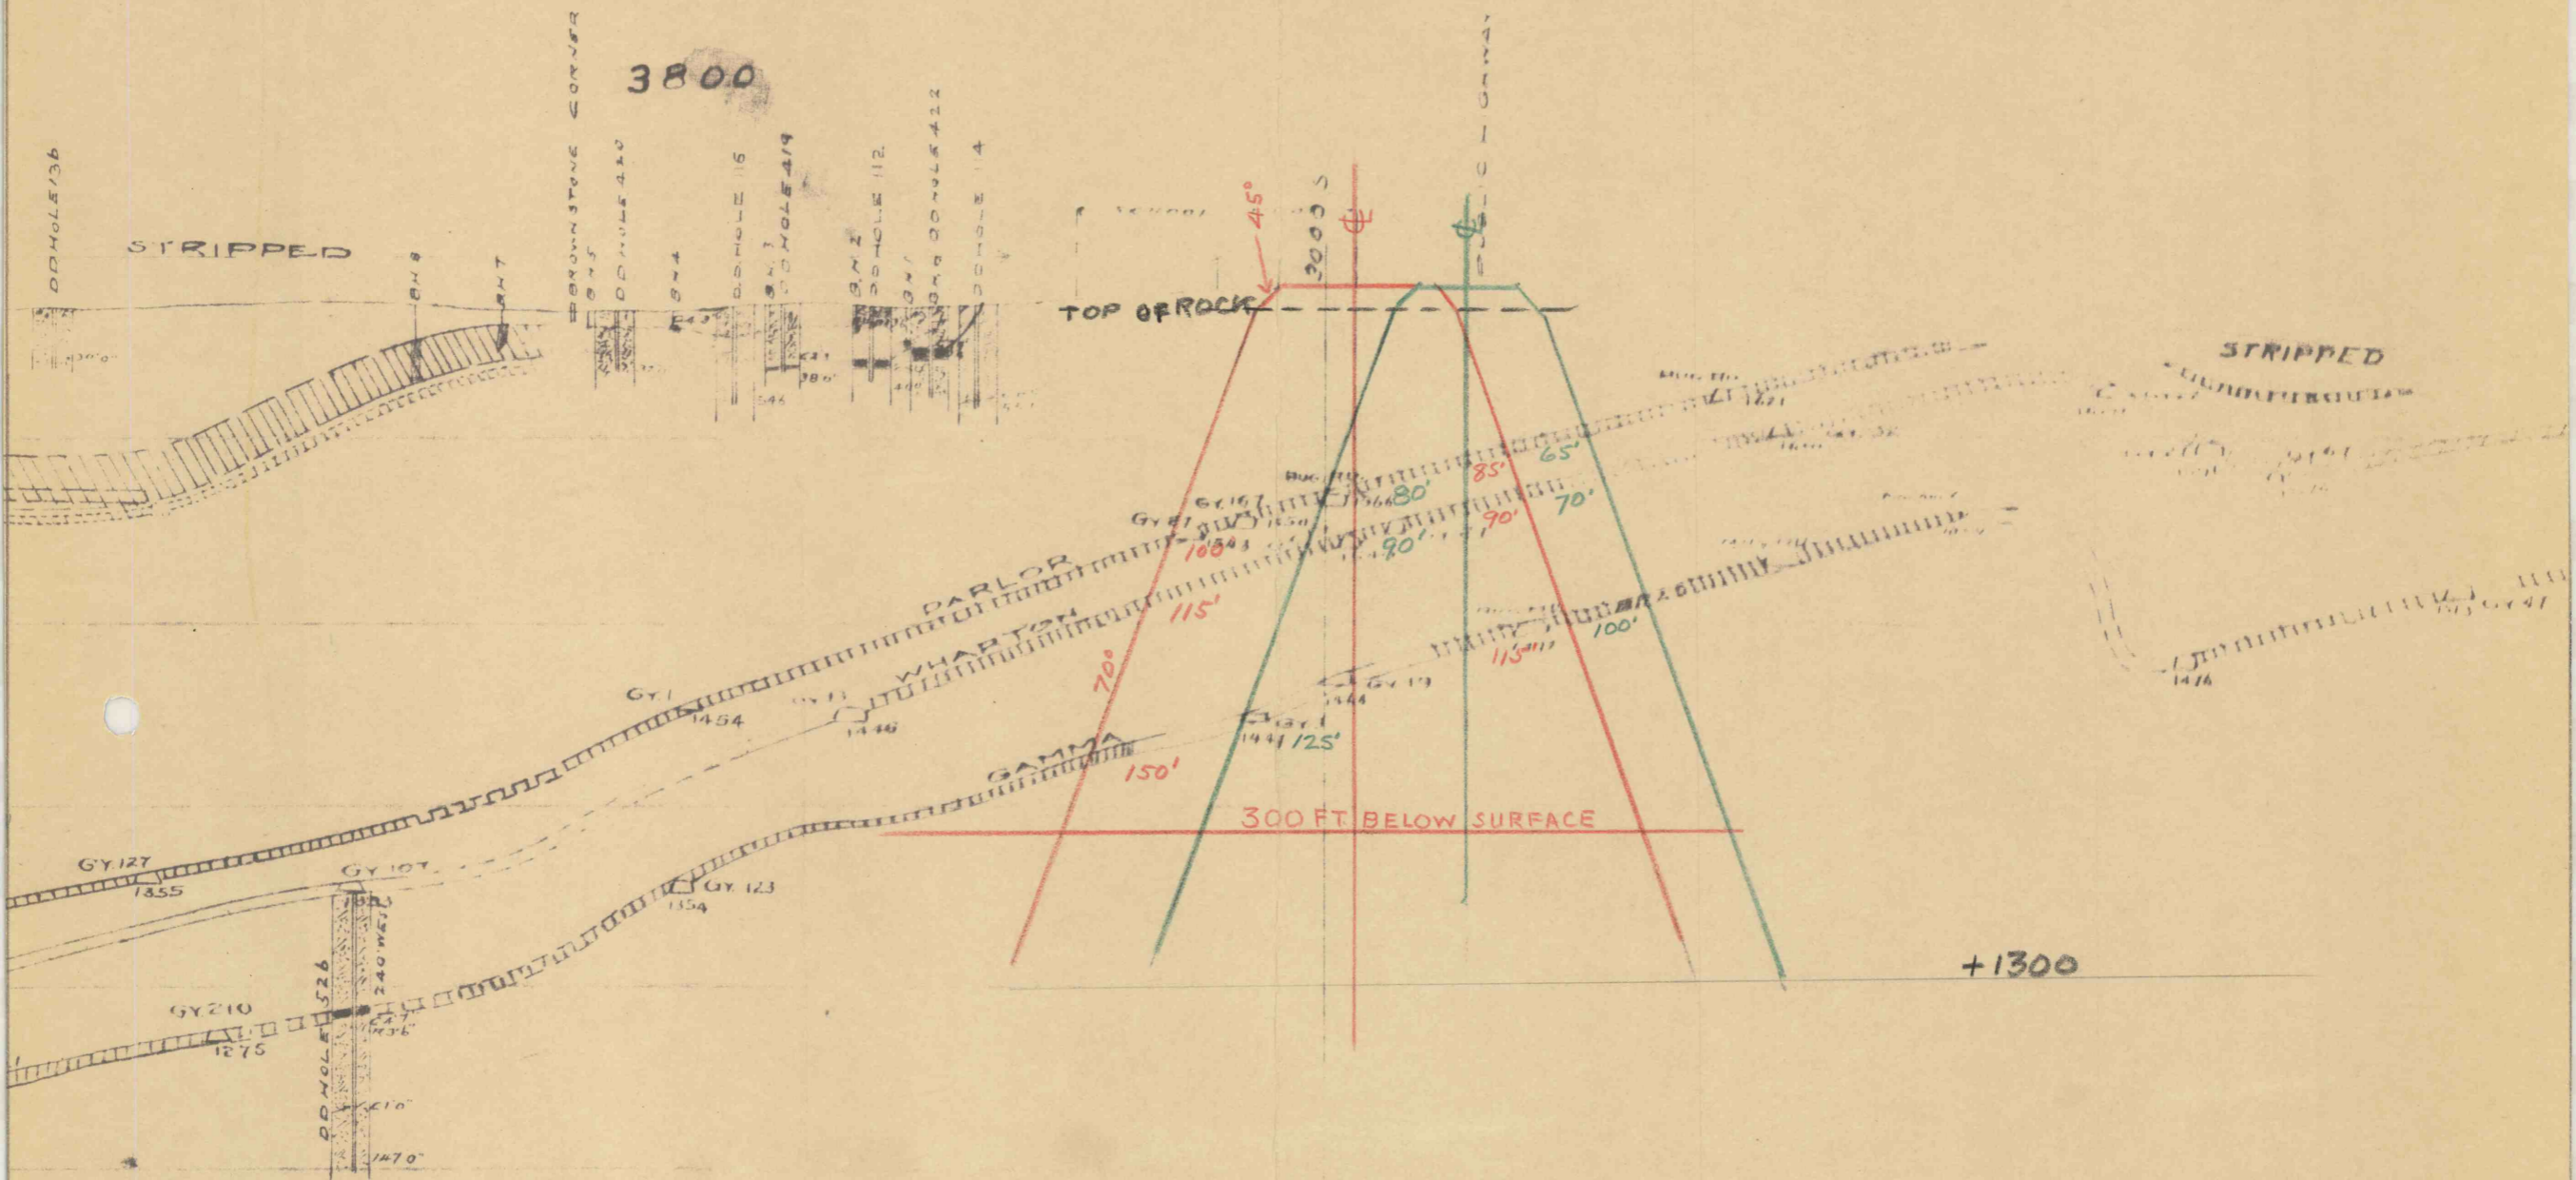

SECTION-3800
STA. 259+00
1"=100'