


4300

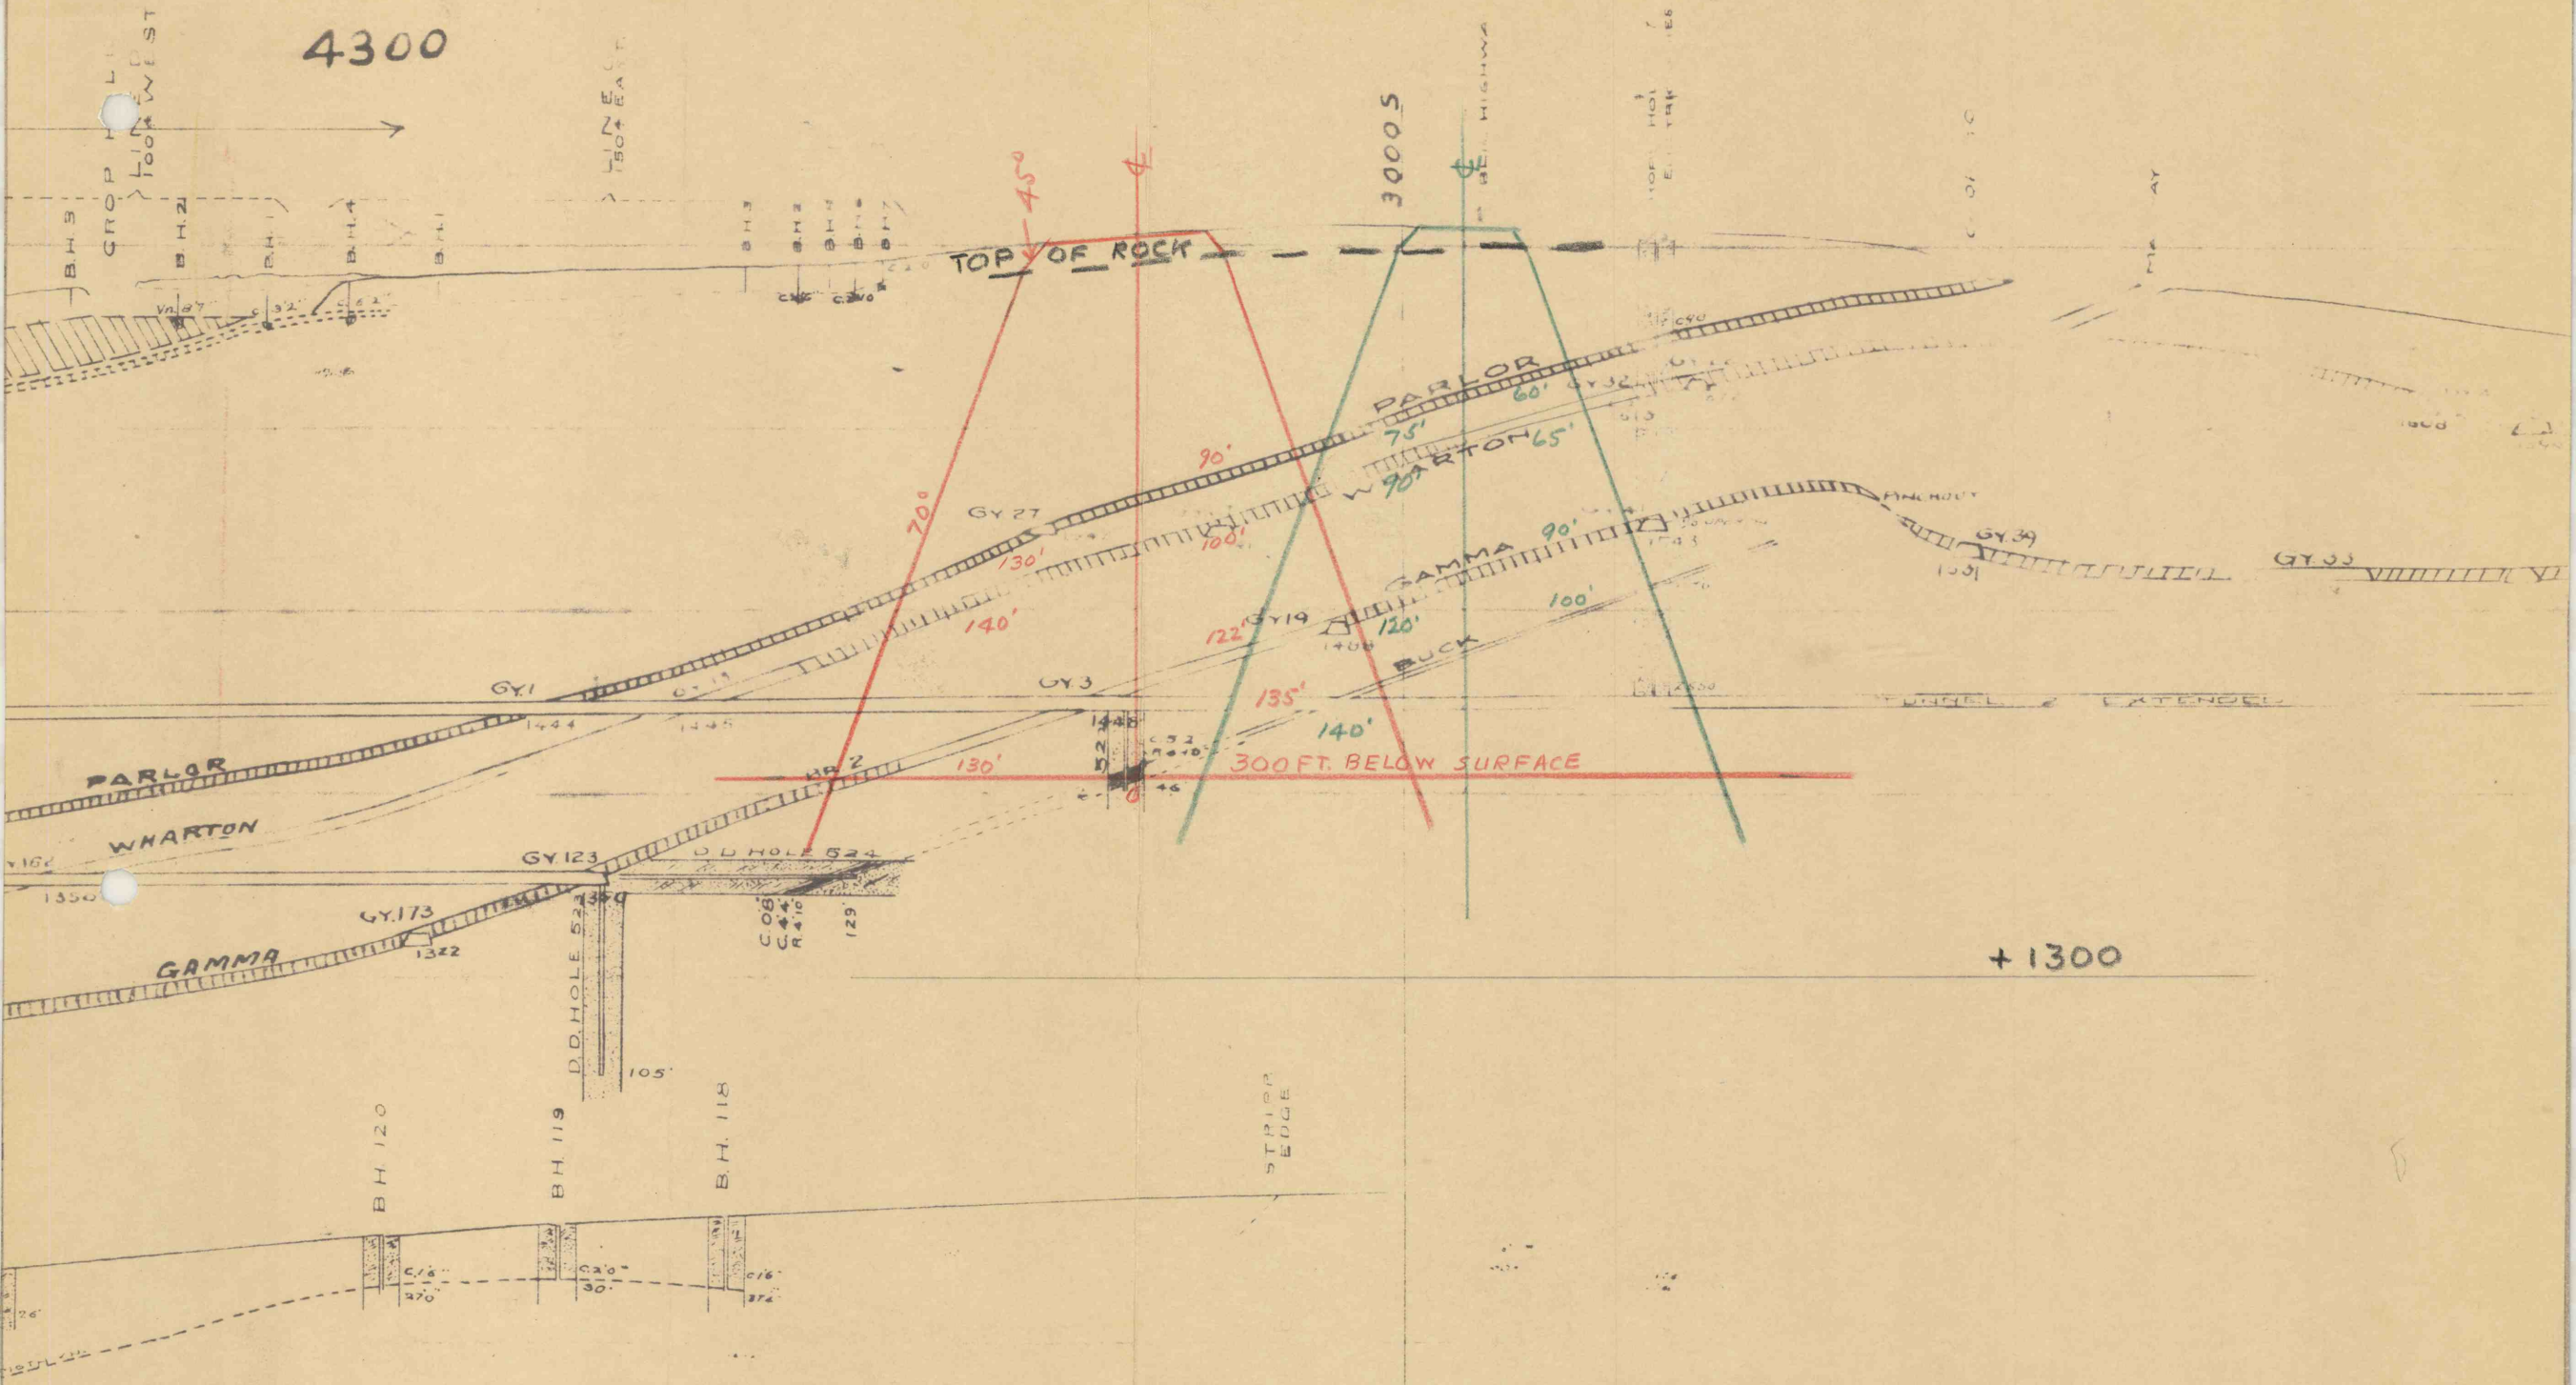

SECTION ON STRIPPING SECTION LINE 72

N. 27° 16' W.

4800

D.D. HOLE 122

D.D. HOLE 121

PUBLIC HIGHWAY

3000 S

SECTION 4300

STA. 254+50

1" = 100'