


5300

40005

DD HOLE 629
30005

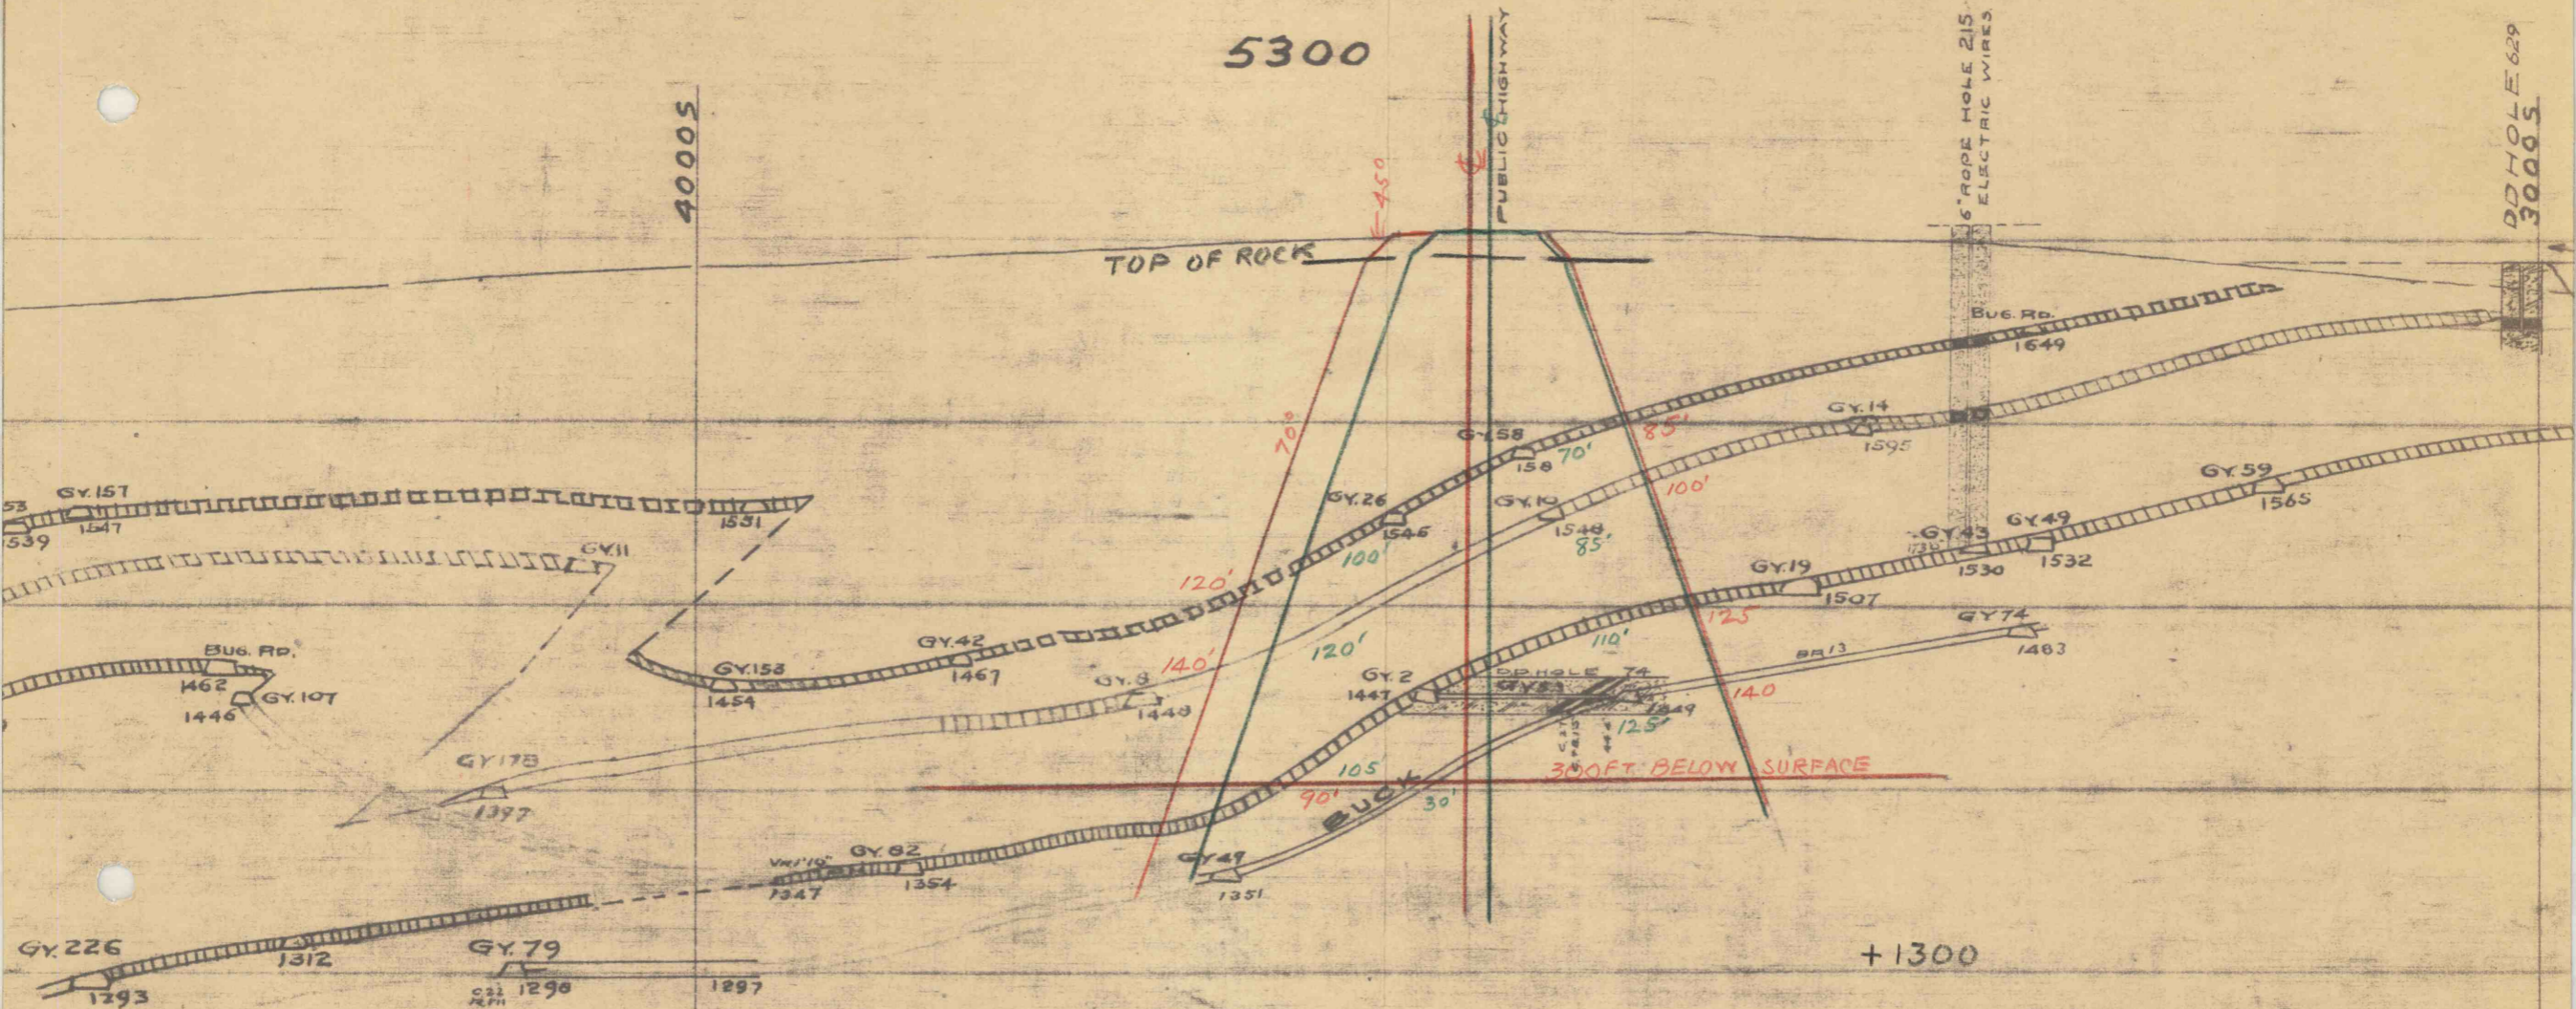

SECTION 5300

STA. 244+00

1" = 100'