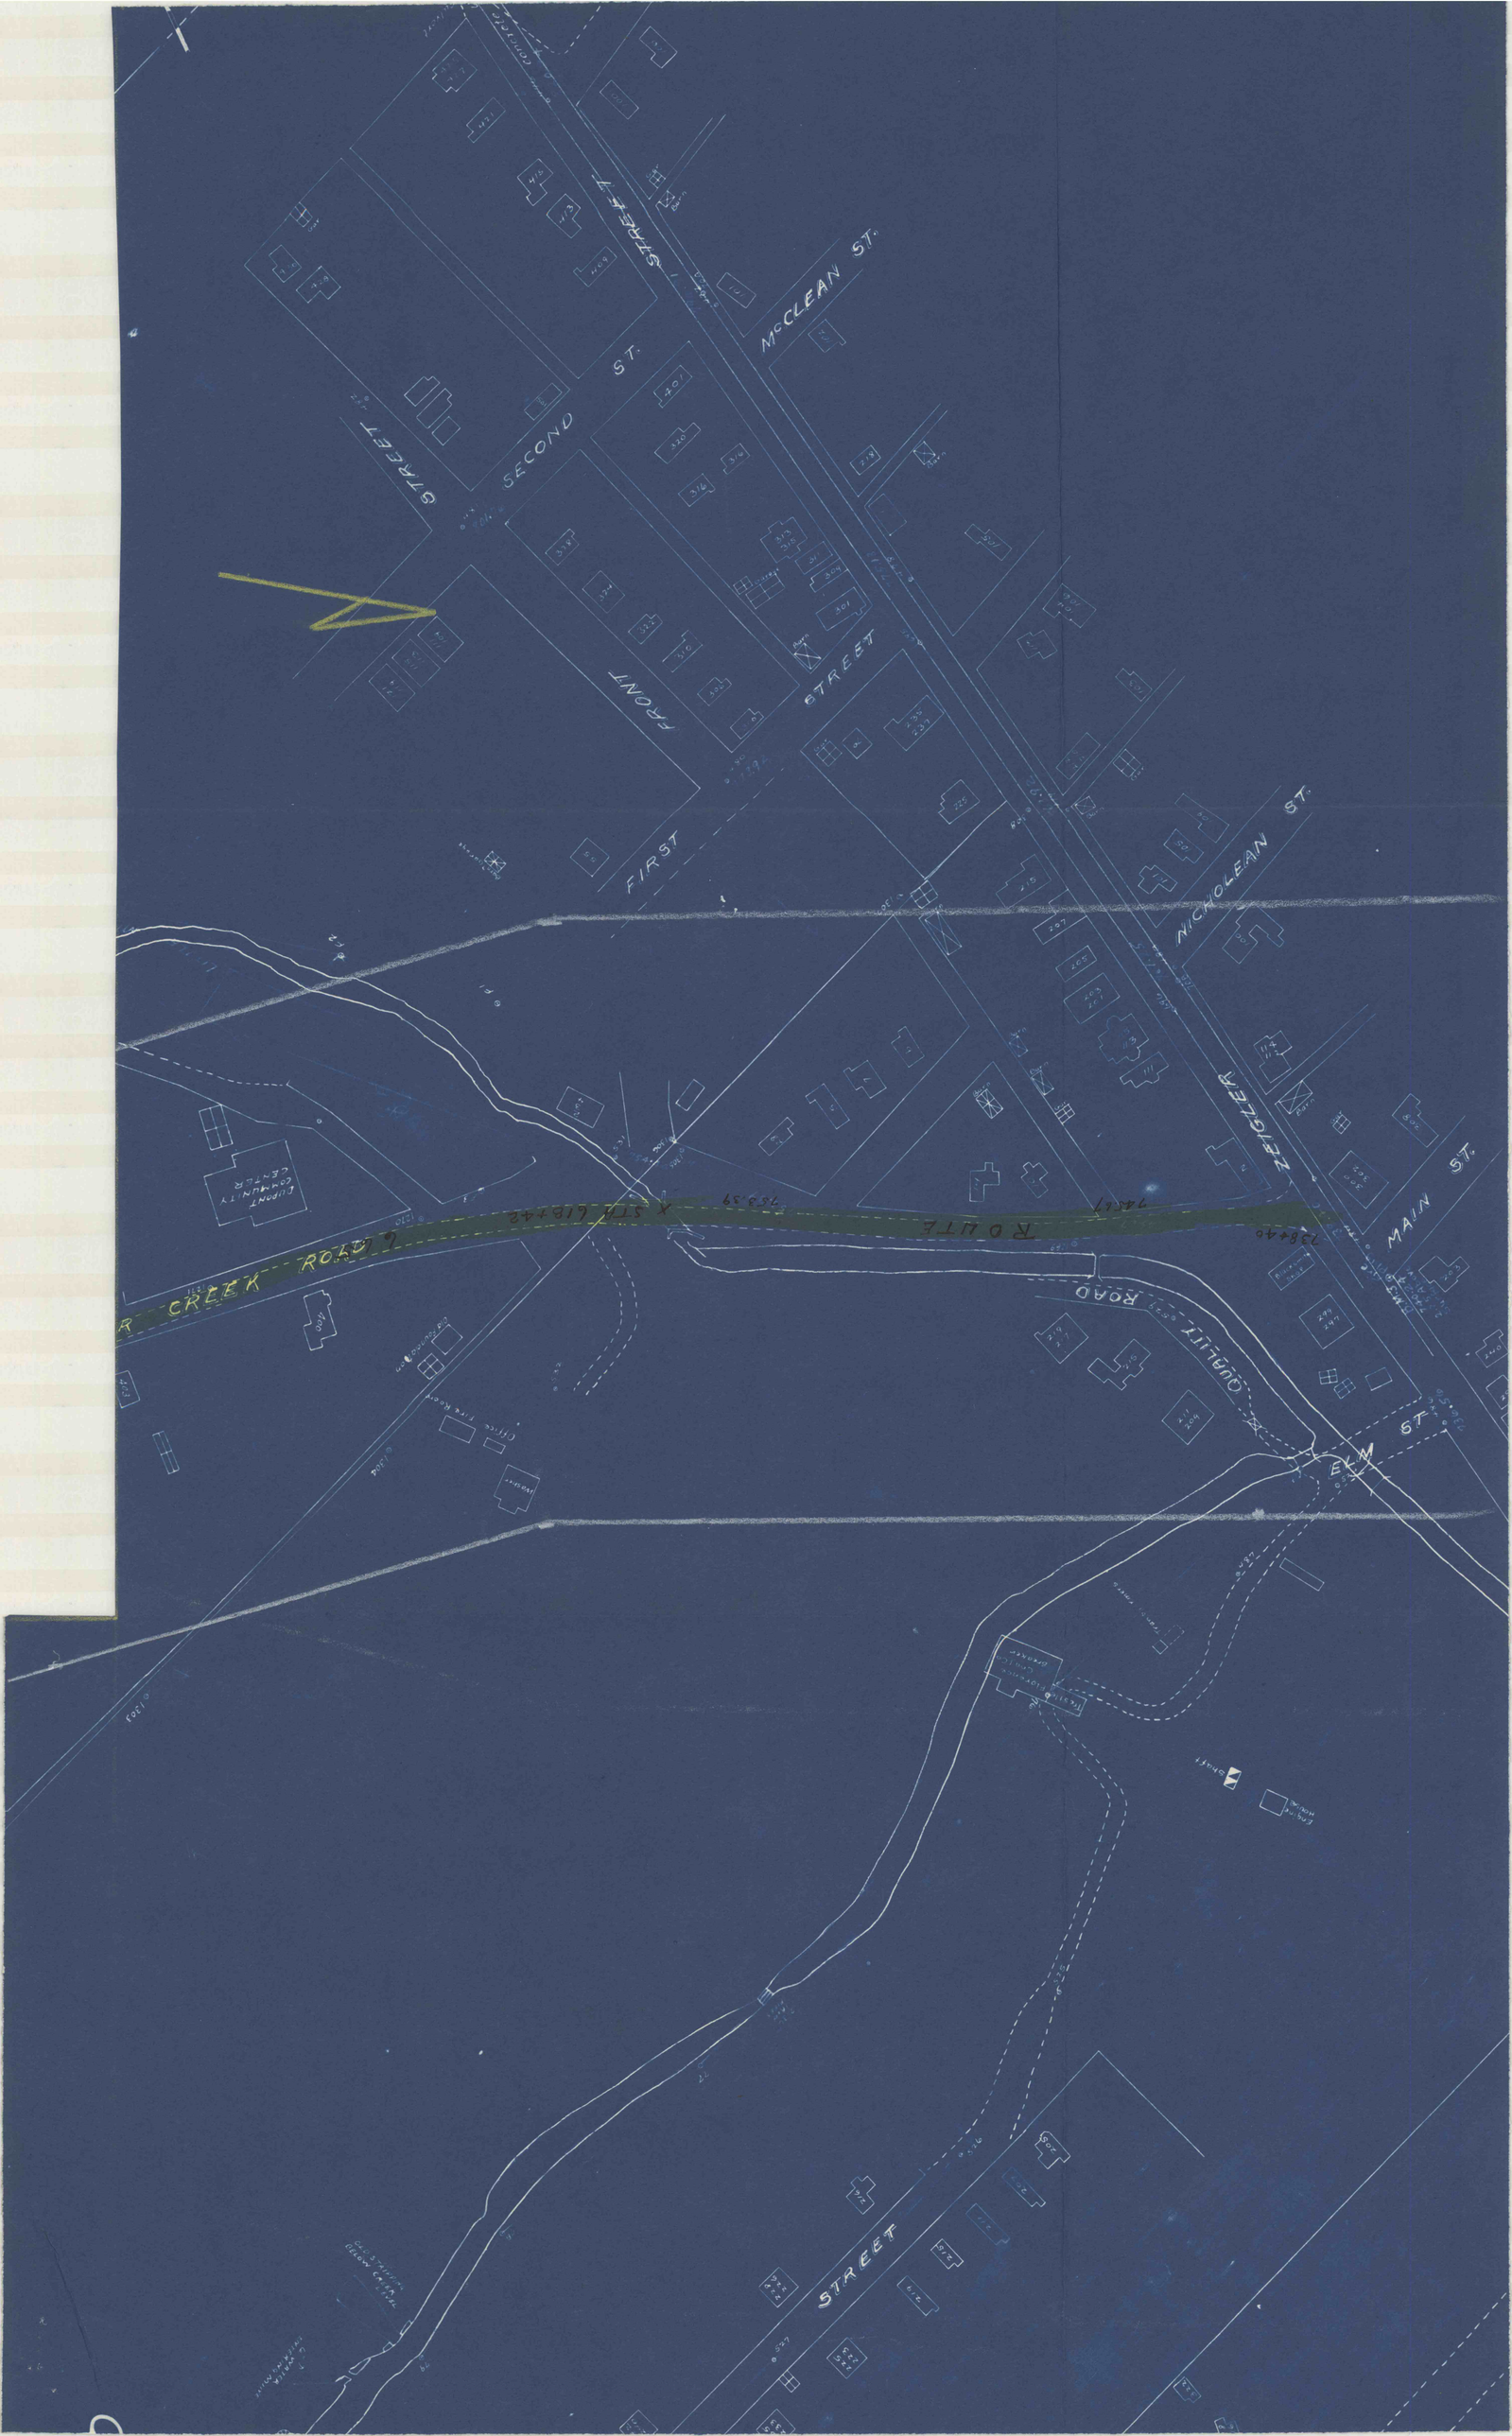

McCLEAN ST.
SECOND ST.
STREET
FRONT
STREET
FIRST
NICHOLEAN ST.
ZEIGLER
MAIN ST.
ROUTE
QUALITY ROAD
ELM ST.
CREEK ROAD
STREET