


5/2.

Batter these rows

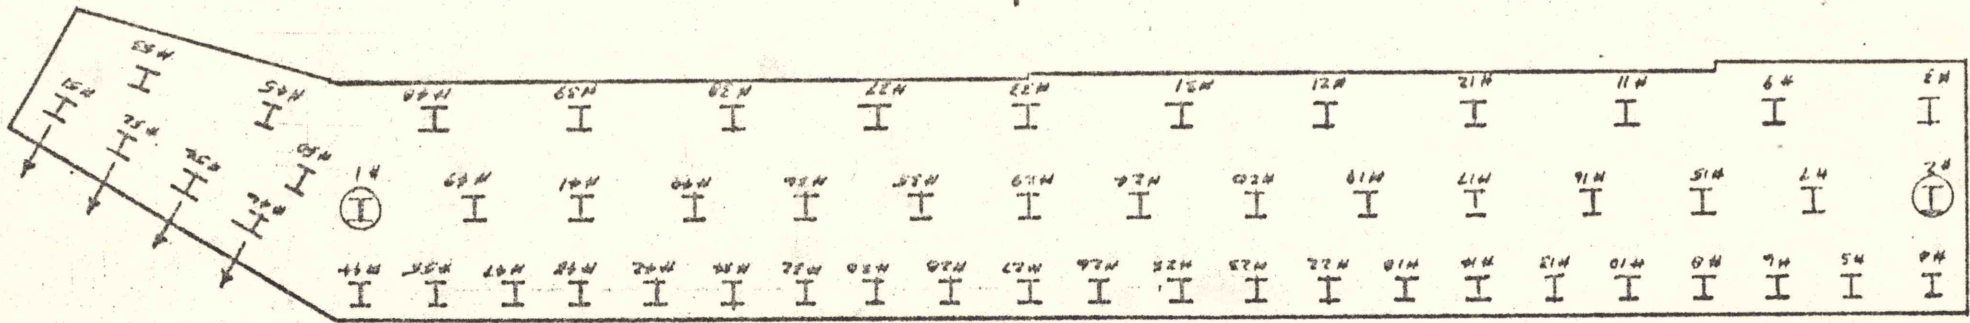

Sta 109+ Abut #1

⊙ Test Piles

I Batter Piles

