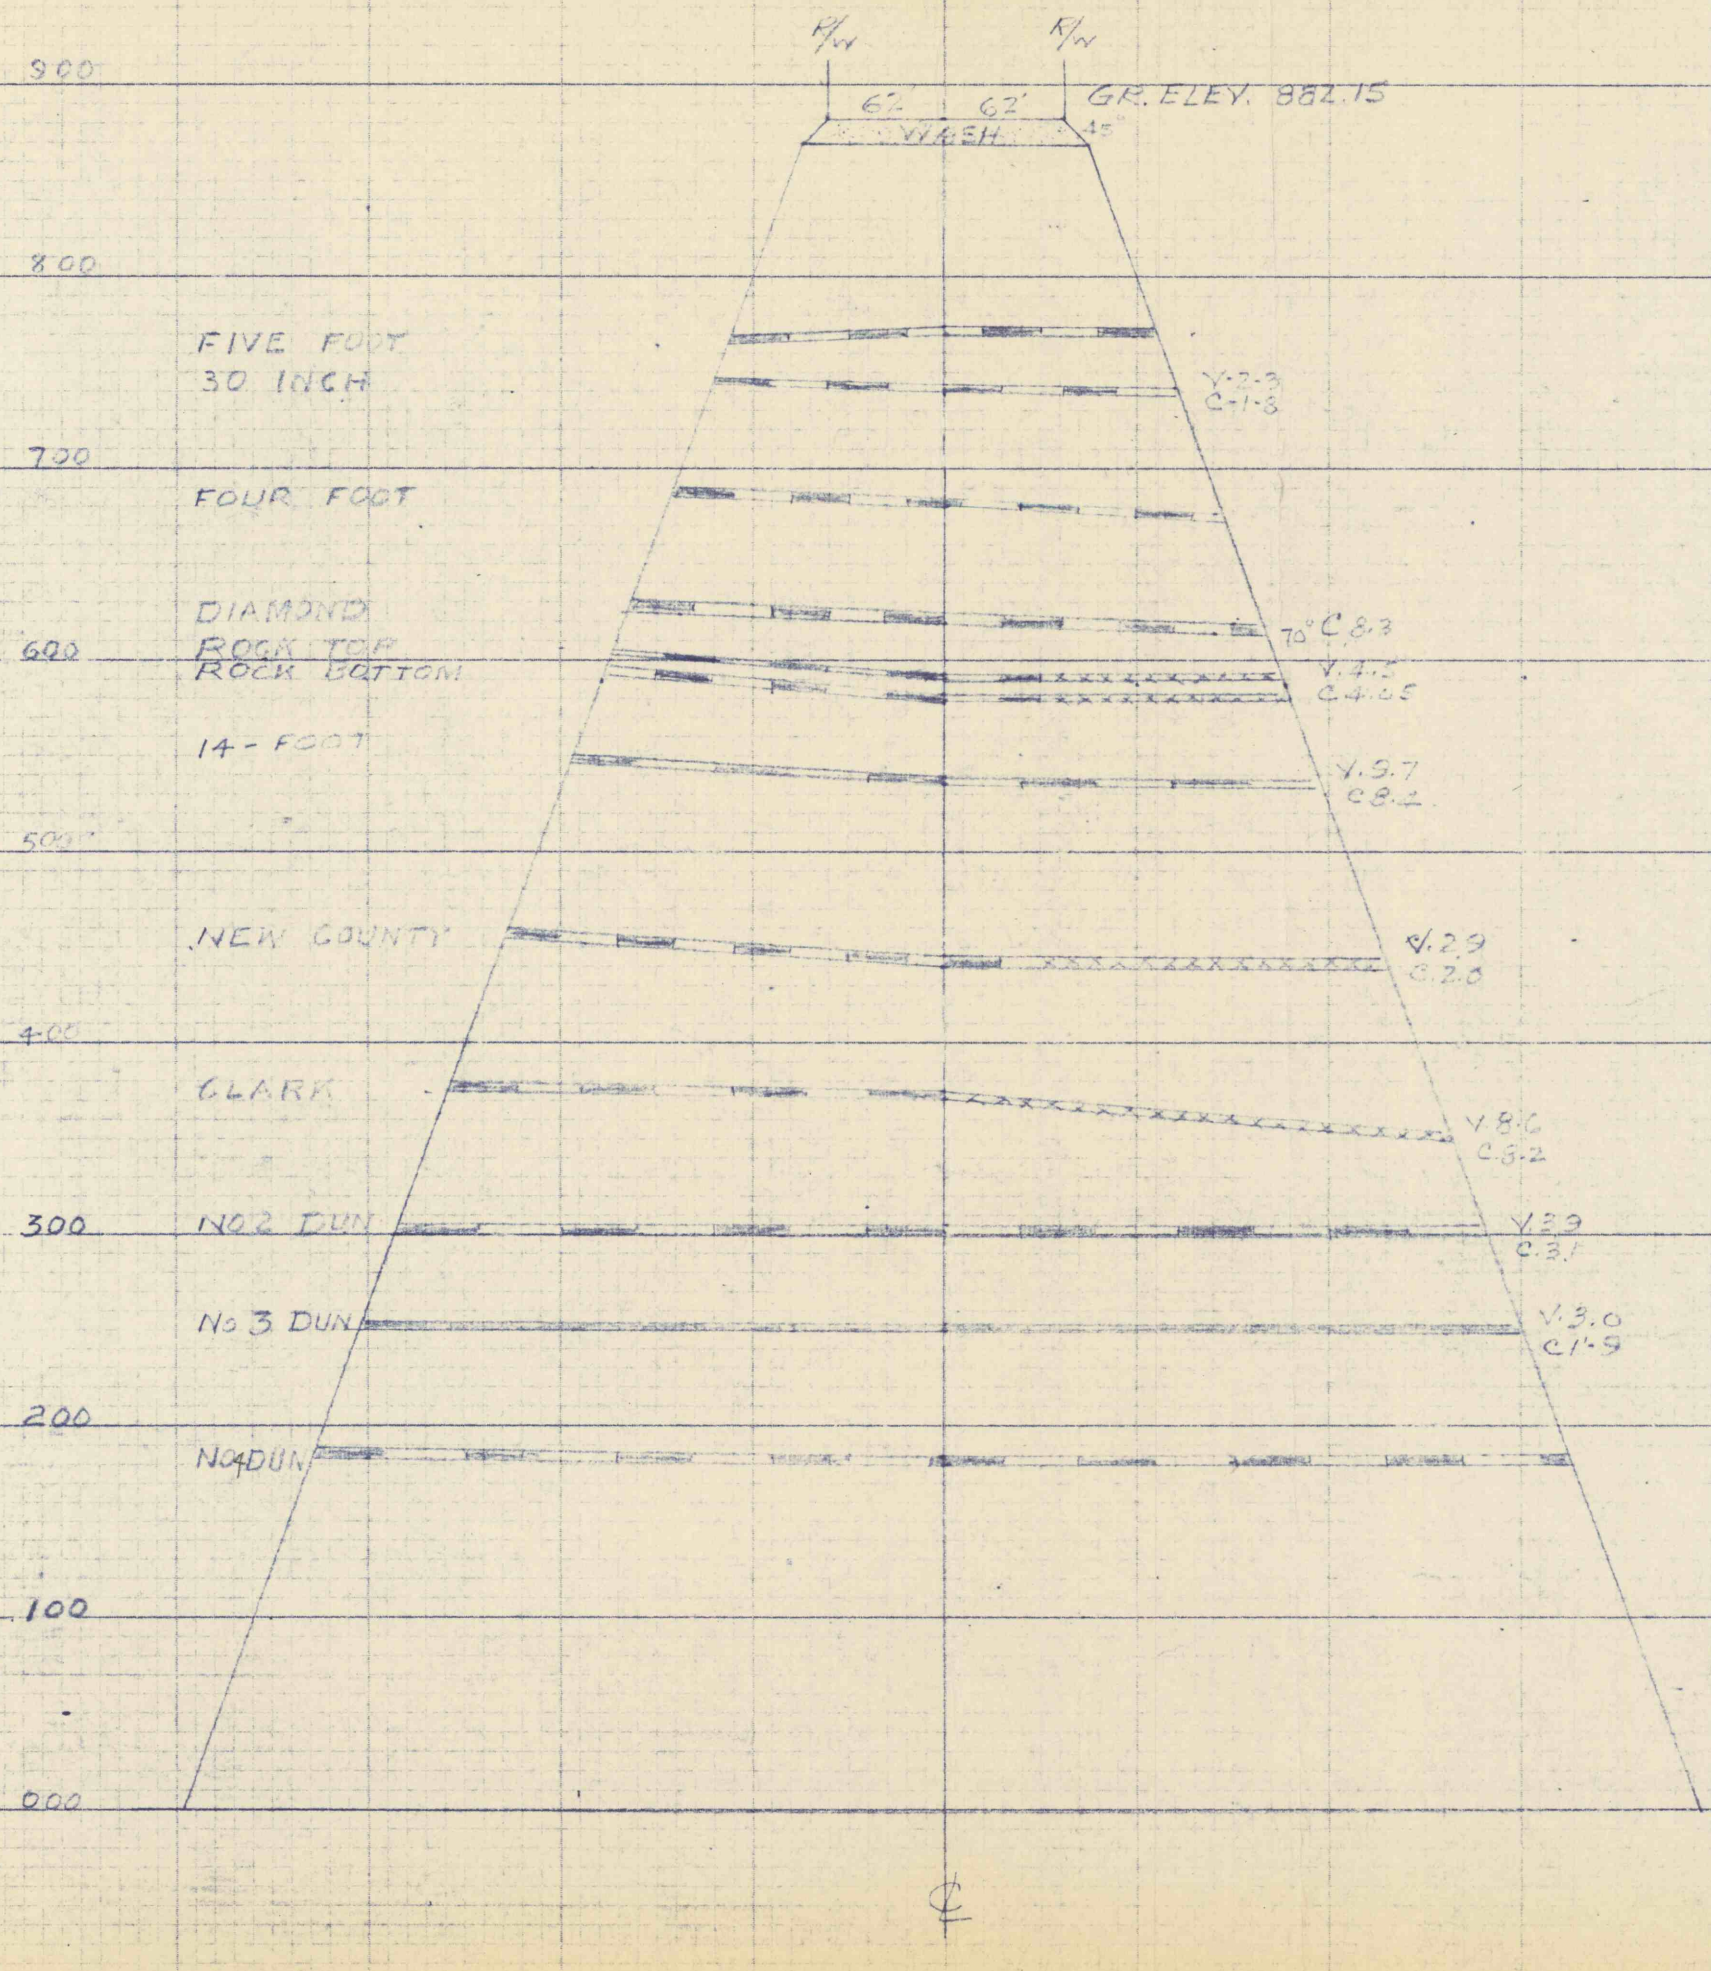

STA 140+00

L.R. 1013-1

CROSS-SECTION

SCALE 1" = 100'