


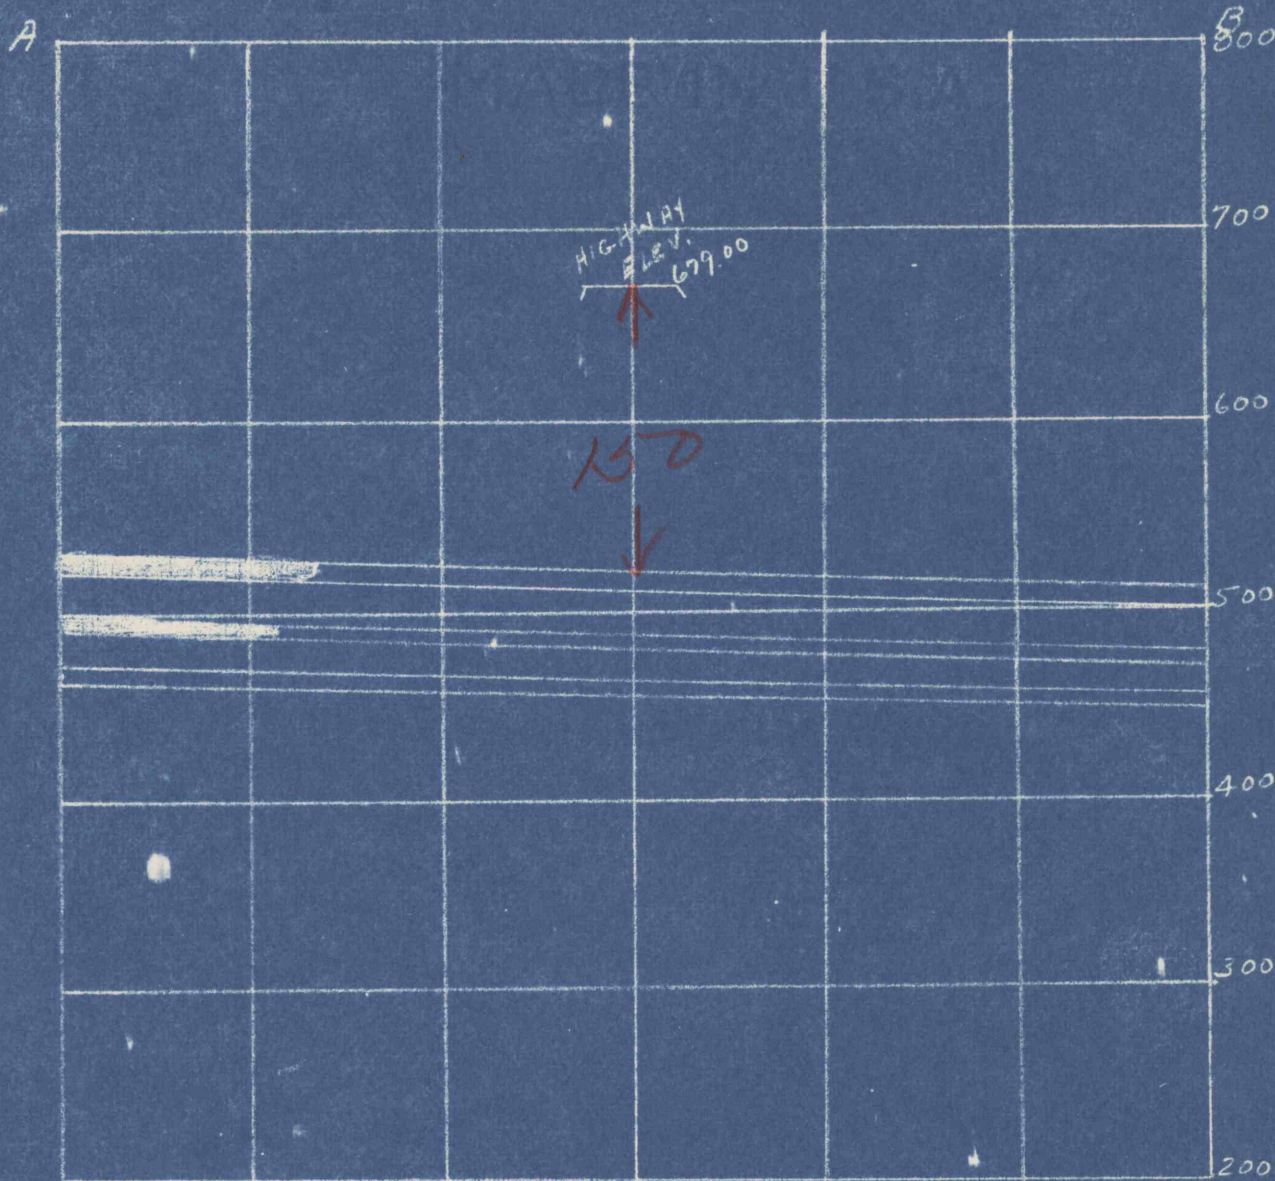

SECTION A-B



OLD FORGE COLLIERY
 No. 2 Sh.- Top, Mid. & Bot. Red
 Ash Veins
 Scale 1" - 100'
 Cross section of Top, Middle
 and Bottom Red Ash Veins under-
 lying Leg. Route #35049, Old
 Forge Boro., Lackawanna County.

 Virgin coal
 First mined