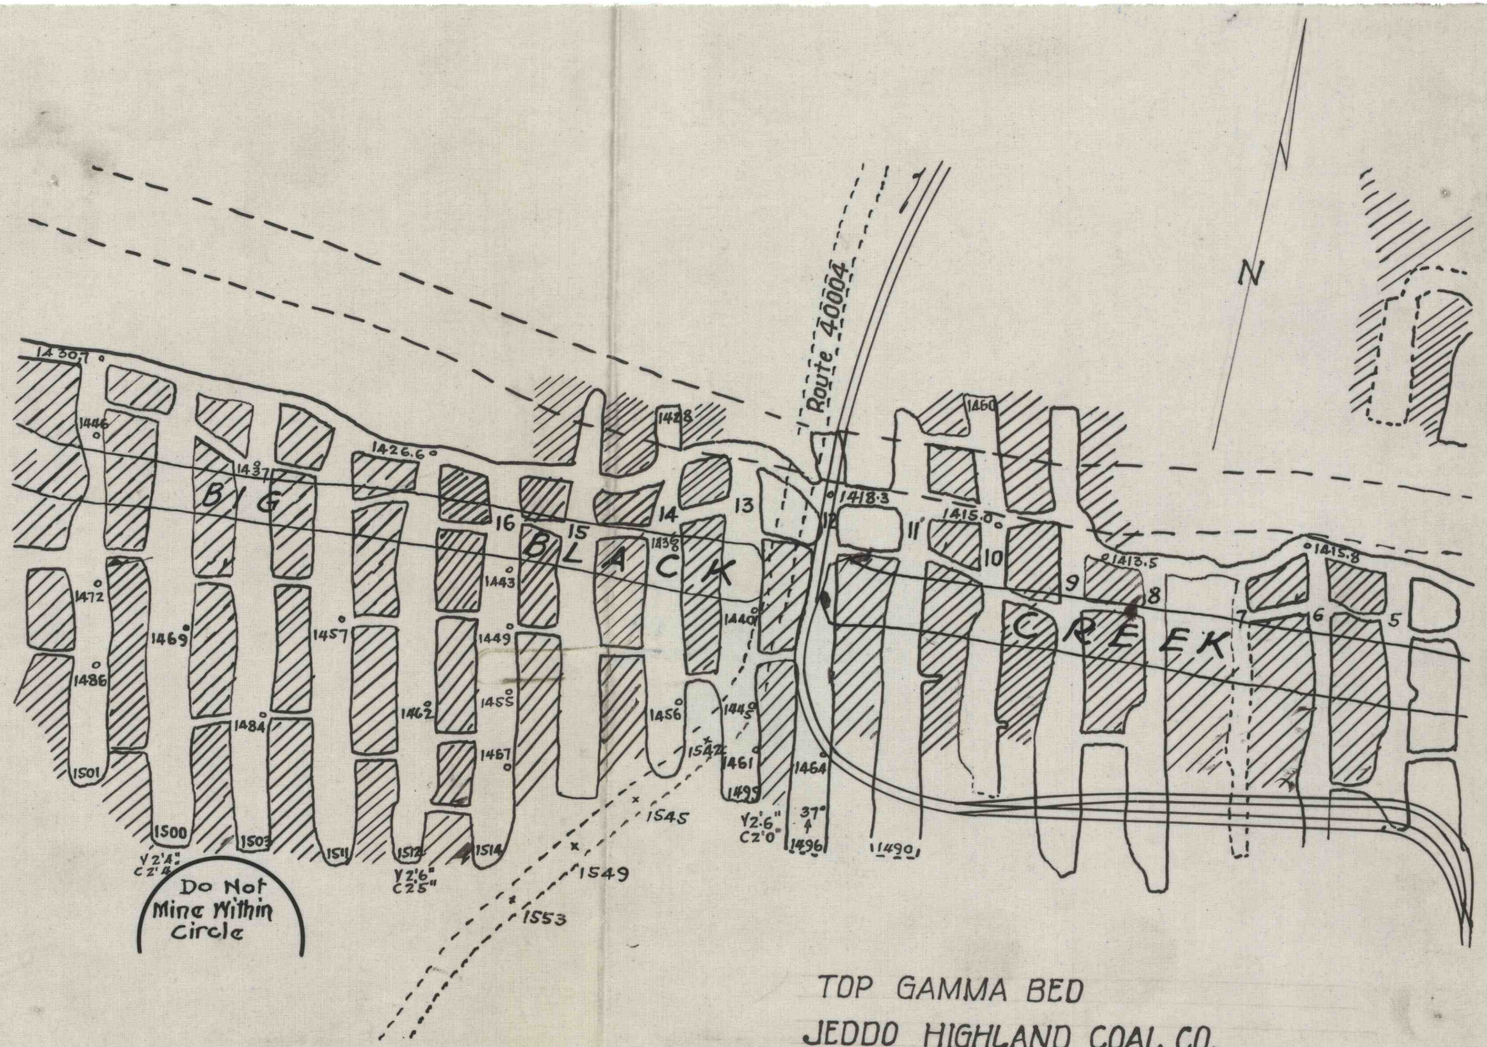

TOP GAMMA BED

JEDDO HIGHLAND COAL CO.

SCALE 1"=100' APR. 8, 1937.