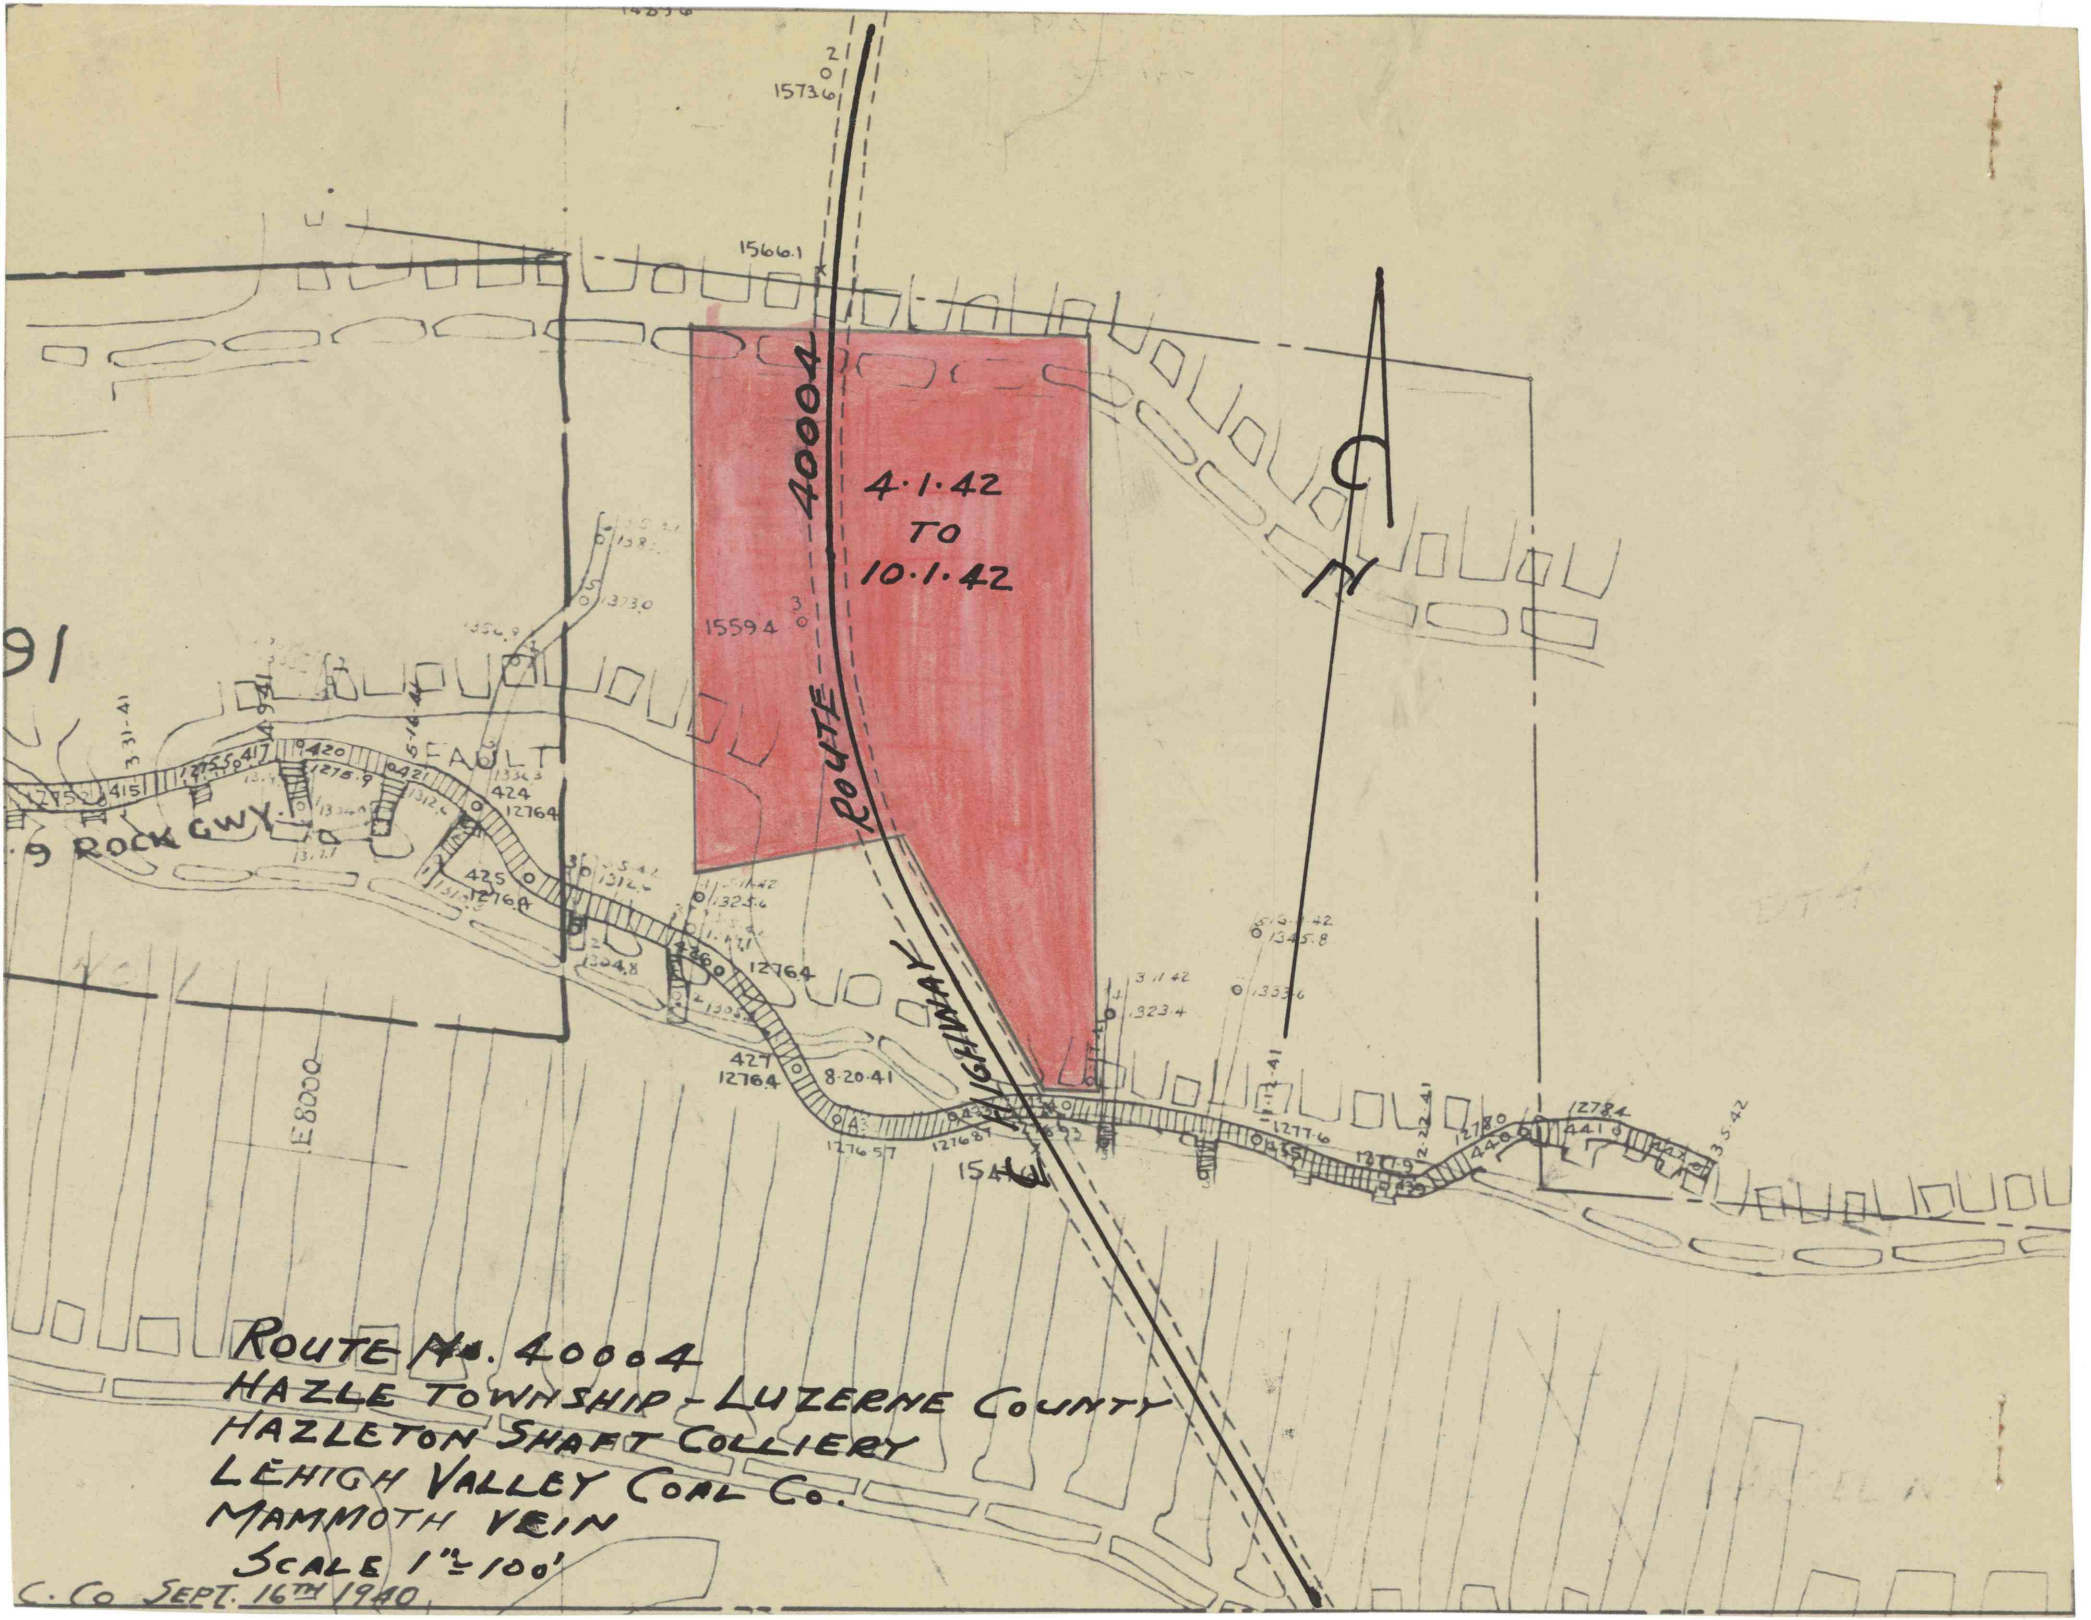

ROUTE No. 40004
HAZLE TOWNSHIP - LUZERNE COUNTY
HAZLETON SHAFT COLLIERY
LEHIGH VALLEY COAL CO.
MAMMOTH VEIN
SCALE 1" = 100'
C. Co SEPT. 16TH 1940
4·1·42
TO
10·1·42
ROUTE 40004
HIGHWAY
FAULT
ROCK GWY.
1566.1
1559.4
1573.6
1276.4
8·20·41
E8000